


24' T.O. 69' 9.25"  
 width 28'-0.00"  
 24' P.H. 57'-0.00' A.O.  
 width 28'-0.00'

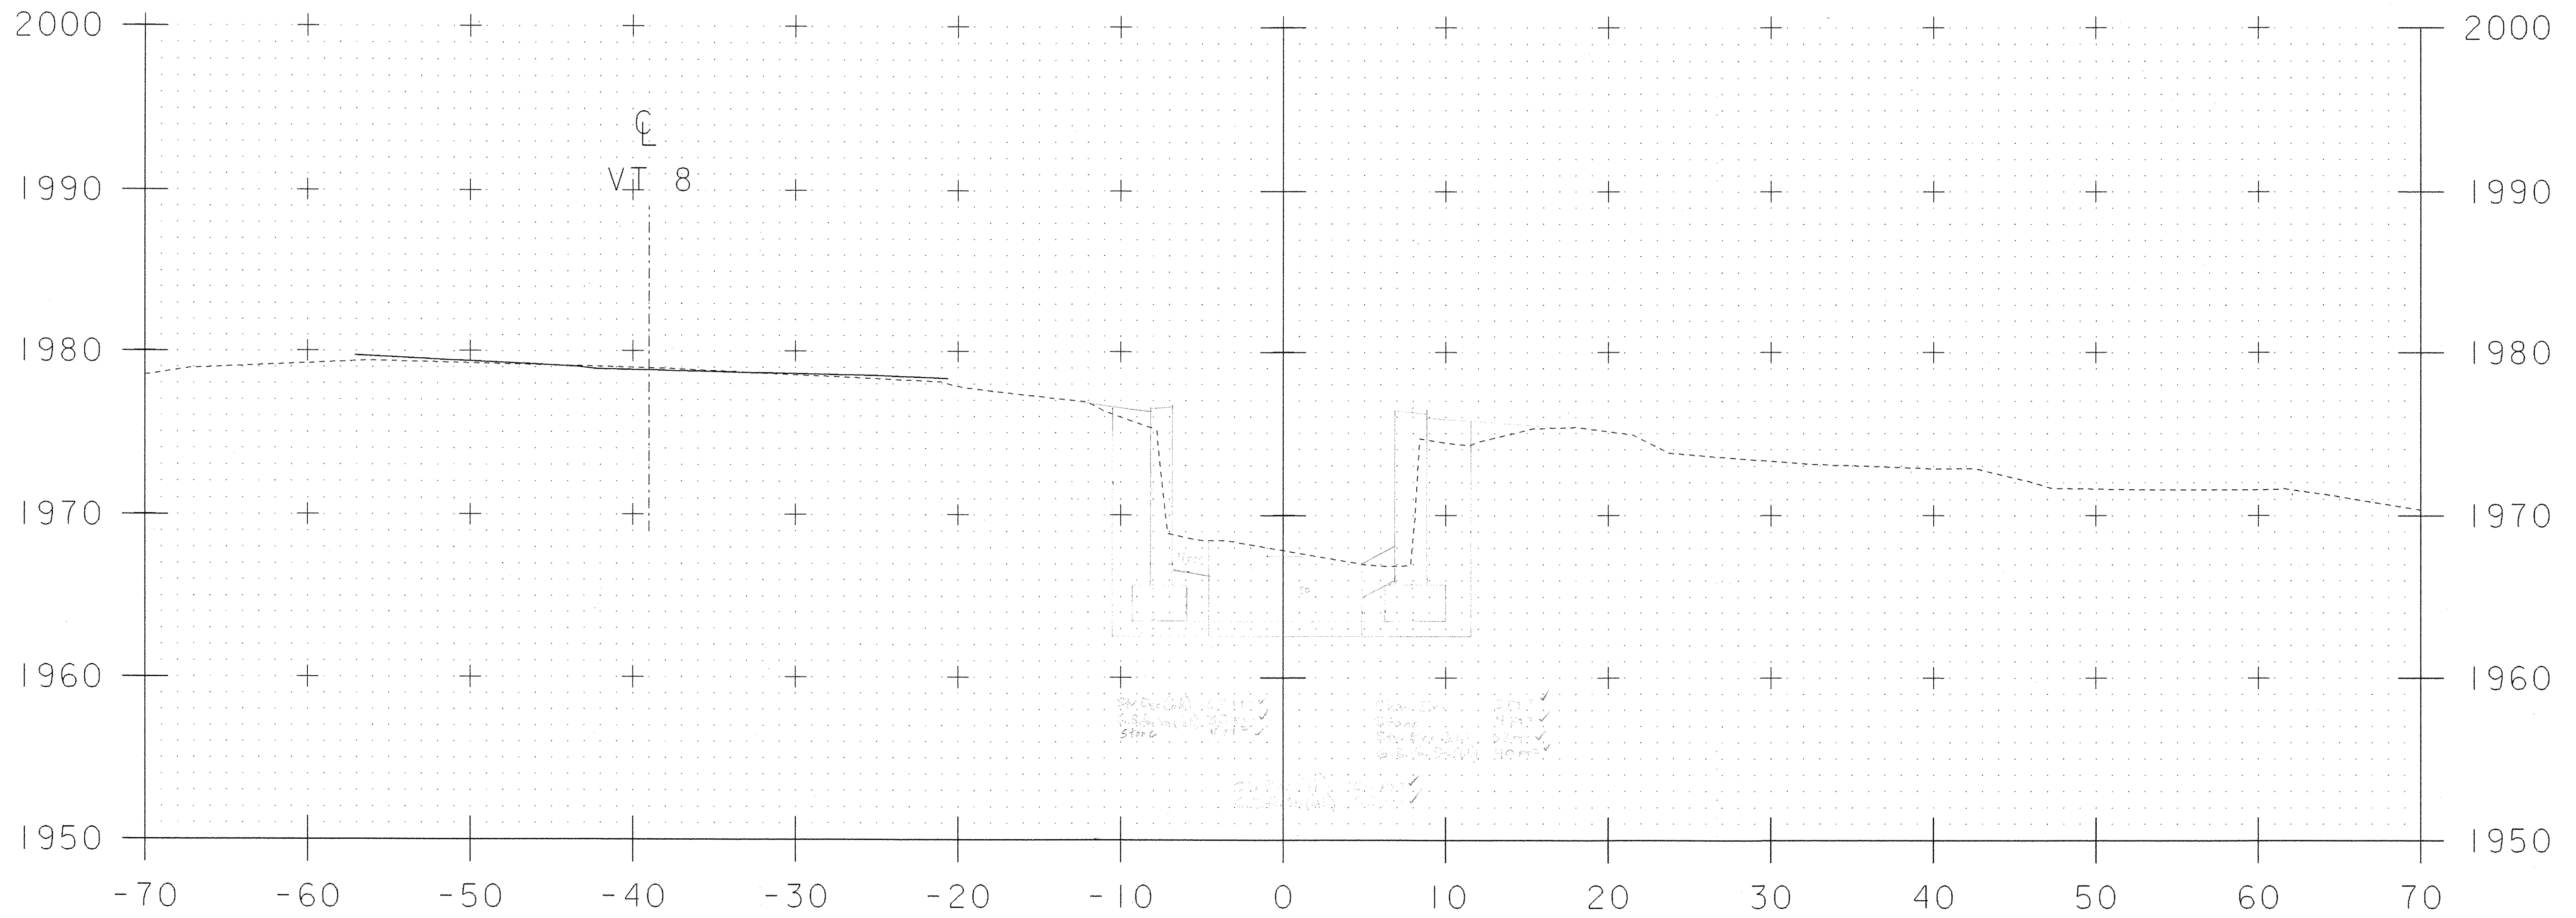

10+61

Sheet # 7 of 22

PROJECT: READSBORO	PROJECT NO.: ST CULV (4)
DESIGN FILE NAME: s04c176/structures/s04c176resident.dgn	PLOT DATE: 19-APR-2007
IPARM FILE NAME: s04c176res7.i	DESIGNED BY: E.L.RUSTAY
SQUAD LEADER: C.P.WILLIAMS	CHECKED BY:
RE CHAN STA. 10+61.00	SHEET: 27 OF 39

SCALE 1" = 5'-0"