



STATIONING PLAN

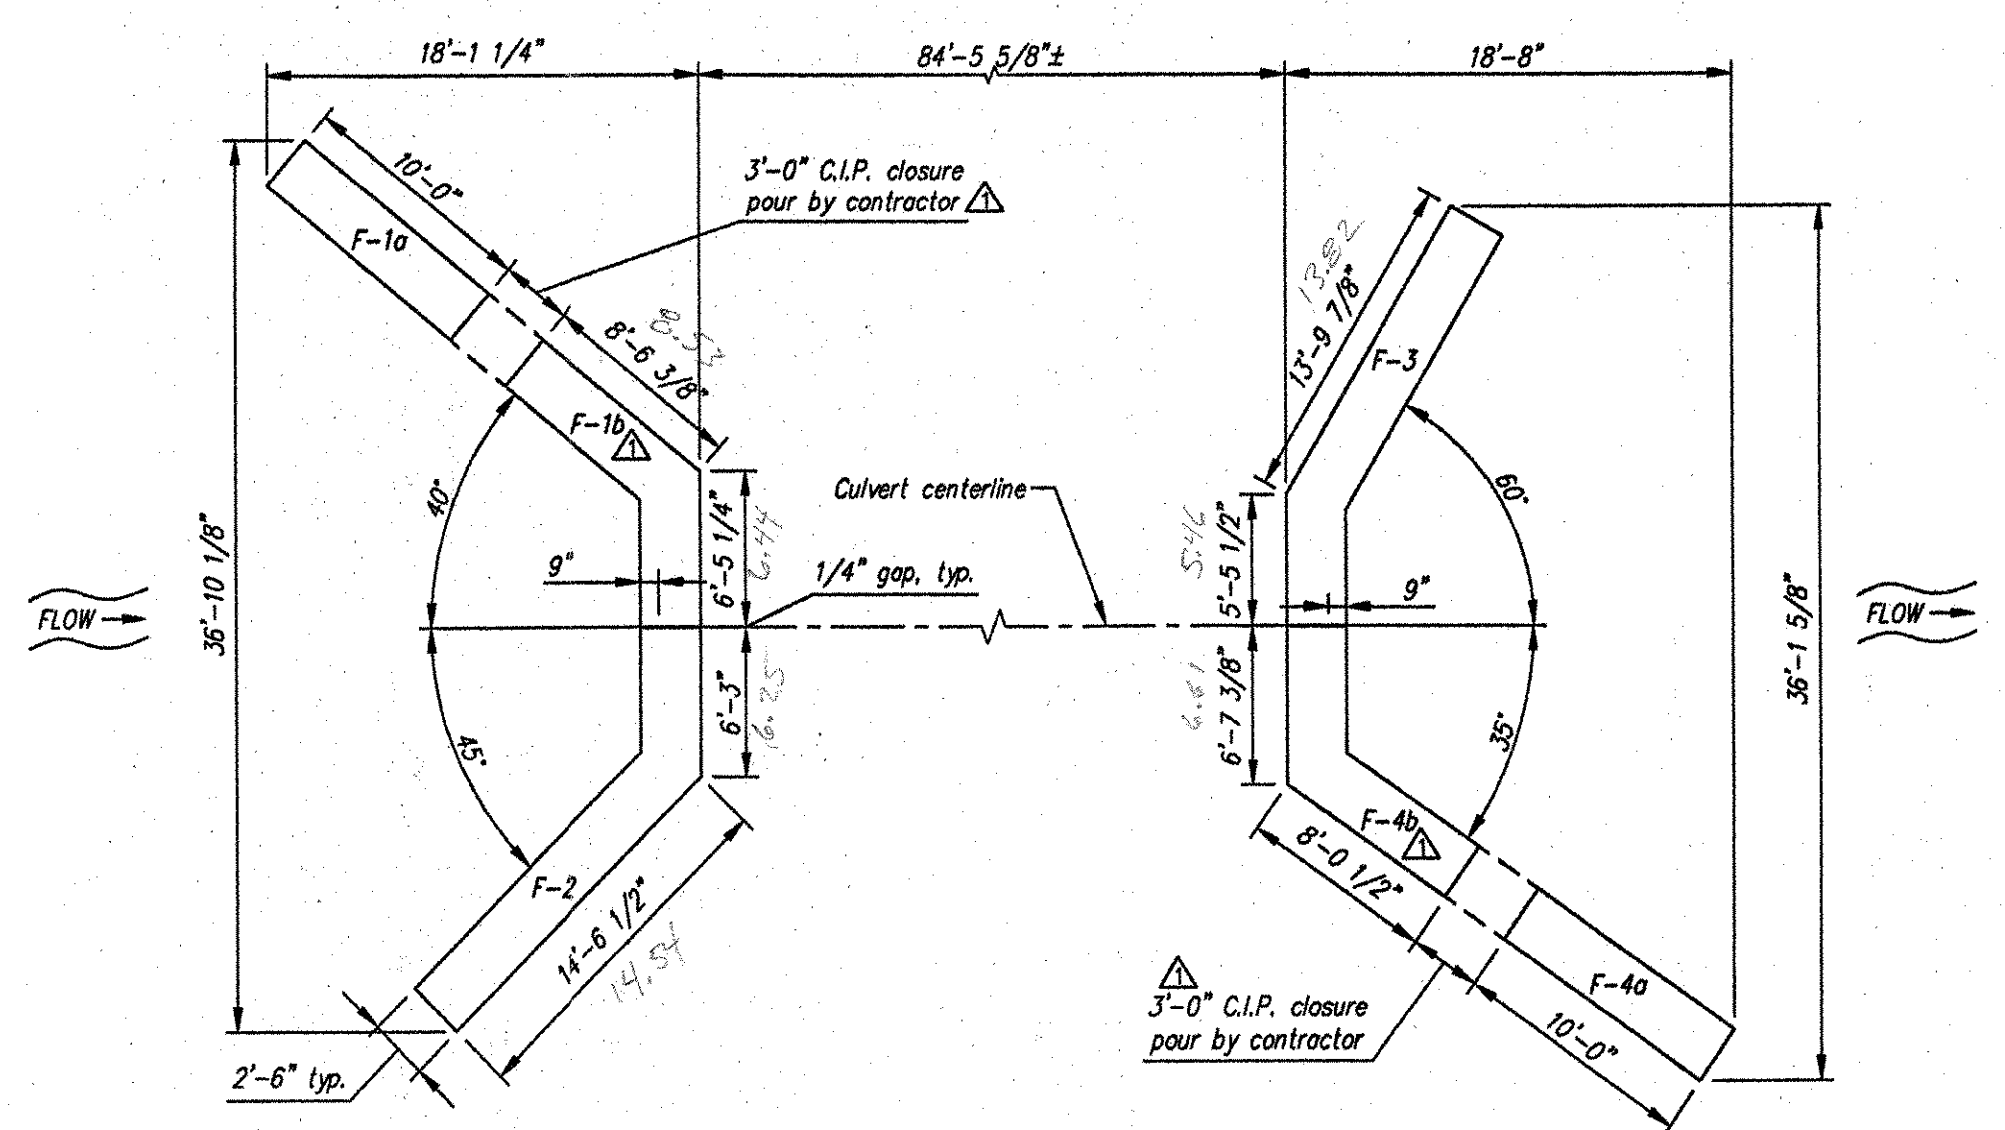

FOOTING PLAN

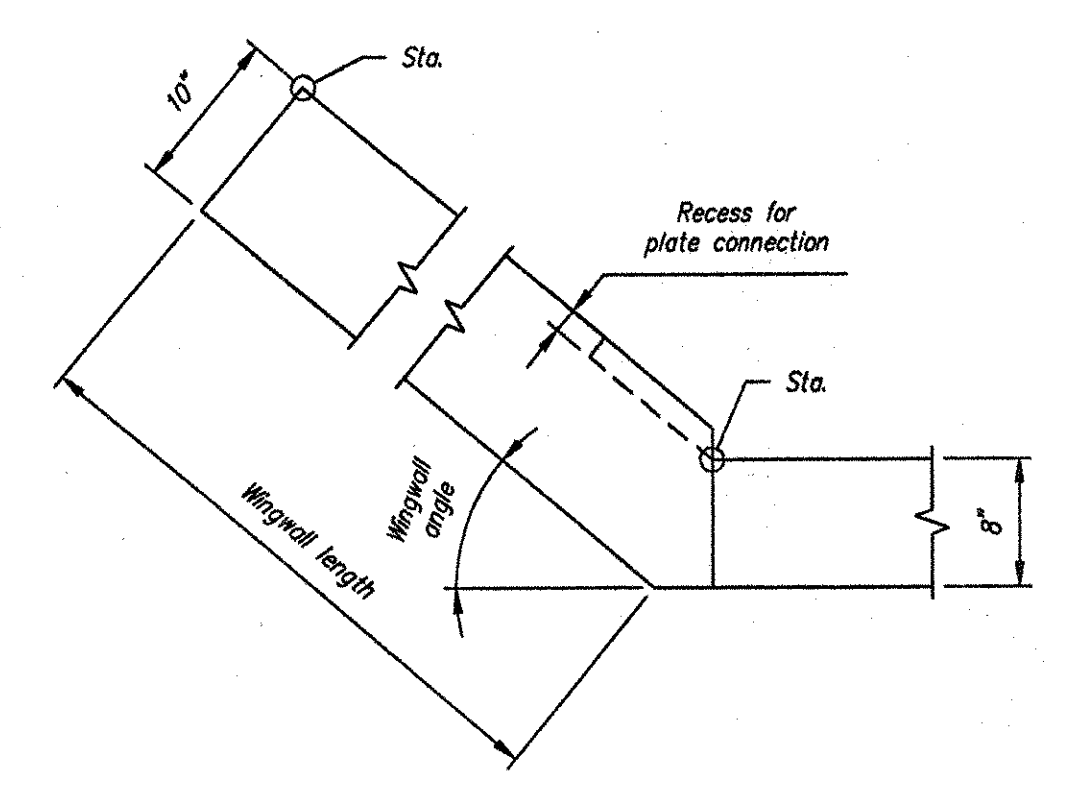


STATIONING LOCATION DETAIL

RECEIVED
 OK'D BY: *[Signature]* DATE: *12/12/06*
 DEC 05 2006
 RESUBMIT APPROVED
 BY: *apw* DATE: *12/12/06*

Contractor is to verify that all information shown on drawings has been thoroughly checked, complies with the contract documents and is adequate to meet the field conditions. Some dimensions and details may differ slightly from contract drawings to accommodate the manufacturing or design process. Approval of this drawing indicates that any deviation from the contract documents has been reviewed and found to be acceptable. Production will not commence until receipt of signed, approved shop drawings.

This drawing contains information proprietary to CONCRETE SYSTEMS, INC. This drawing is disclosed with the understanding that it will be retained in confidence and its use limited solely to the purpose for which it is disclosed. It is understood that no reproduction of this drawing is authorized without permission from CONCRETE SYSTEMS, INC. and that it will be returned to CONCRETE SYSTEMS, INC. upon request.

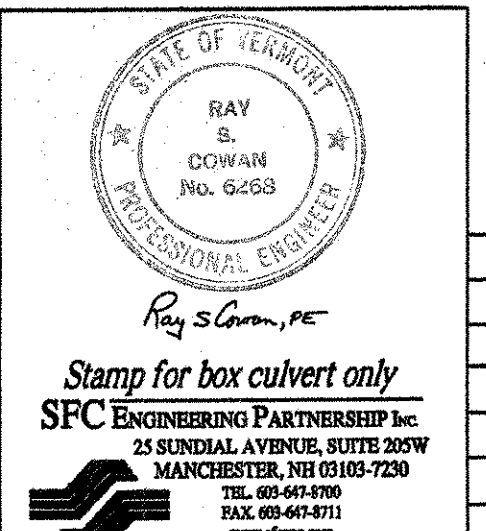

Rev.	Date	DESCRIPTION	By
5			
4			
3			
2			
1	11/21/06	Added dimensions to wingwall stations and C.I.P. curb; Revised Footing Plan	MS

This drawing is based upon information provided from the following documents and/or sources:

Engineer: VAOT
 Project No: ST CULV (4)
 Drawings: PROPOSED IMPROVEMENT BRIDGE PROJECT - VT RTE 8, RURAL MAJOR COLLECTOR
 Sheets 1 through 39 of 39 sheets
 Specifications: Readsboro AC STP ST CULV (4) - Special Provisions
 Supplemental Specifications - Schedule of Prices

Other Sources:



Drawn by	Date
M. SCOTT	10/02/2006
Checked by	Date
TK/TR	10/03/2006
Approved by	Date

STATE AGENCY: VAOT

PIKE INDUSTRIES
 VT RTE 8, RURAL MAJOR COLLECTOR
 READSBORO, VT

STATIONING AND FOOTING PLAN - BRIDGE NO. 02
 Drawing No. C18331-L01-2

Quantity: 1 Project No: AC STP ST CULV (4) SHEET 2 OF 3