


SEE SHEET 2 FOR INDEX OF SHEETS
AND LIST OF STANDARDS.

STATE OF VERMONT AGENCY OF TRANSPORTATION



PROPOSED IMPROVEMENT BRIDGE PROJECT TOWN OF SPRINGFIELD COUNTY OF WINDSOR

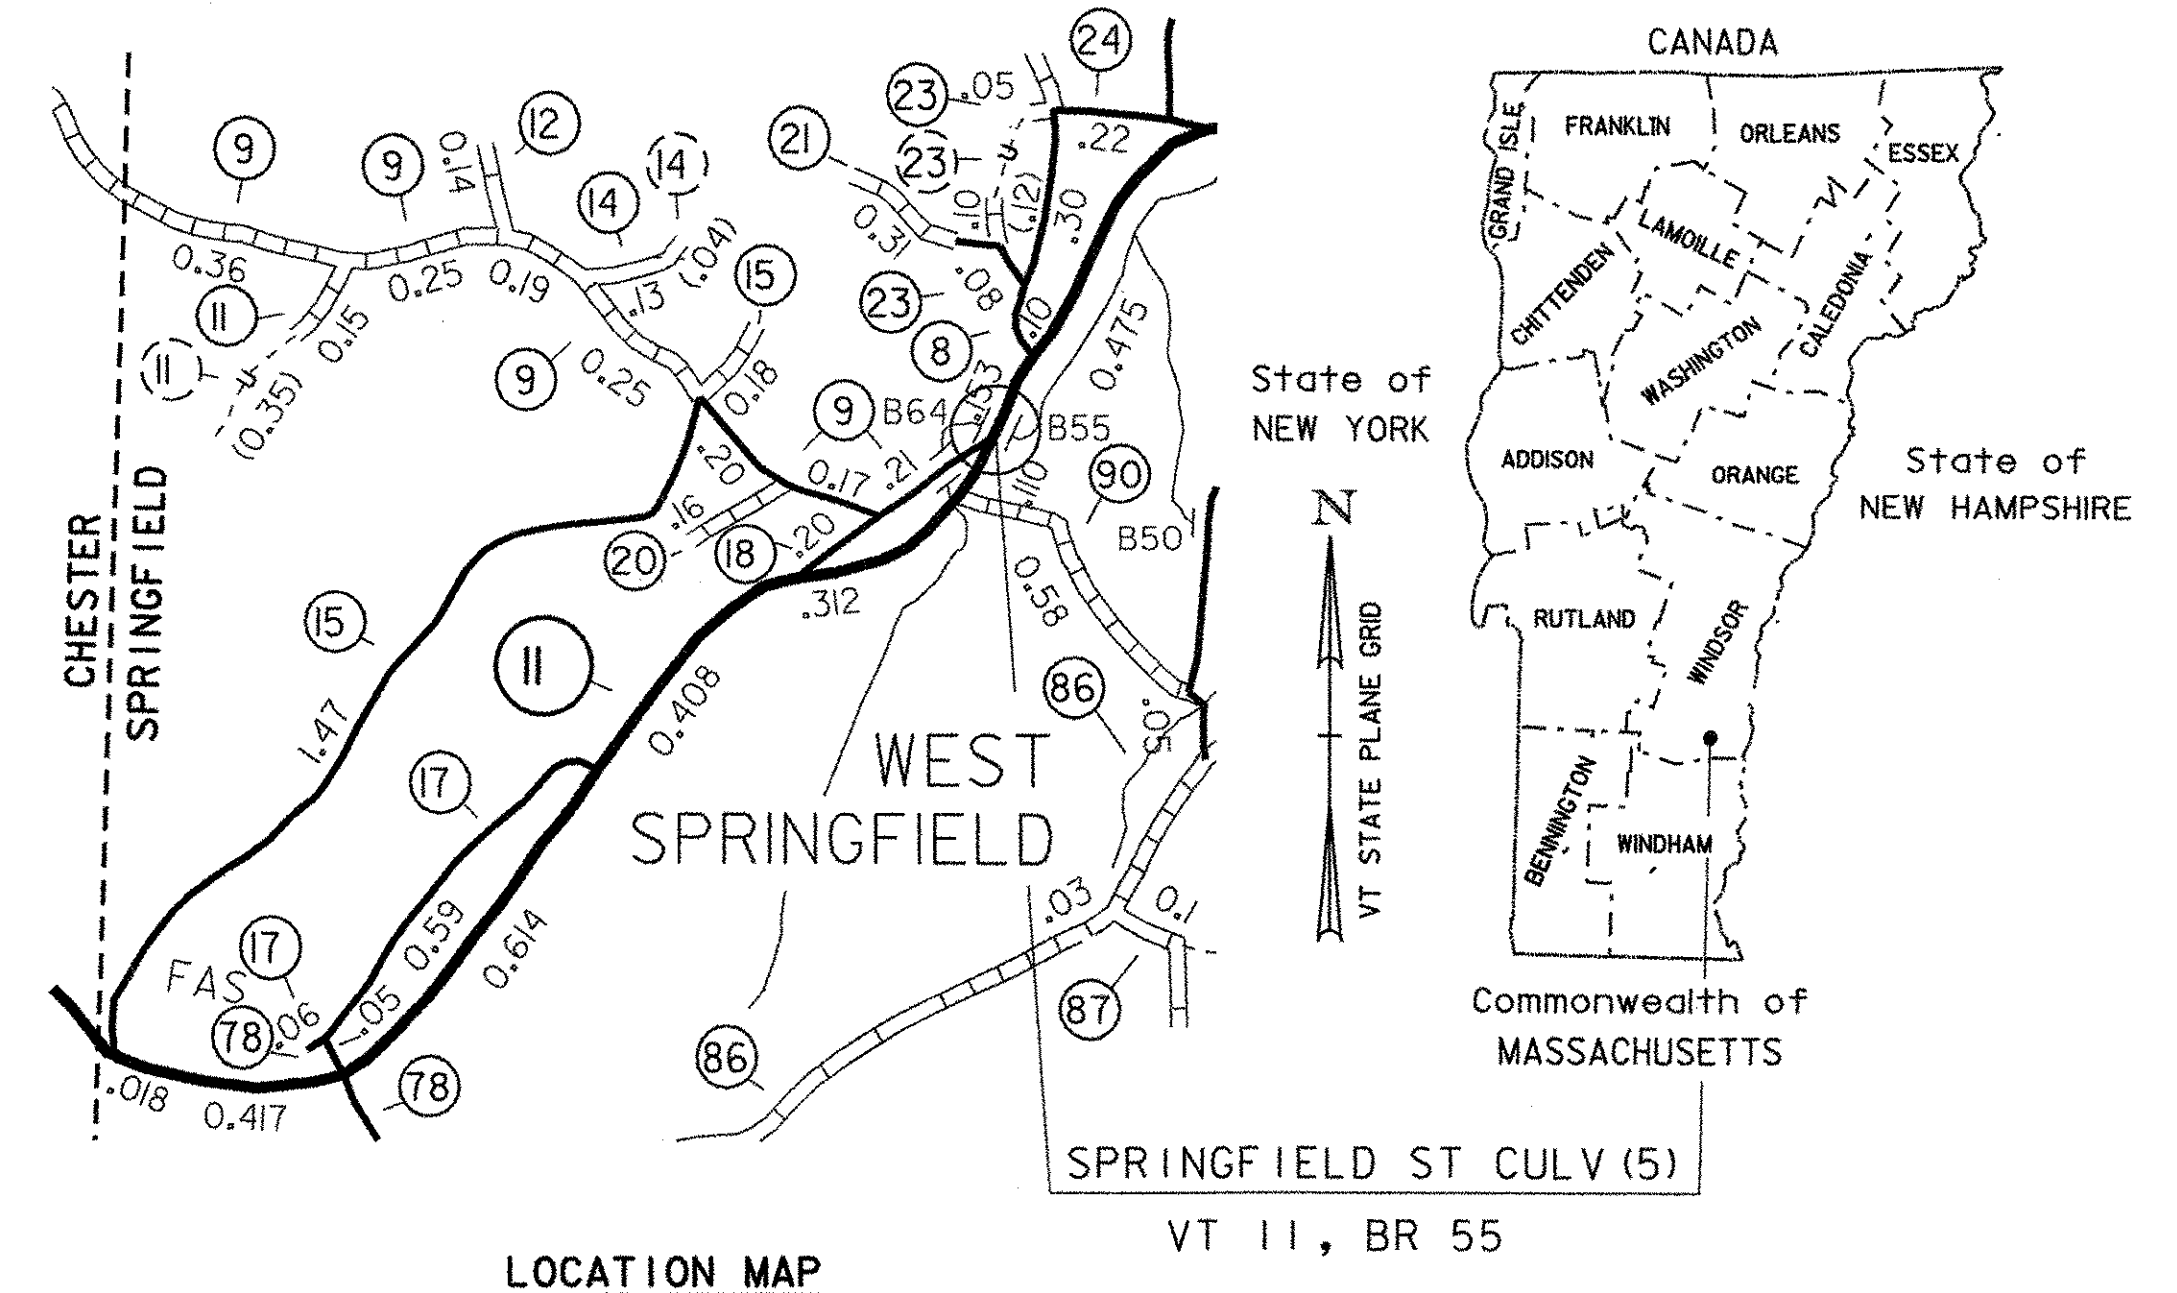


RECORD PLANS	
CONTRACTOR:	J.A.MCDONALD INC. -LYNDONVILLE CTR VT
RESIDENT ENGINEER:	JEREMY REED
CONSTRUCTION BEGAN:	JULY 12, 2007
CONSTRUCTION COMPLETE:	NOVEMBER 9, 2007
RECORD PLANS BY:	Jeremy Reed
I HEREBY CERTIFY THAT ALL THE CONSTRUCTION REQUIRED BY THIS SET OF DRAWINGS HAS BEEN ACCOMPLISHED AS INDICATED HEREIN.	
BY	<i>Jeremy Reed</i> RESIDENT ENGINEER
DATE	February 26, 2008
NOTE: Any further information concerning final quantities, amounts or other details relative to this project may be found at Central Files in the electronic archives.	

ROUTE NO: VT 11 MAJOR COLLECTOR BRIDGE NO: 55

PROJECT LOCATION : BEGINNING AT A POINT IN THE TOWN OF SPRINGFIELD ALONG VT. RTE. 11 APPROXIMATELY 1.9 MILES EASTERLY FROM THE CHESTER-SPRINGFIELD TOWN LINE.

PROJECT DESCRIPTION : REPLACEMENT OF EXISTING METAL CULVERT WITH A BURIED CONCRETE STRUCTURE INCLUDING RELATED APPROACH ROADWAY AND CHANNEL WORK.


LENGTH OF STRUCTURE : 58.00 FEET
LENGTH OF ROADWAY : 142.00 FEET
LENGTH OF PROJECT : 200.00 FEET

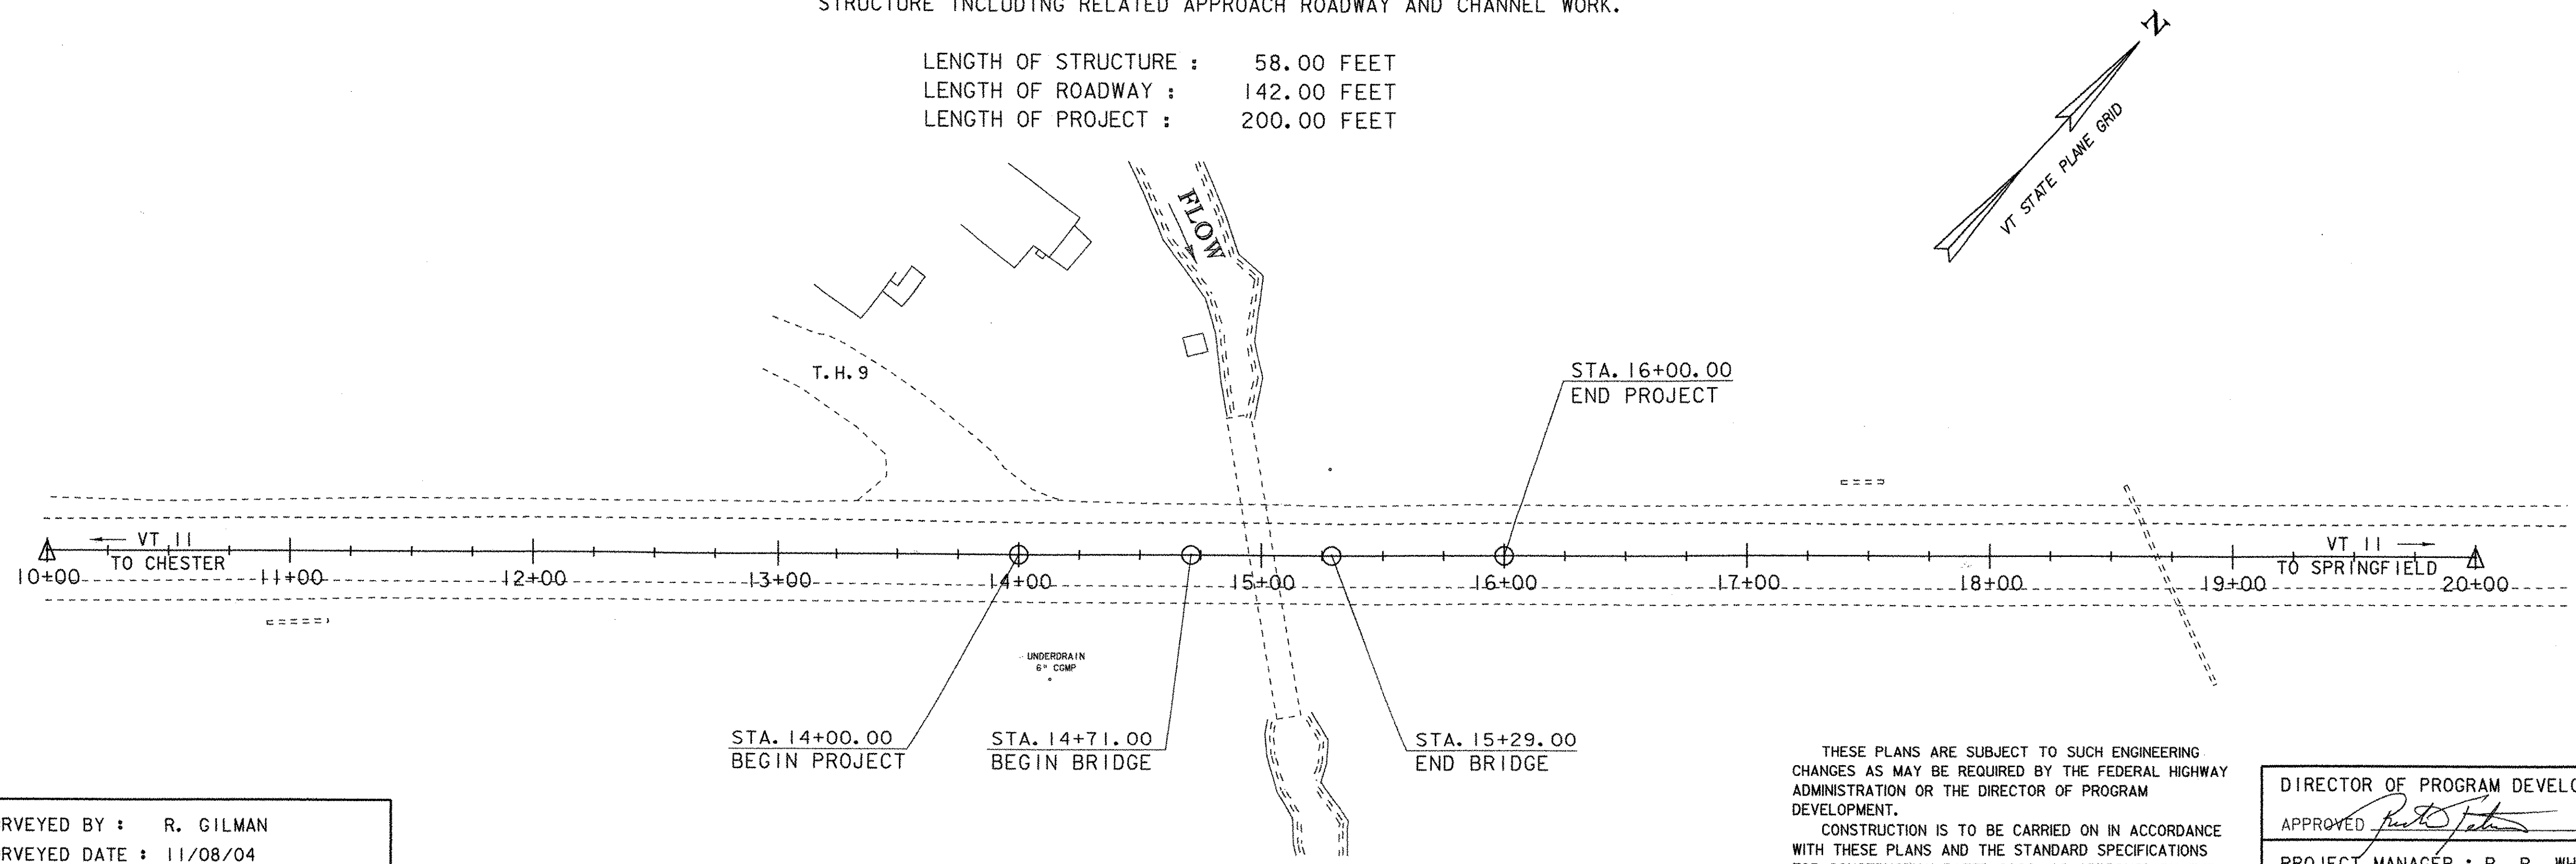

CONVENTIONAL SYMBOLS	
COUNTY LINE	
TOWN LINE	
LIMITS OF ACCESS	
POINT OF ACCESS	
FENCE LINE	
STONE WALL	
TRAVELED WAY	
GUARD RAIL	
RAILROAD	
SURVEY LINE	
CULVERT	
POWER POLE	
TELEPHONE POLE	
TREES	
CONTROL OF ACCESS	
PROPERTY LINE	
R.O.W. TAKING LINE	
SLOPE RIGHTS	
TOP OF CUT	
TOE OF SLOPE	

SURVEYED BY : R. GILMAN
SURVEYED DATE : 11/08/04

DATUM
VERTICAL NAVD 88
HORIZONTAL NAD 83

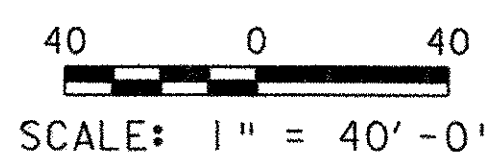

THESE PLANS ARE SUBJECT TO SUCH ENGINEERING CHANGES AS MAY BE REQUIRED BY THE FEDERAL HIGHWAY ADMINISTRATION OR THE DIRECTOR OF PROGRAM DEVELOPMENT.
CONSTRUCTION IS TO BE CARRIED ON IN ACCORDANCE WITH THESE PLANS AND THE STANDARD SPECIFICATIONS FOR CONSTRUCTION DATED 2006, AS APPROVED BY THE FEDERAL HIGHWAY ADMINISTRATION ON JUNE 15, 2006 FOR USE ON THIS PROJECT, INCLUDING ALL SUBSEQUENT REVISIONS AND SUCH REVISED SPECIFICATIONS AND SPECIAL PROVISIONS AS ARE INCORPORATED IN THESE PLANS.

DIRECTOR OF PROGRAM DEVELOPMENT	
APPROVED <i>[Signature]</i>	DATE 1-25-07
PROJECT MANAGER : R. R. WHITCOMB	
PROJECT NAME : SPRINGFIELD	
PROJECT NUMBER : ST CULV (5)	
SHEET 1 OF 52 SHEETS	