



PROFILE ALONG PROPOSED CENTERLINE VT 11

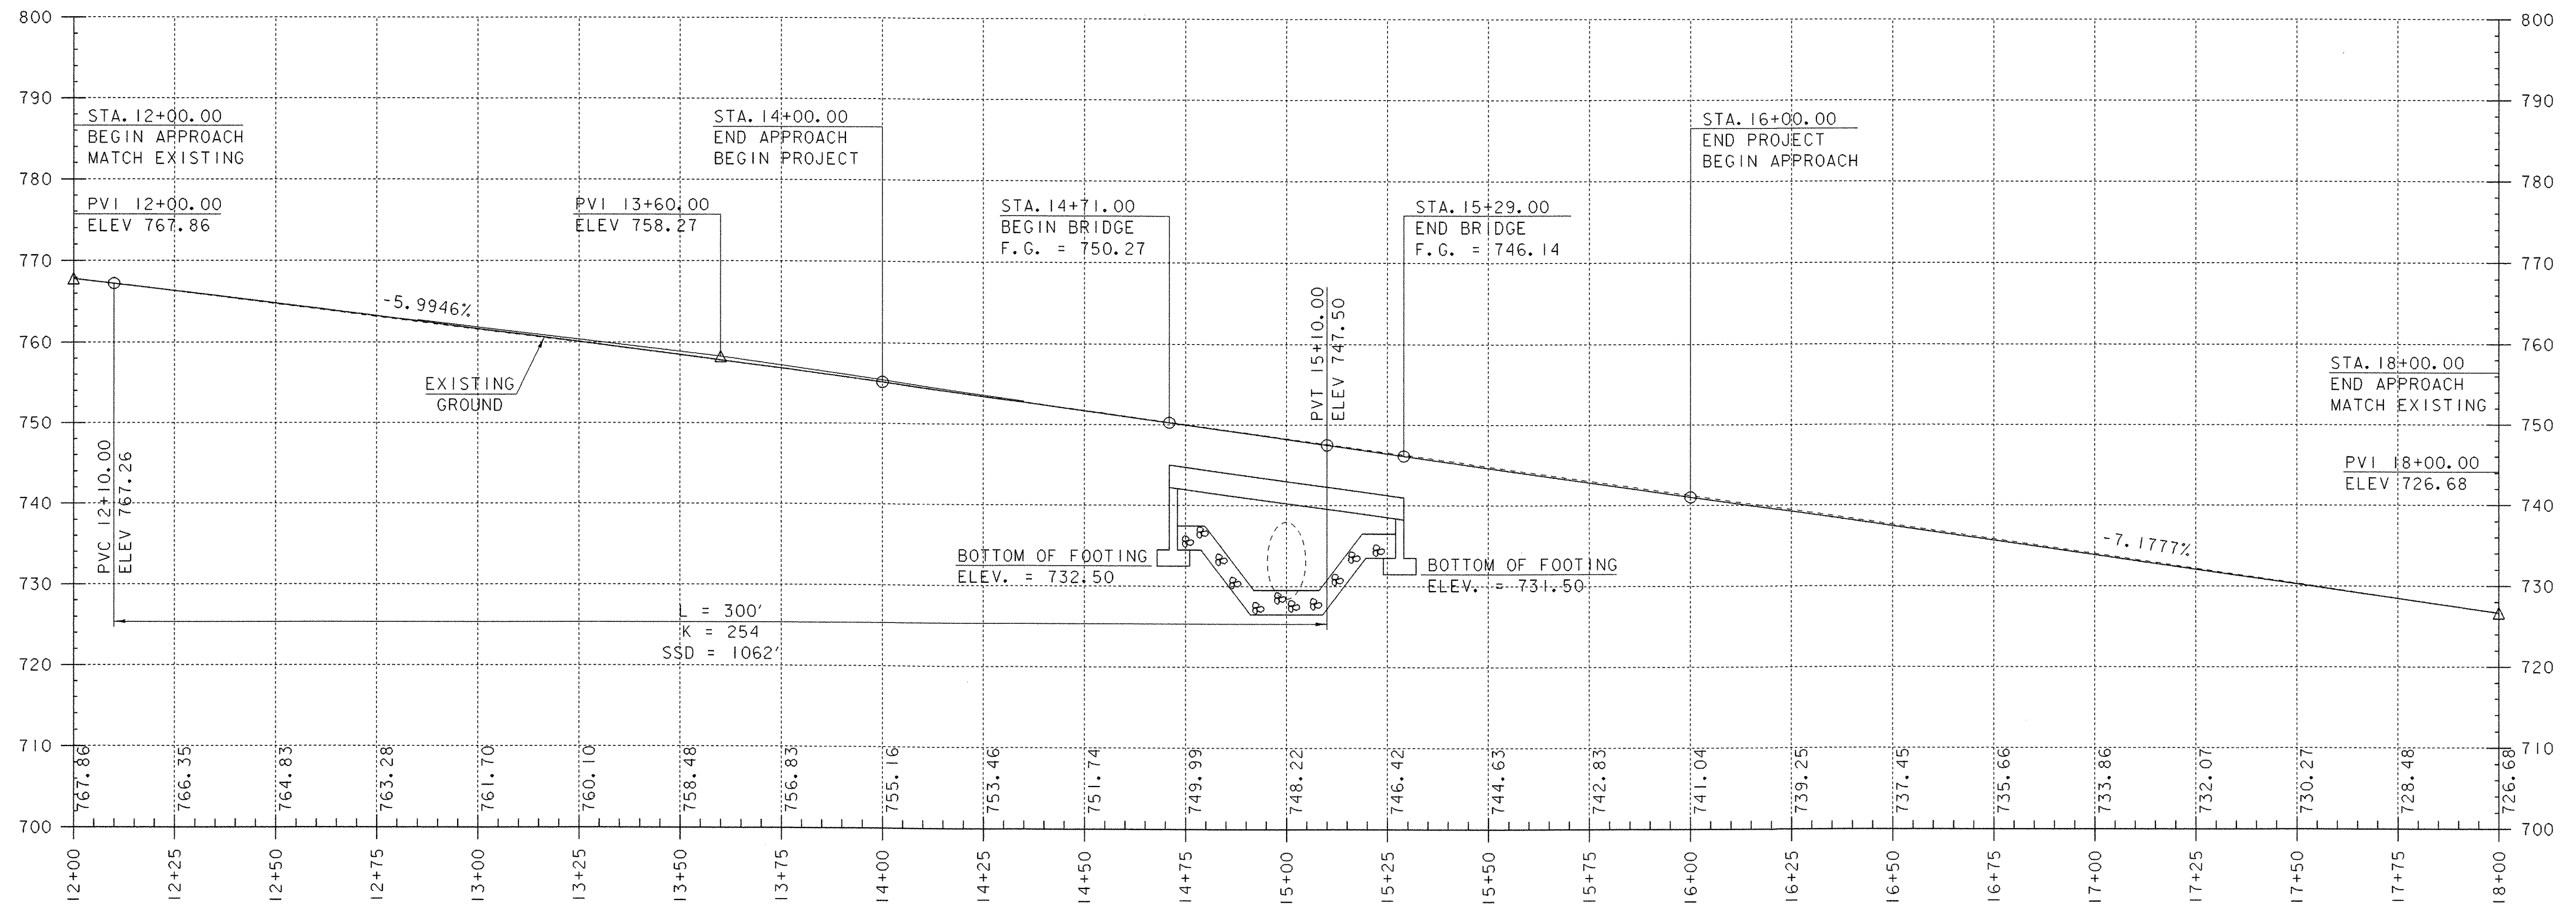

L = 300'
K = 254
SSD = 1062'

NOTE:
ELEVATIONS SHOWN TO THE NEAREST TENTH ARE EXISTING
GROUND ALONG NEW CENTERLINE.
ELEVATIONS SHOWN TO THE NEAREST HUNDREDTH ARE
FINISH GRADES ALONG NEW CENTERLINE.

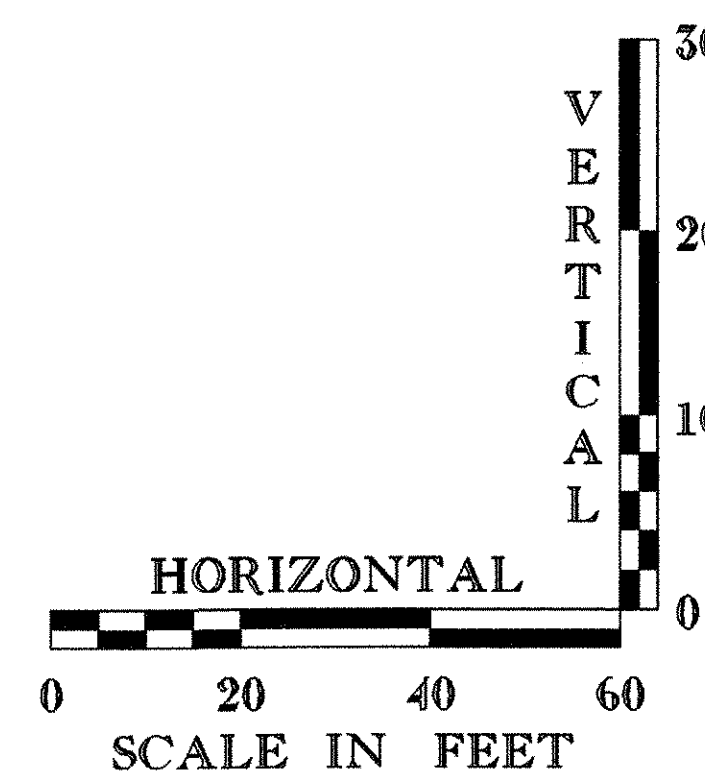

PROFILE SHEET

PROJECT NAME: SPRINGFIELD	PLOT DATE: 21-MAY-2007
PROJECT NUMBER: ST CULV (5)	DRAWN BY: G. ROY
FILE NAME: 04c178\Structures\s04c178xsl.dgn	CHECKED BY: D. PETERSON
PROJECT MANAGER: R.R. WHITCOMB	SHEET 9 OF 52
DESIGNED BY: J. PERRIGO	