

~~DURABLE 4 INCH WHITE LINE, THERMOPLASTIC~~
 STA. 12+00.0 RT. - STA. 18+00.0 RT.
 STA. 12+00.0 LT. - STA. 13+47.1 LT.
 STA. 13+74.5 LT. - STA. 18+00.0 LT.

~~DURABLE 4 INCH YELLOW LINE, THERMOPLASTIC~~
 STA. 12+00.0 CL. - STA. 13+37.8 CL. (DOUBLE)
 STA. 14+08.5 CL. - STA. 18+00.0 CL. (DOUBLE)
 STA. 13+60.6 LT. - STA. 13+66.0 LT. (DOUBLE)



~~DURABLE 24 INCH STOP BAR~~
 STA. 13+41.4 LT. - STA. 13+65.0 LT.

~~DURABLE LETTER OR SYMBOL~~
 STA. 13+55.06 LT. (4 EA.)

TRAFFIC SIGNS, TYPE A
 STA. 13+36.2 LT. (2 EA.)
 STA. 13+94.8 LT. (1 EA.)

REMOVING SIGNS
 STA. 13+35.6 LT. (2 EA.)
 STA. 13+95.6 LT. (1 EA.)
 STA. 14+05.6 LT. (1 EA.)

DURABLES REPLACED BY 15 MILS OF TEMPORARY PAINT

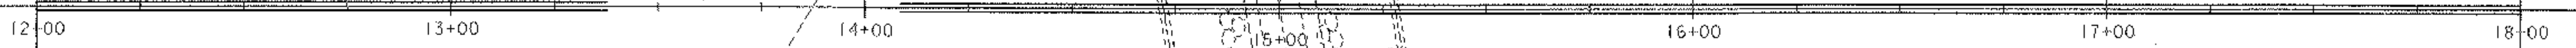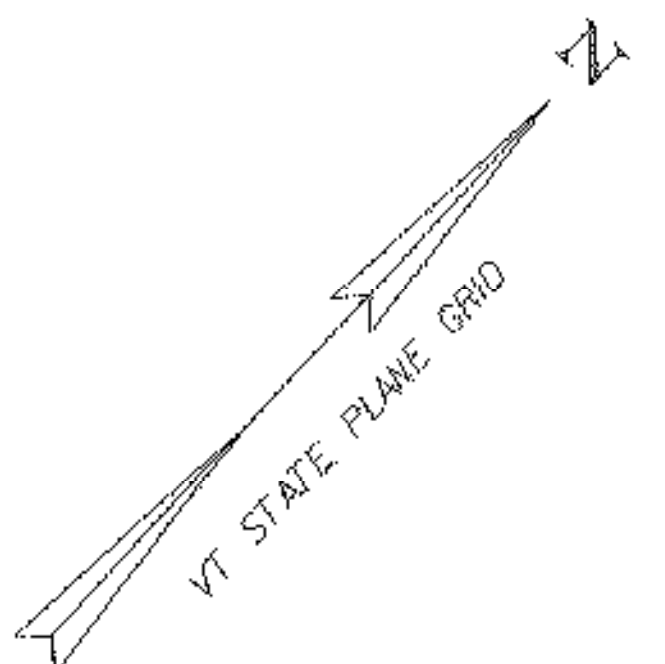

LEGEND

R - REMOVE
 R&S - REMOVE & SALVAGE
 S - SALVAGE
 N - NEW

EXISTING SIGN
 NEW SIGN

PERMANENT TRAFFIC SIGNS & PAVEMENT MARKINGS LAYOUT SHEET

PROJECT NAME: SPRINGFIELD	PLLOT DATE: 21-MAY-2007
PROJECT NUMBER: ST CULV (5)	DRAWN BY: G. ROY
FILE NAME: 04c178\structures\04c178tr.f.dgn	CHECKED BY: C. CARLSON
PROJECT MANAGER: R. R. WHITCOMB	SHEET 13 OF 52
DESIGNED BY: G. ROY	
04c178tr-f01j	

