
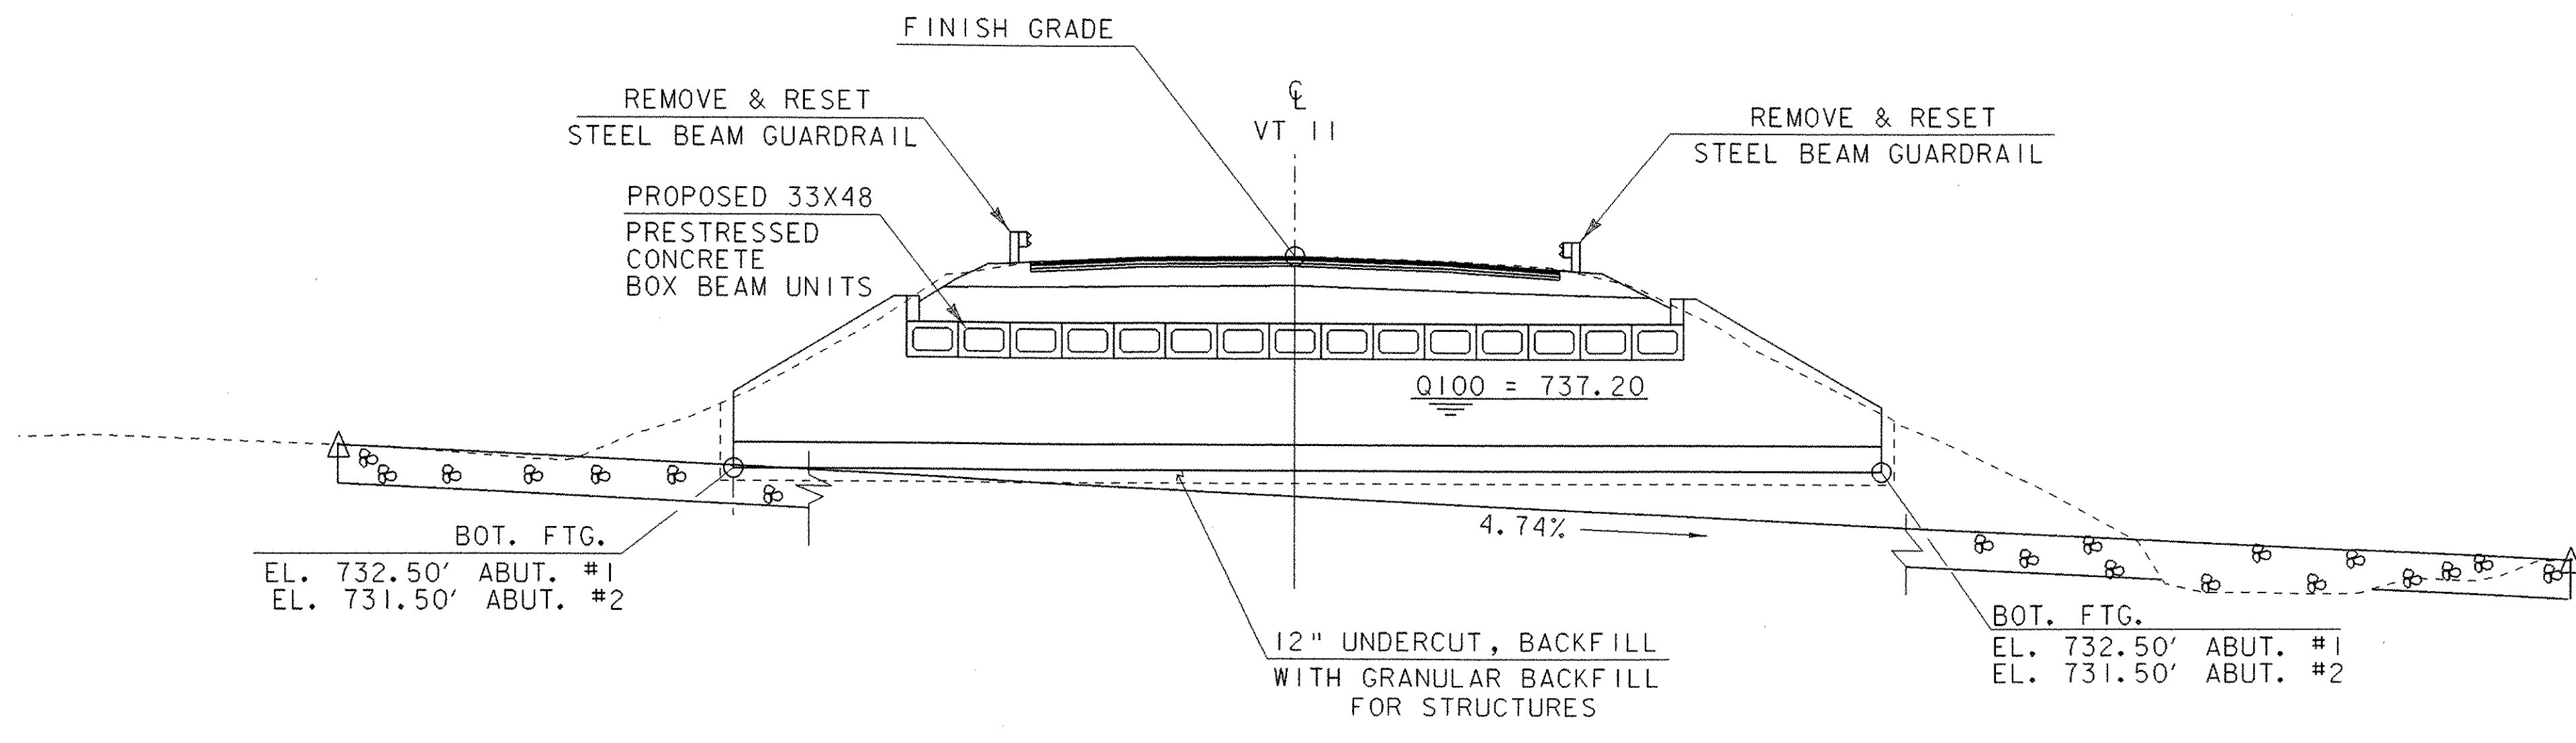
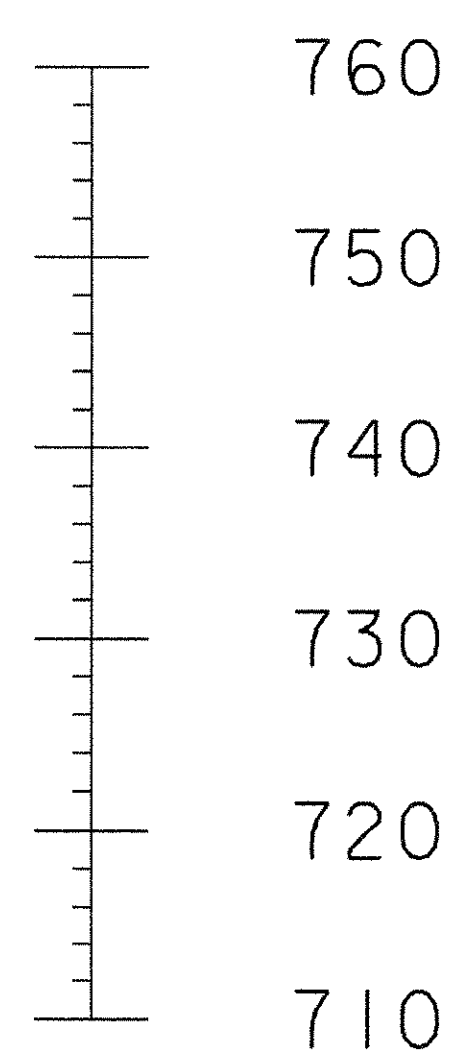
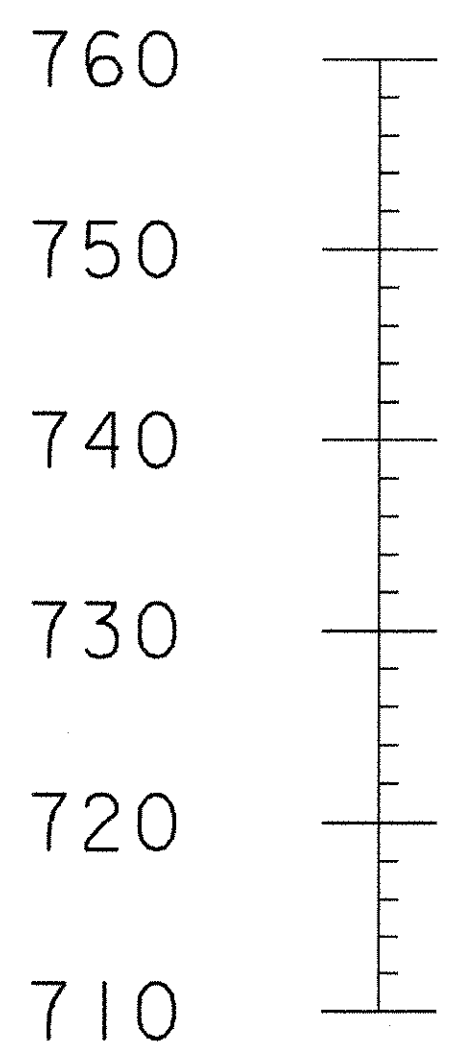


PLAN
 SCALE 1" = 10'-0"

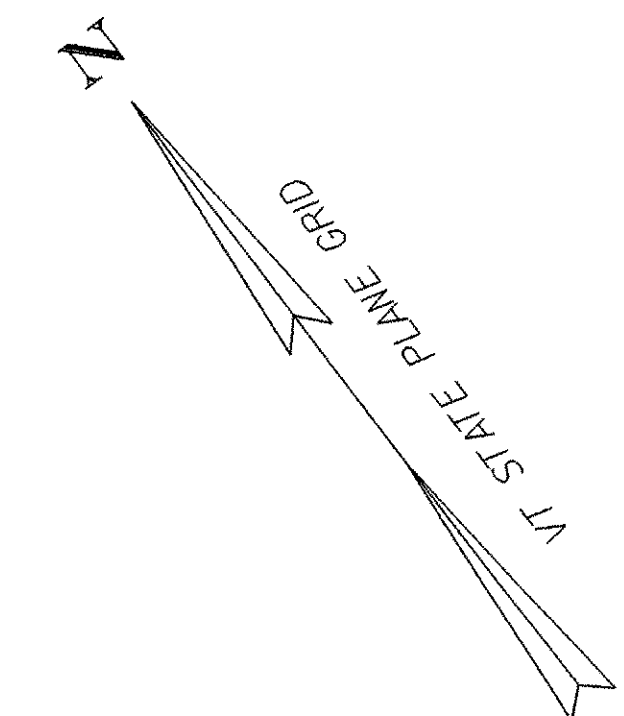

SECTION ALONG CHANNEL
 (HEADWALLS & FOOTINGS SHOWN FOR CLARITY)

SCALE 1" = 10'-0"

PROJECT NAME:	SPRINGFIELD	PLLOT DATE:	21-MAY-2007
PROJECT NUMBER:	ST CULV(5)	DRAWN BY:	J. PERRIGO
FILE NAME:	/04cl78/str/s04cl78pe.dgn	DESIGNED BY:	D. BONNEAU
PROJECT LEADER:	R. WHITCOMB	CHECKED BY:	D. PETERSON
			SHEET 17 OF 52

PLAN & ELEVATION