


LEGEND	
-----	ORDINARY HIGH WATER
→	EXISTING DRAINAGE

EXISTING ROW

NOTE:
NO RESOURCES HAVE BEEN IDENTIFIED
OTHER THAN THE STREAM AND RIPARIAN
BUFFER ZONE.

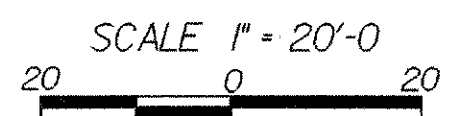

EROSION PREVENTION & SEDIMENT CONTROL EXISTING CONDITIONS

PROJECT NAME:	SPRINGFIELD	FILE NAME:	/04c178/str/s04c178ecbdr.dgn	PLOT DATE:	21-MAY-2007
PROJECT NUMBER:	ST CULV(5)	PROJECT LEADER:	R. WHITCOMB	DRAWN BY:	M. HALE
		DESIGNED BY:	D. BONNEAU	CHECKED BY:	
		s04c178ec01.l		SHEET	19 OF 52