


LEGEND	
	PROPOSED DRAINAGE

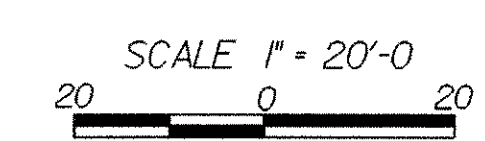

EROSION PREVENTION & SEDIMENT CONTROL FINAL CONDITIONS

PROJECT NAME: SPRINGFIELD	PLOT DATE: 21-MAY-2007
PROJECT NUMBER: ST CULV(5)	DRAWN BY: M. HALE
FILE NAME: /04c178/str/s04c178ecbdr.dgn	CHECKED BY: C. CARLSON
PROJECT LEADER: R. WHITCOMB	SHEET 23 OF 52
DESIGNED BY: D. BONNEAU	
s04c178ec05.1	