


**ABUTMENT NO. 1 PLAN**

SCALE: 1/4" = 1'-0"

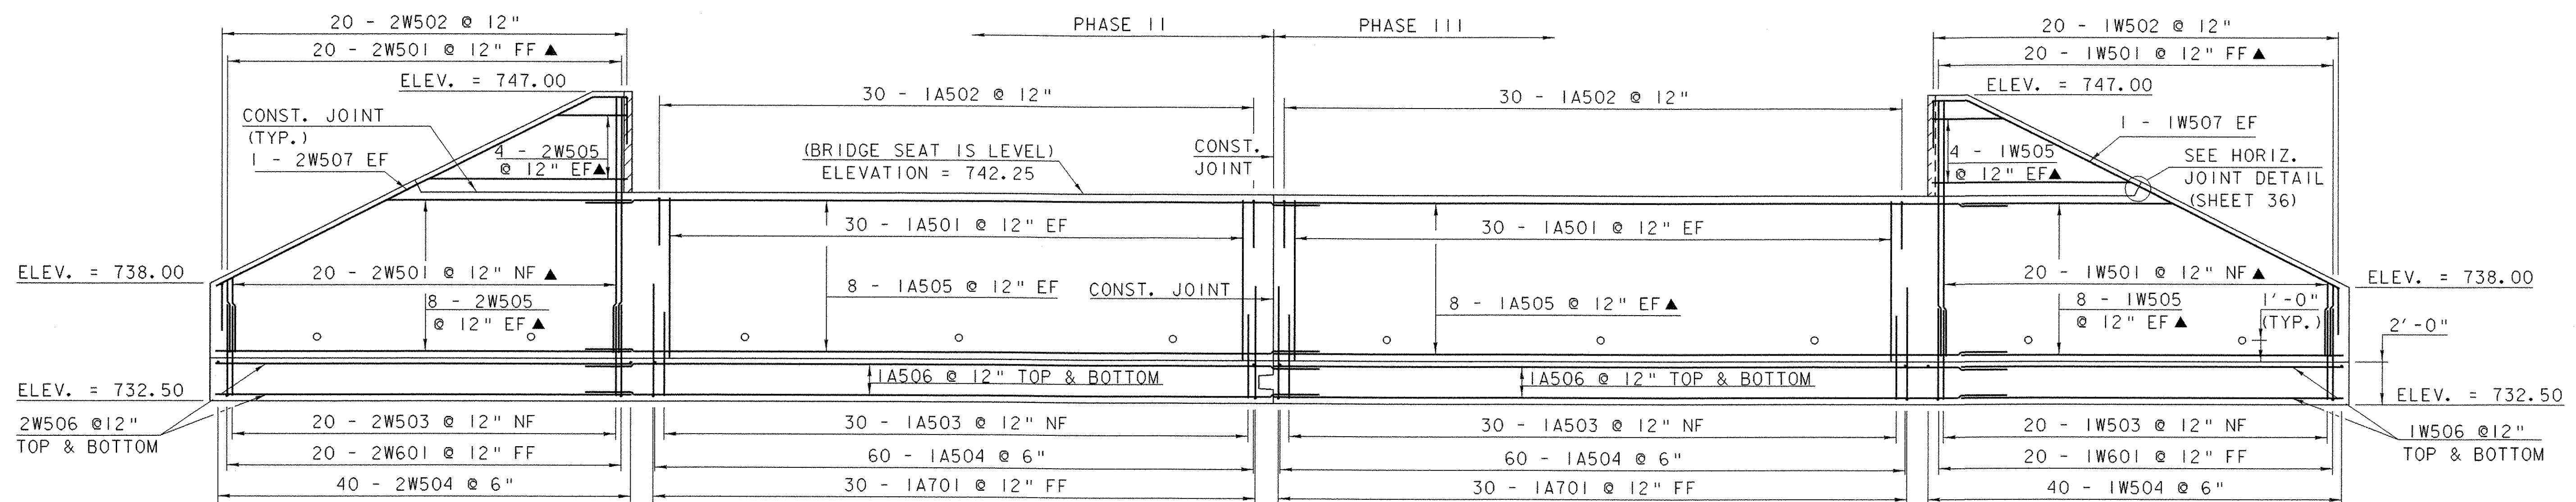

**ABUTMENT NO. 1 ELEVATION**

SCALE: 1/4" = 1'-0"

**NOTES:**

- NF = NEAR FACE
- FF = FAR FACE
- EF = EACH FACE
- ▲ = CUT TO FIT IN FIELD
- 3" CLEAR UNLESS OTHERWISE SPECIFIED
- 2'-2" MIN. LAP UNLESS OTHERWISE SPECIFIED

**ABUTMENT NO. 1 DETAILS**

PROJECT NAME: SPRINGFIELD	PLOT DATE: 21-MAY-2007
PROJECT NUMBER: ST CULV (5)	DRAWN BY: D. PETERSON
FILE NAME: /04cl78/str/s04cl78ab.dgn	CHECKED BY: W. LAMMER
PROJECT MANAGER: R. R. WHITCOMB	SHEET 34 OF 52
DESIGNED BY: D. PETERSON	