


ABUTMENT NO. 2 PLAN

SCALE: 1/4" = 1'-0"

FLOW →

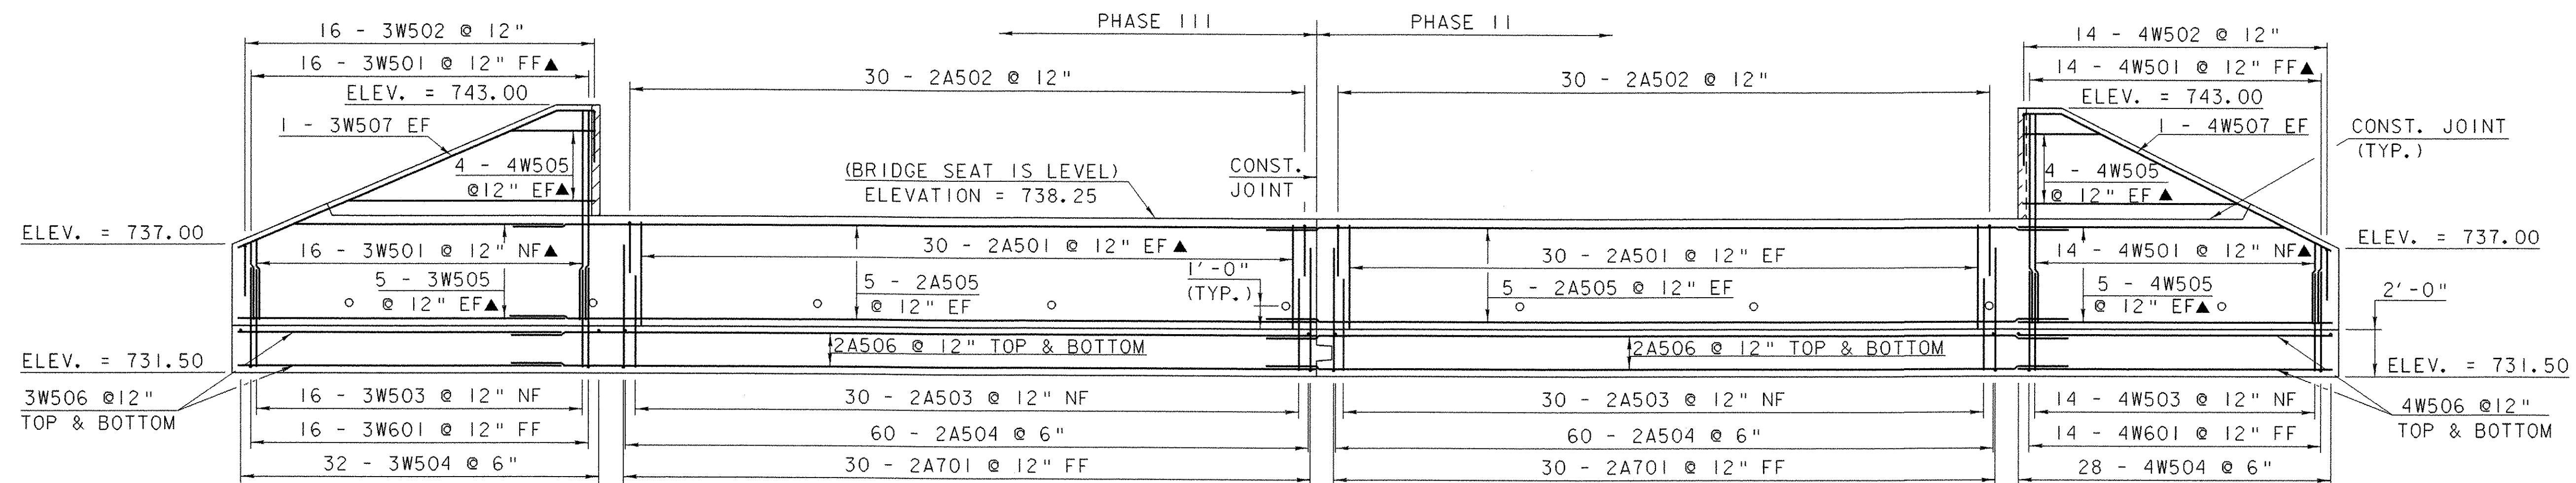

ABUTMENT NO. 2 ELEVATION

SCALE: 1/4" = 1'-0"

NOTES:

- NF = NEAR FACE
- FF = FAR FACE
- EF = EACH FACE
- ▲ = CUT TO FIT IN FIELD
- 3" CLEAR UNLESS OTHERWISE SPECIFIED
- 2'-2" MIN. LAP UNLESS OTHERWISE SPECIFIED

ABUTMENT NO. 2 DETAILS

PROJECT NAME:	SPRINGFIELD	PLOT DATE:	21-MAY-2007
PROJECT NUMBER:	ST CULV (5)	DRAWN BY:	D. PETERSON
FILE NAME:	/04c178/str/s04c178ab.dgn	DESIGNED BY:	D. PETERSON
		CHECKED BY:	W. LAMMER
			SHEET 35 OF 52