


ABUTMENT NO. 1 FOOTING REINFORCING PLAN

SCALE: 1/4" = 1'-0"

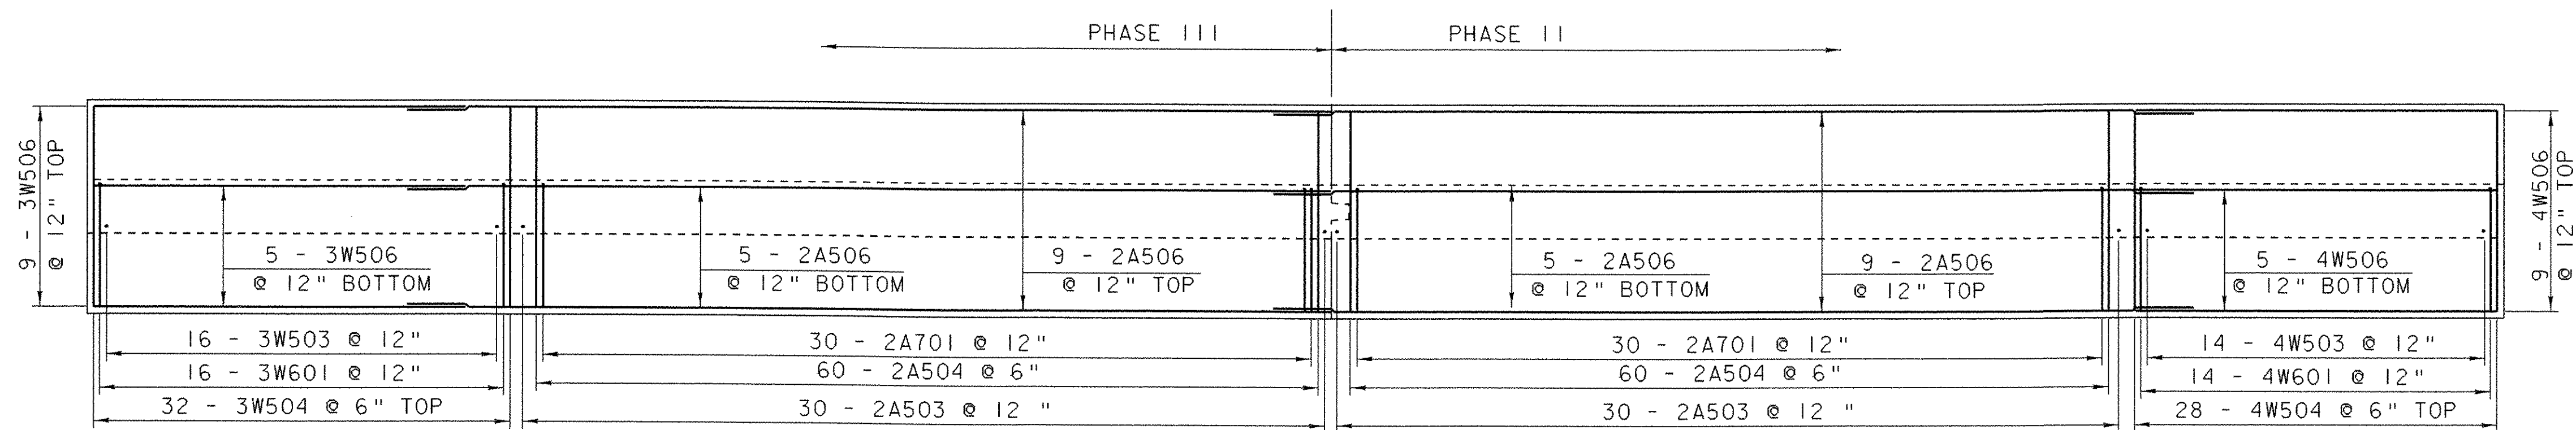

ABUTMENT NO. 2 FOOTING REINFORCING PLAN

SCALE: 1/4" = 1'-0"

NOTES:

- NF = NEAR FACE
- FF = FAR FACE
- EF = EACH FACE
- ▲ = CUT TO FIT IN FIELD
- 3" CLEAR UNLESS OTHERWISE SPECIFIED
- 2'-2" MIN. LAP UNLESS OTHERWISE SPECIFIED

FOOTING REINFORCING PLAN

PROJECT NAME: SPRINGFIELD
PROJECT NUMBER: ST CULV (5)

FILE NAME: /04cl78/str/s04cl78ab.dgn
PROJECT MANAGER: R. R. WHITCOMB
DESIGNED BY: D. PETERSON
PLOT DATE: 21-MAY-2007
DRAWN BY: D. PETERSON
CHECKED BY: W. LAMMER
SHEET 37 OF 52