


NOTES:

1. SEE SECTIONS TO DETERMINE CUT OR FILL.
2. SEE PROJECT TYPICAL SECTIONS FOR ABUTMENT EARTHWORK DETAILS.

MATERIAL TRANSITION DETAIL

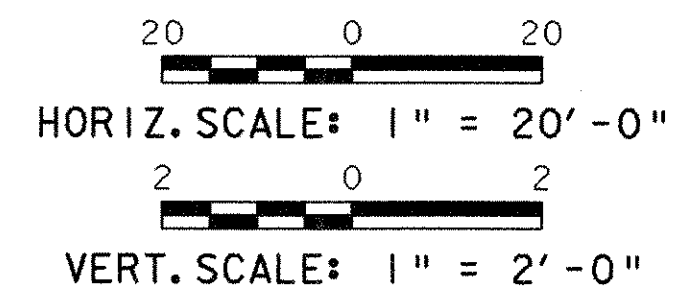

MATERIAL TRANSITION DETAIL

| | |
|---|-------------------------|
| PROJECT NAME: SPRINGFIELD | PLOT DATE: 21-MAY-2007 |
| PROJECT NUMBER: ST CULV (5) | DRAWN BY: G. ROY |
| FILE NAME: 04c178\Structures\s04c178xsl.dgn | CHECKED BY: D. PETERSON |
| PROJECT MANAGER: R.R. WHITCOMB | SHEET 39 OF 52 |
| DESIGNED BY: J. PERRIGO | |
| s04c178mtd.i | |