



14+25

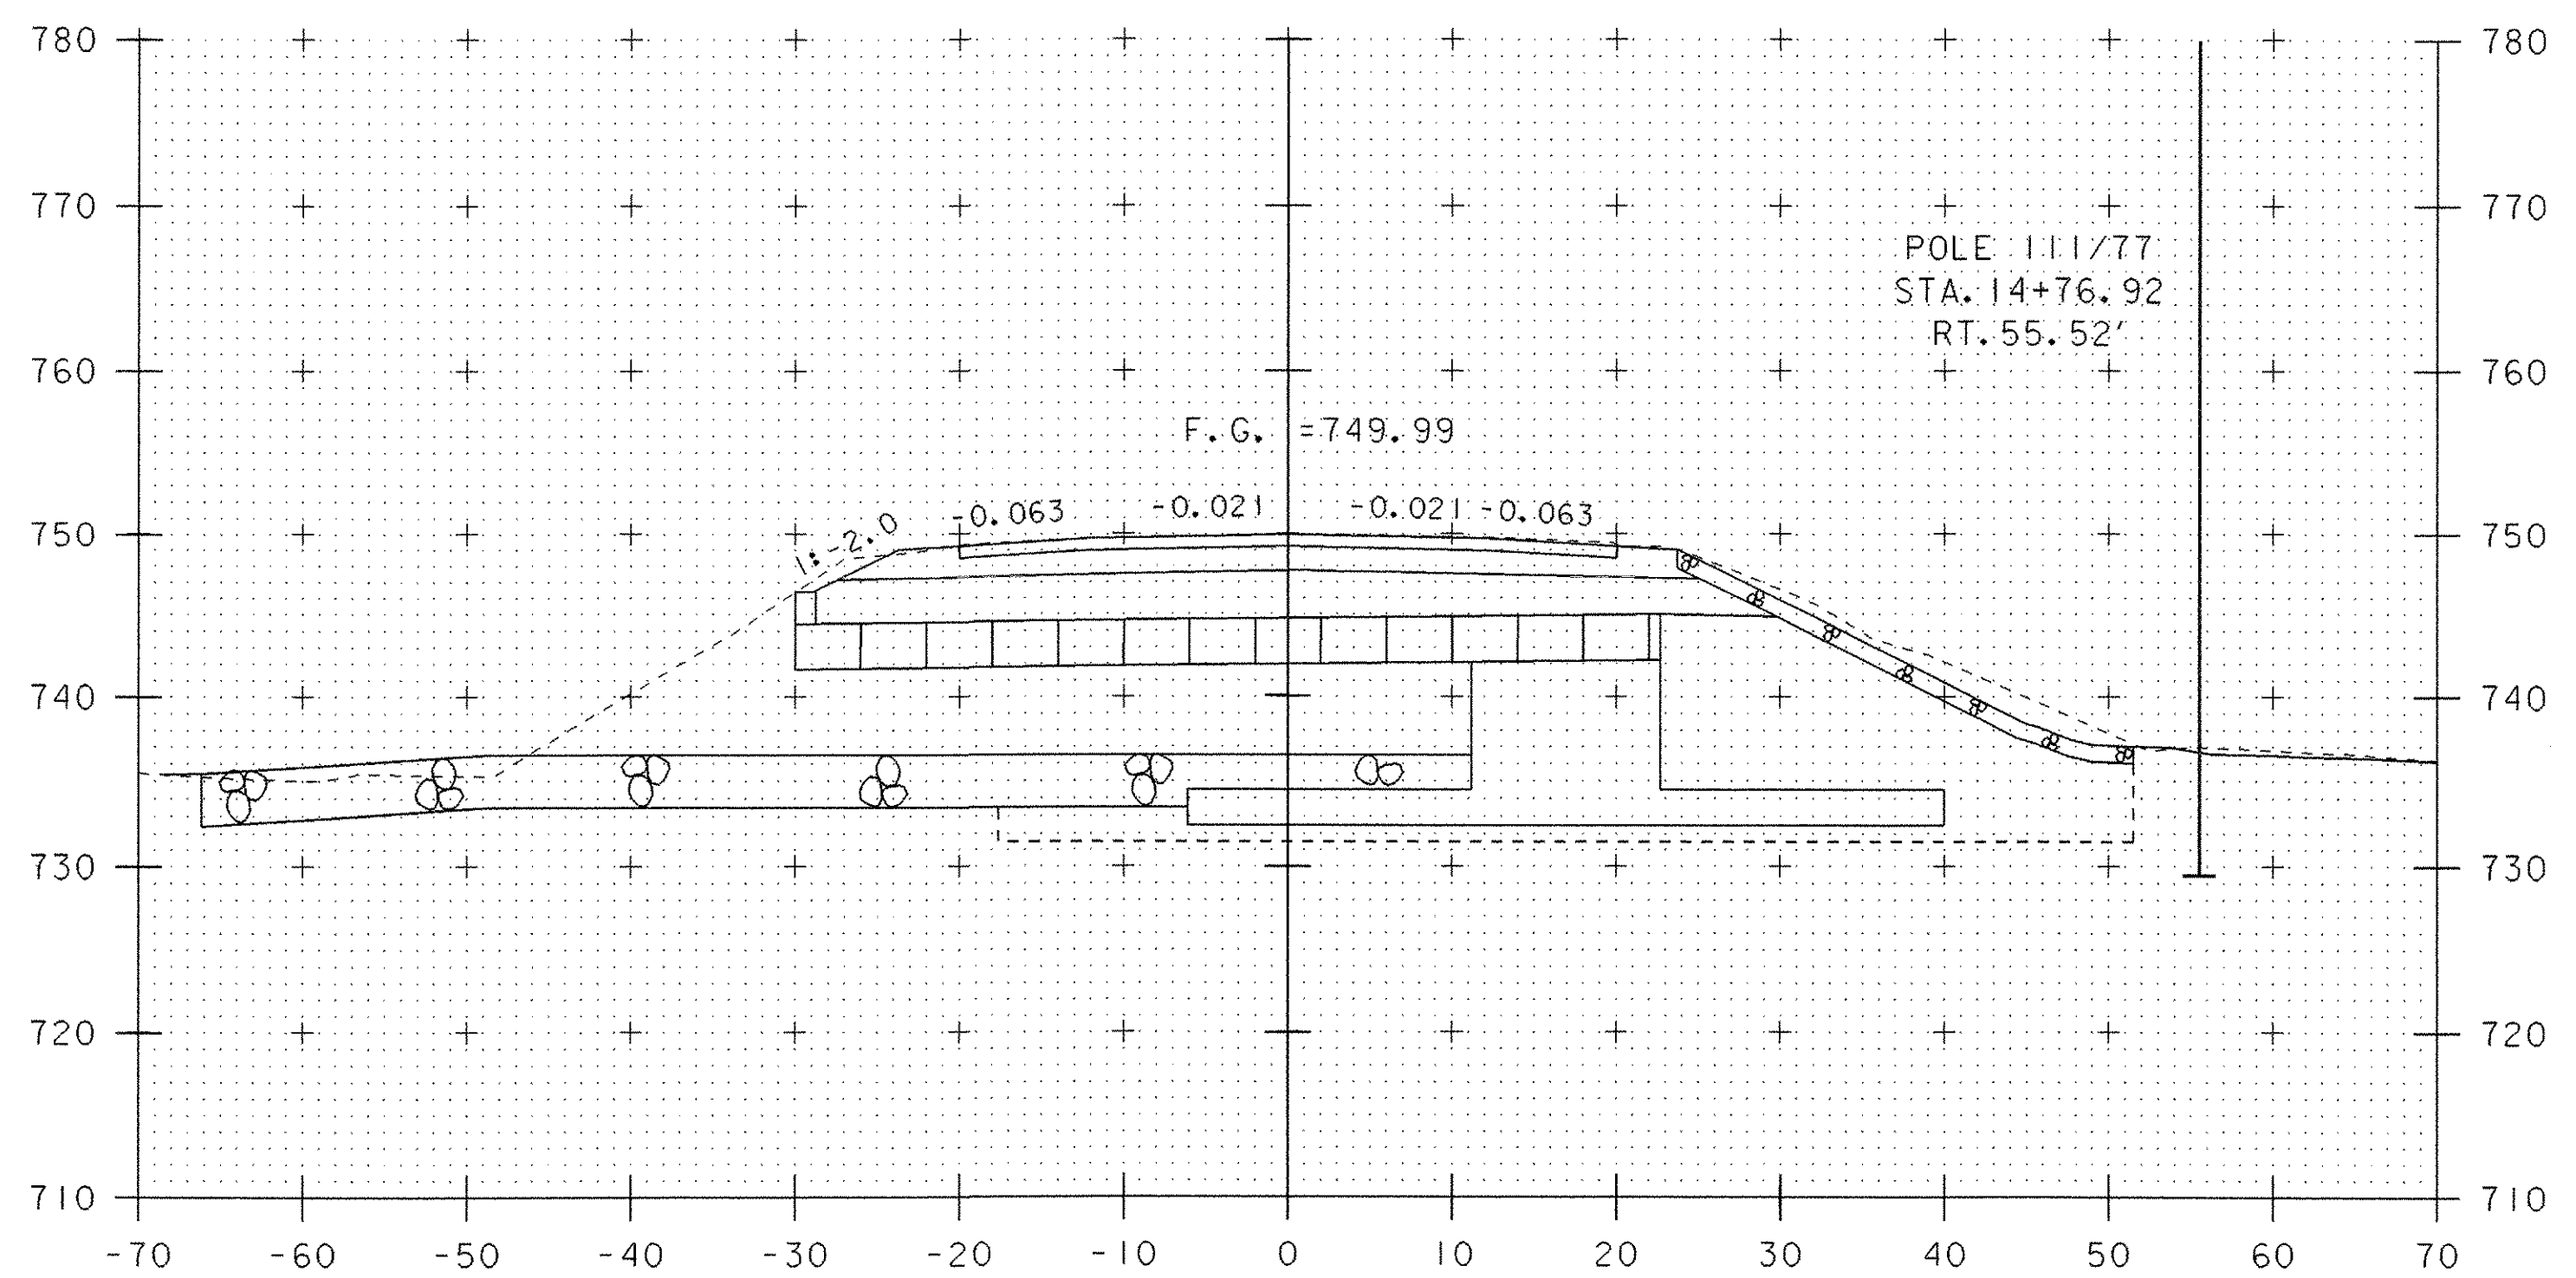


14+75

STA. 14+71.00
BEGIN BRIDGE

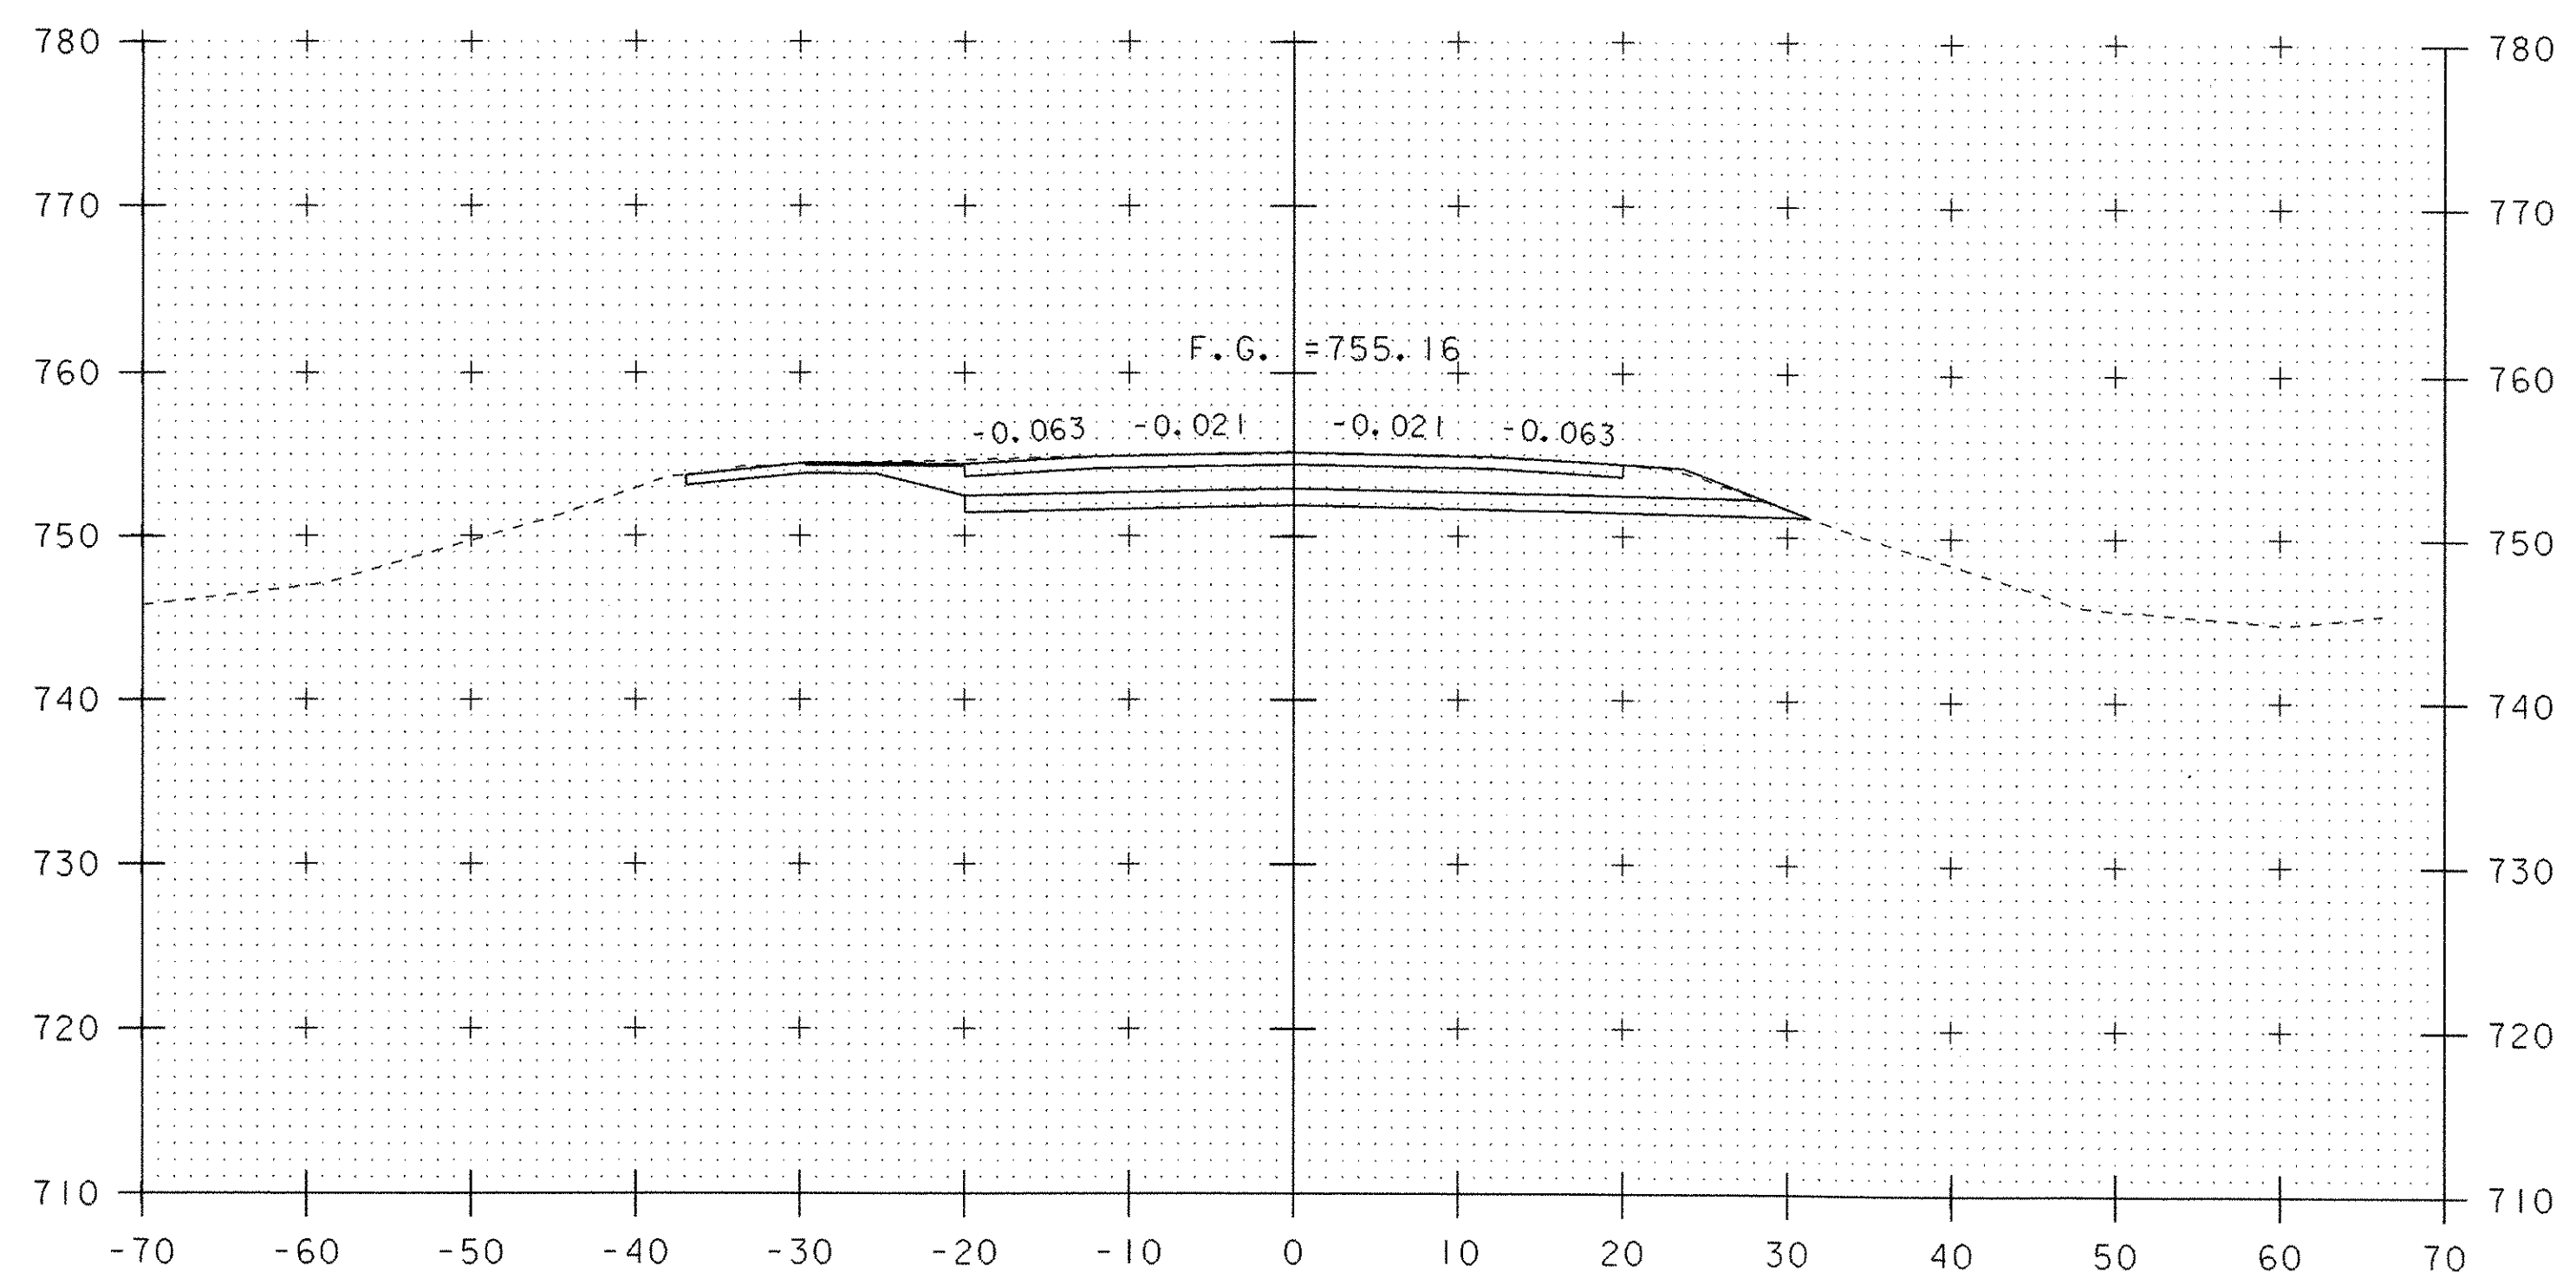


14+00

STA. 14+00.00
END APPROACH
BEGIN PROJECT

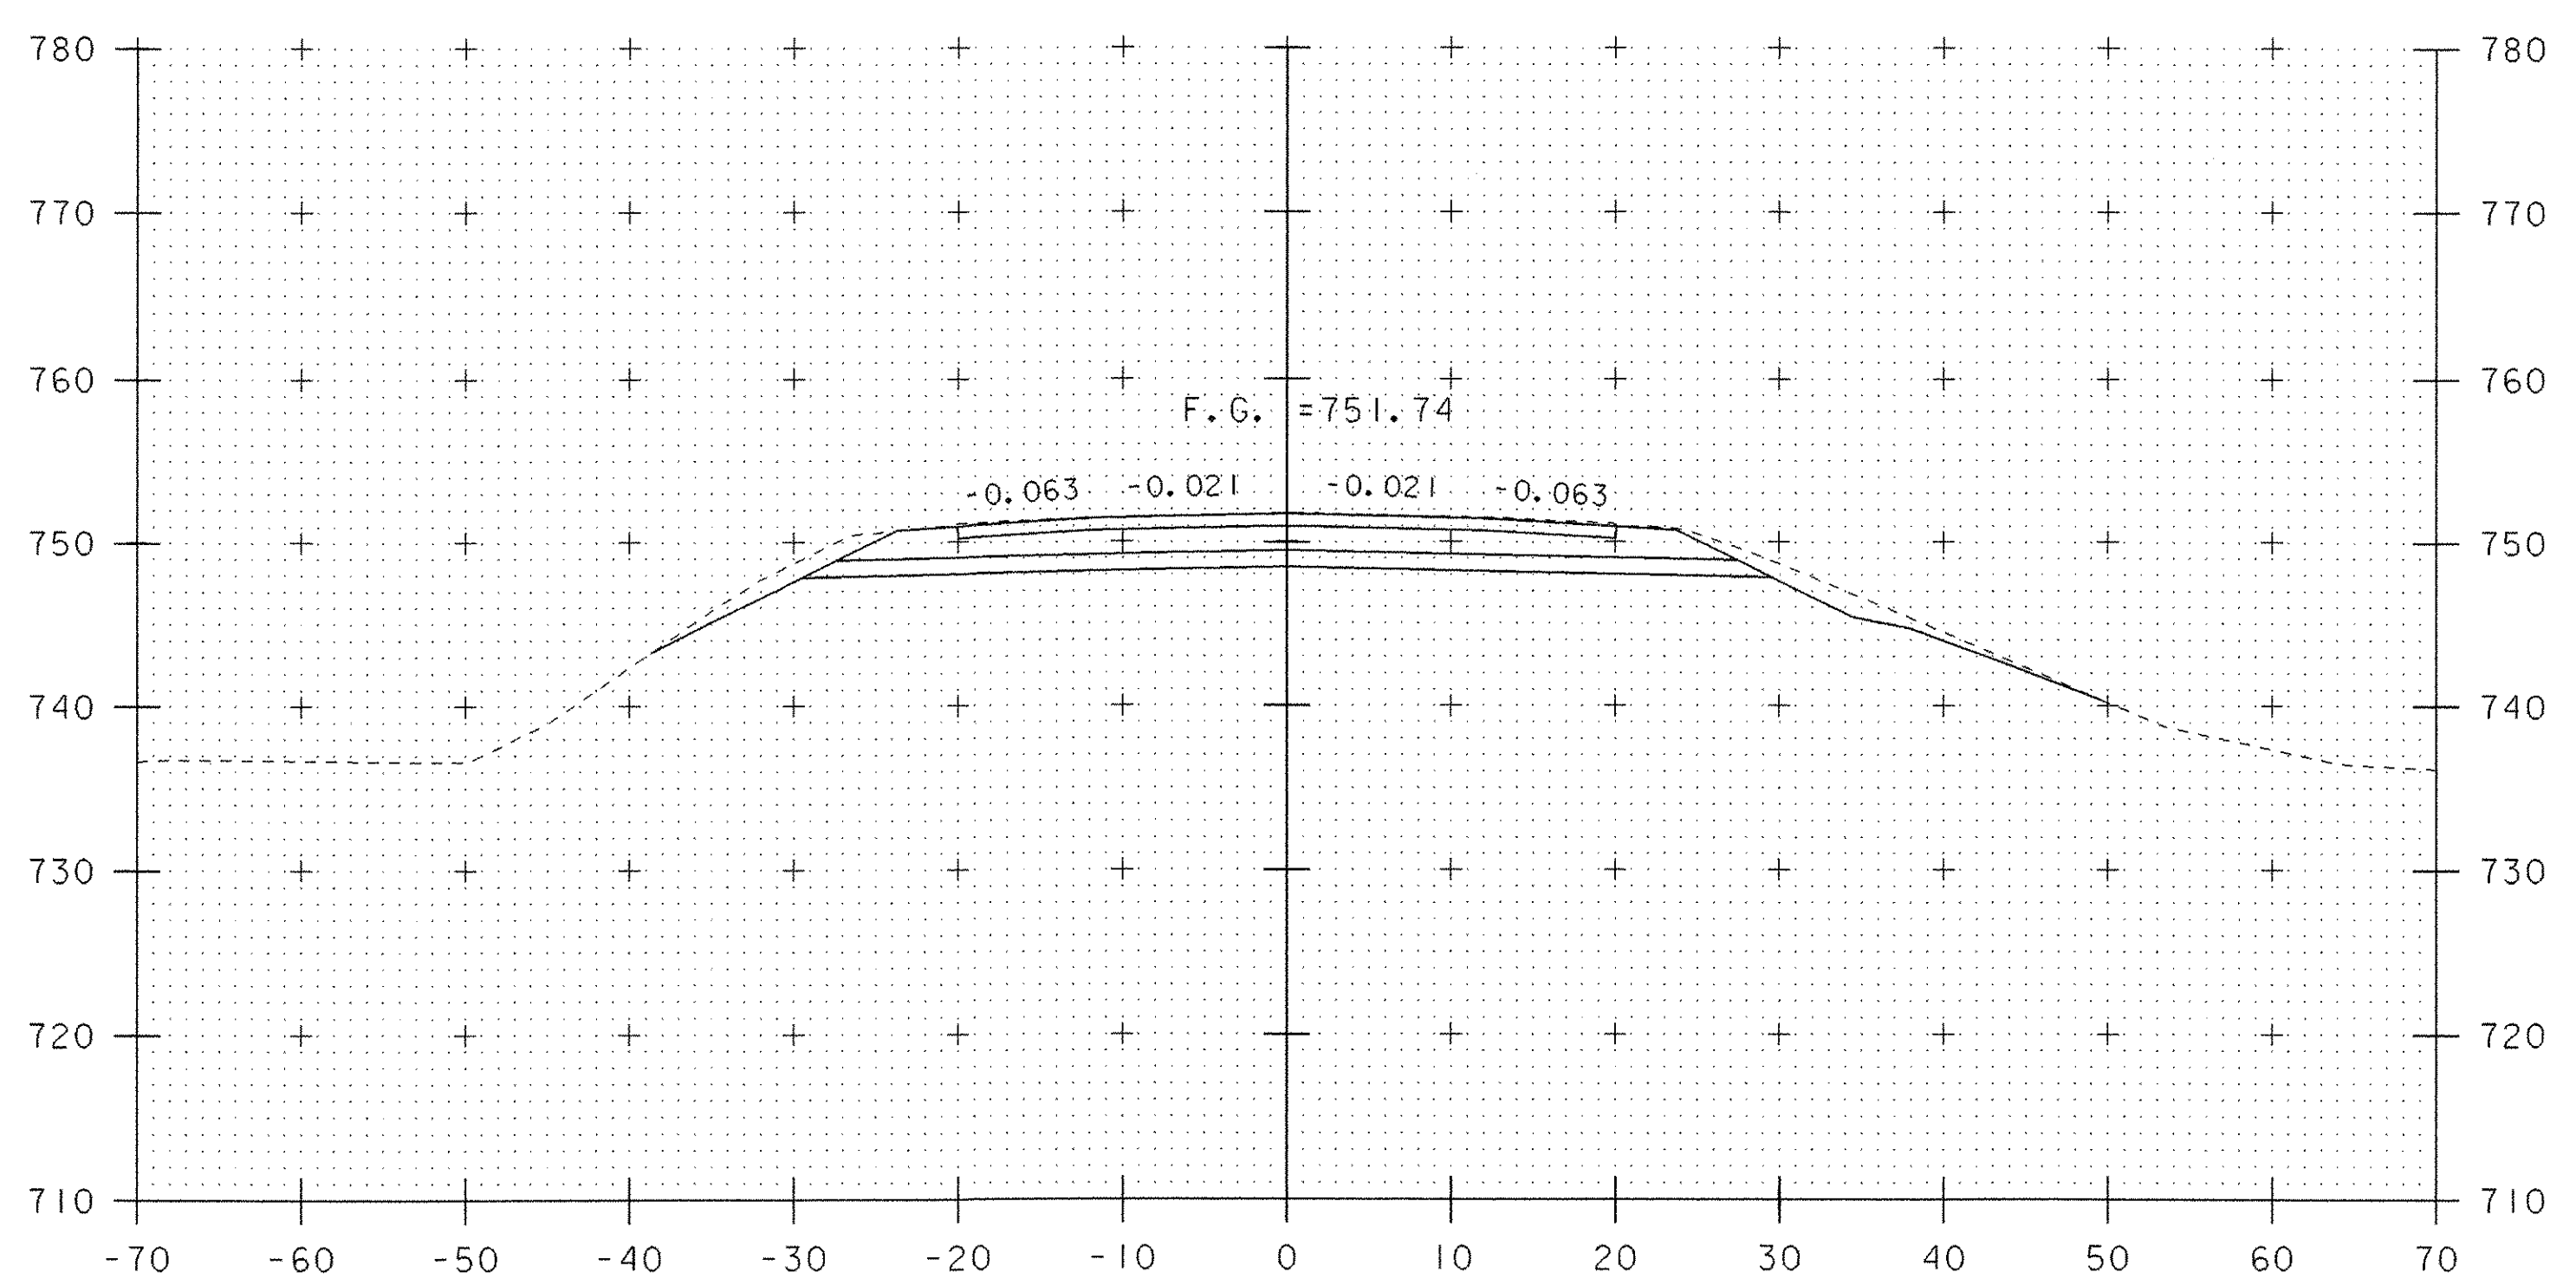

14+50

MAINLINE CROSS SECTIONS (3)

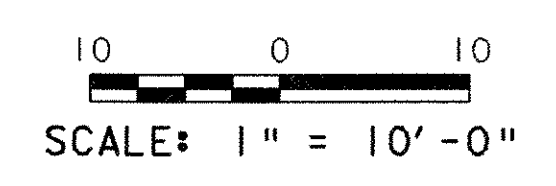

PROJECT NAME:	SPRINGFIELD	PLOT DATE:	21-MAY-2007
PROJECT NUMBER:	ST CULV (5)	DRAWN BY:	M. HALE
FILE NAME:	04c178\structures\s04c178xsl.dgn	CHECKED BY:	D. PETERSON
PROJECT MANAGER:	R. R. WHITCOMB	SHEET	42 OF 52
DESIGNED BY:	J. PERRIGO		
s04c178m03.i			