



16+25

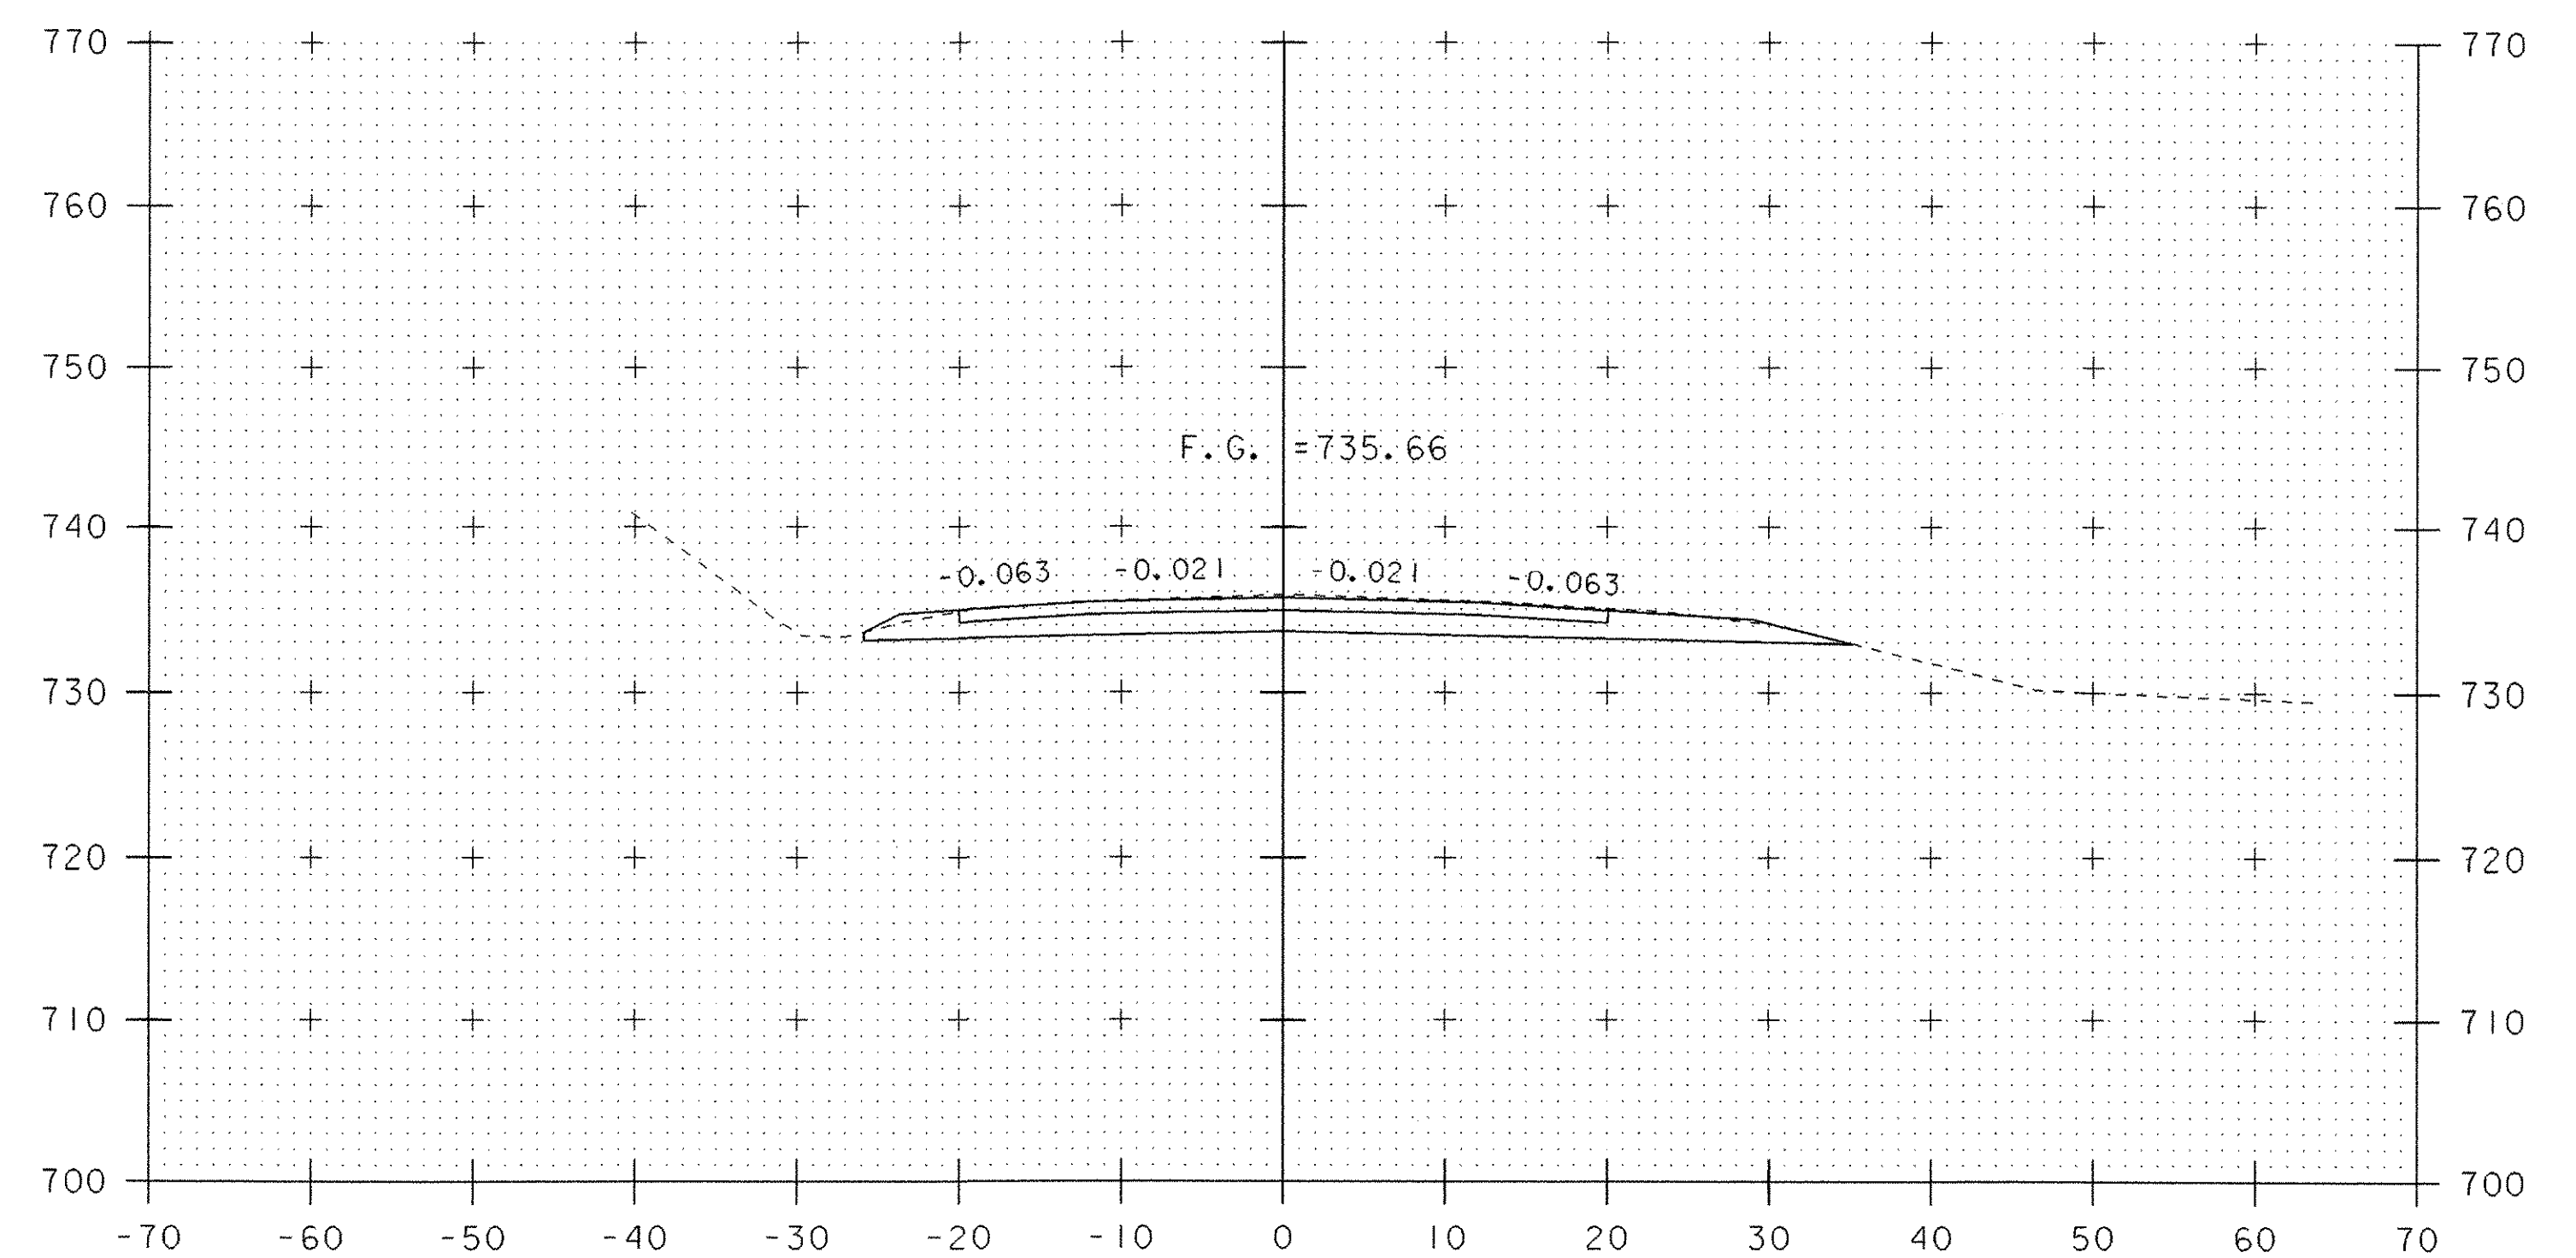


16+75

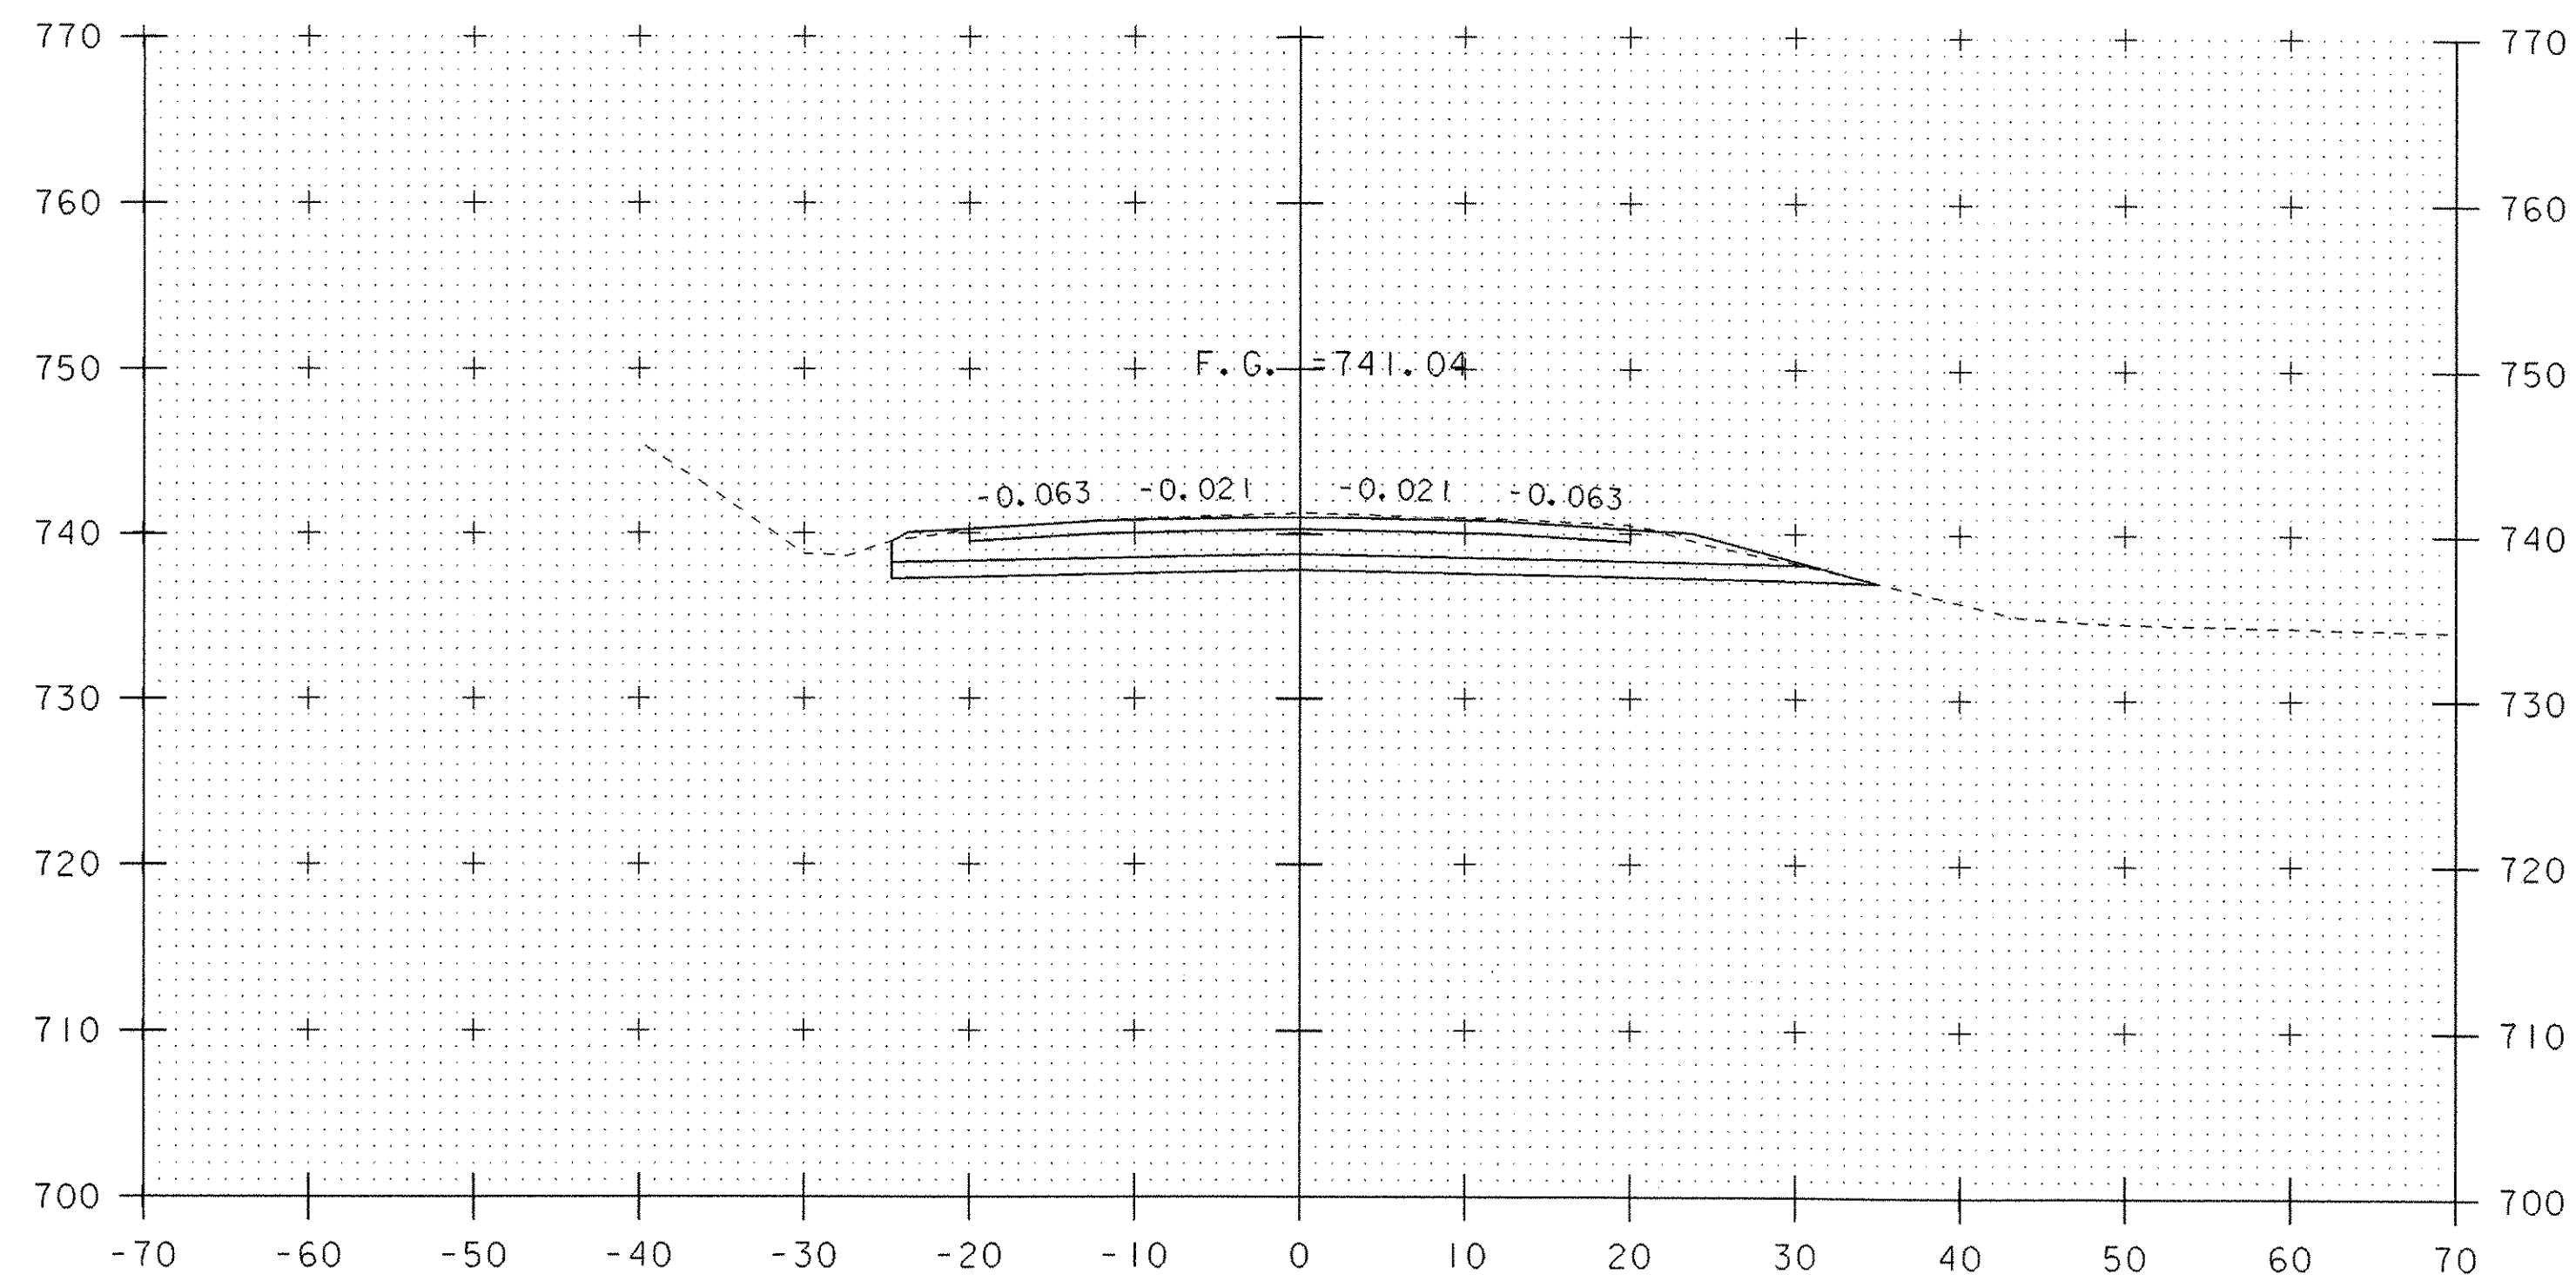

16+00

STA. 16+00.00  
END PROJECT  
BEGIN APPROACH

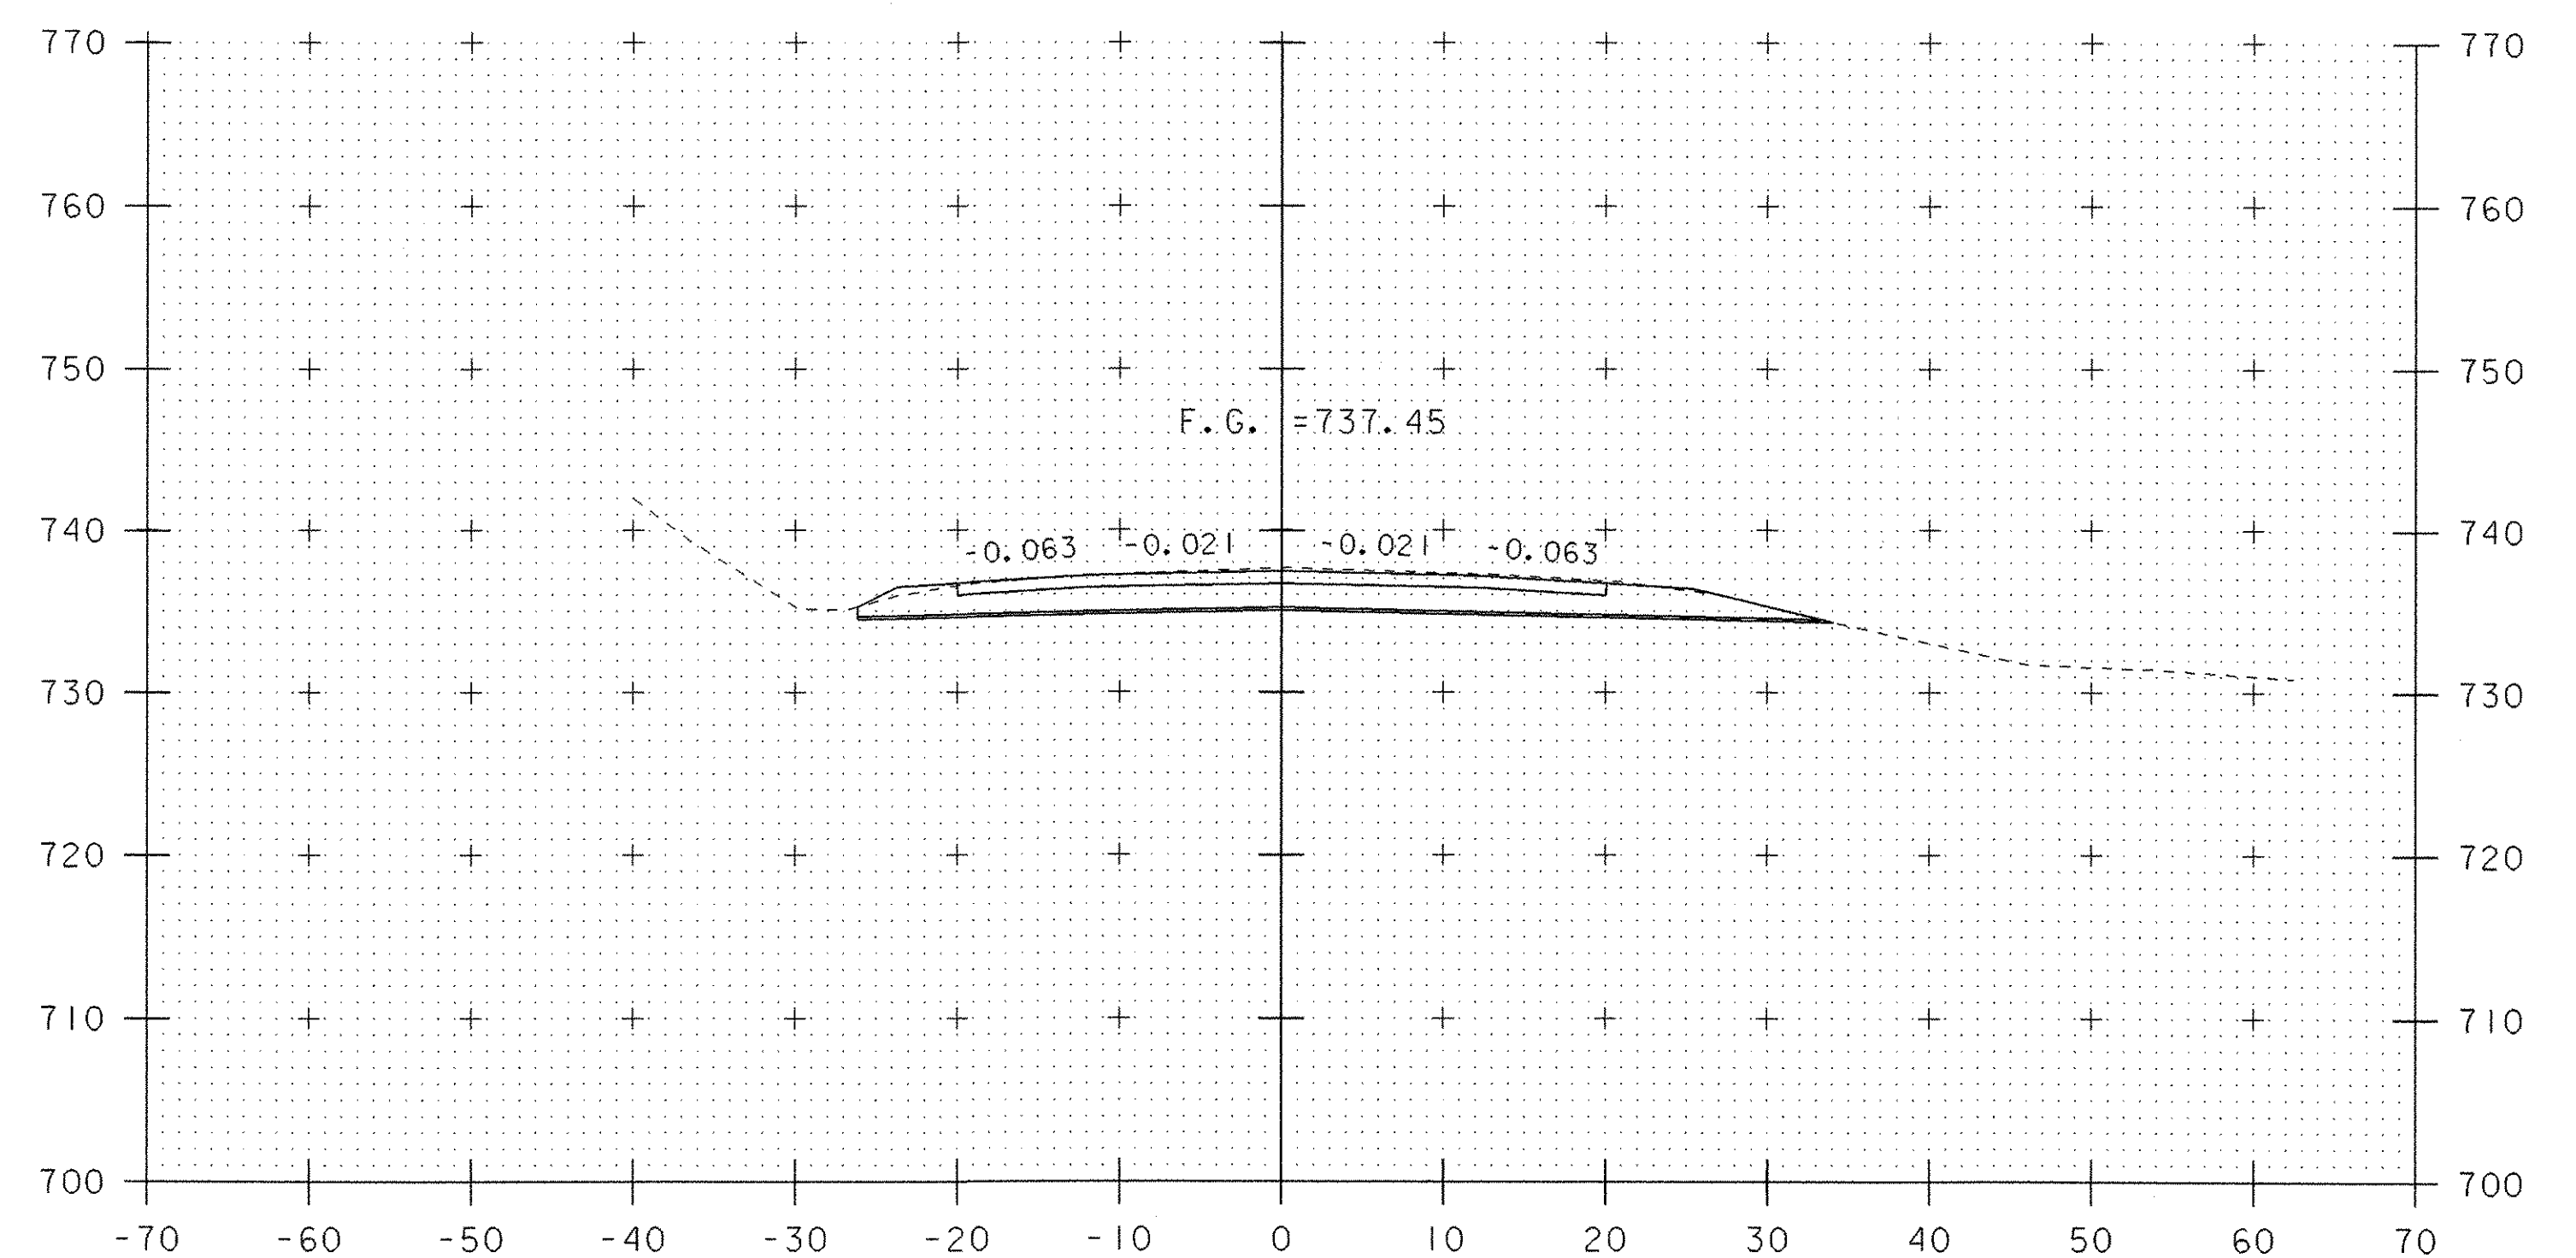

16+50

10 0 10  
SCALE: 1" = 10'-0"

MAINLINE CROSS SECTIONS (5)

PROJECT NAME: SPRINGFIELD	PLOT DATE: 21-MAY-2007
PROJECT NUMBER: ST CULV (5)	DRAWN BY: M. HALE
FILE NAME: 04c178\Structures\s04c178xsl.dgn	CHECKED BY: D. PETERSON
PROJECT MANAGER: R. R. WHITCOMB	SHEET 44 OF 52
DESIGNED BY: J. PERRIGO	