




17+25

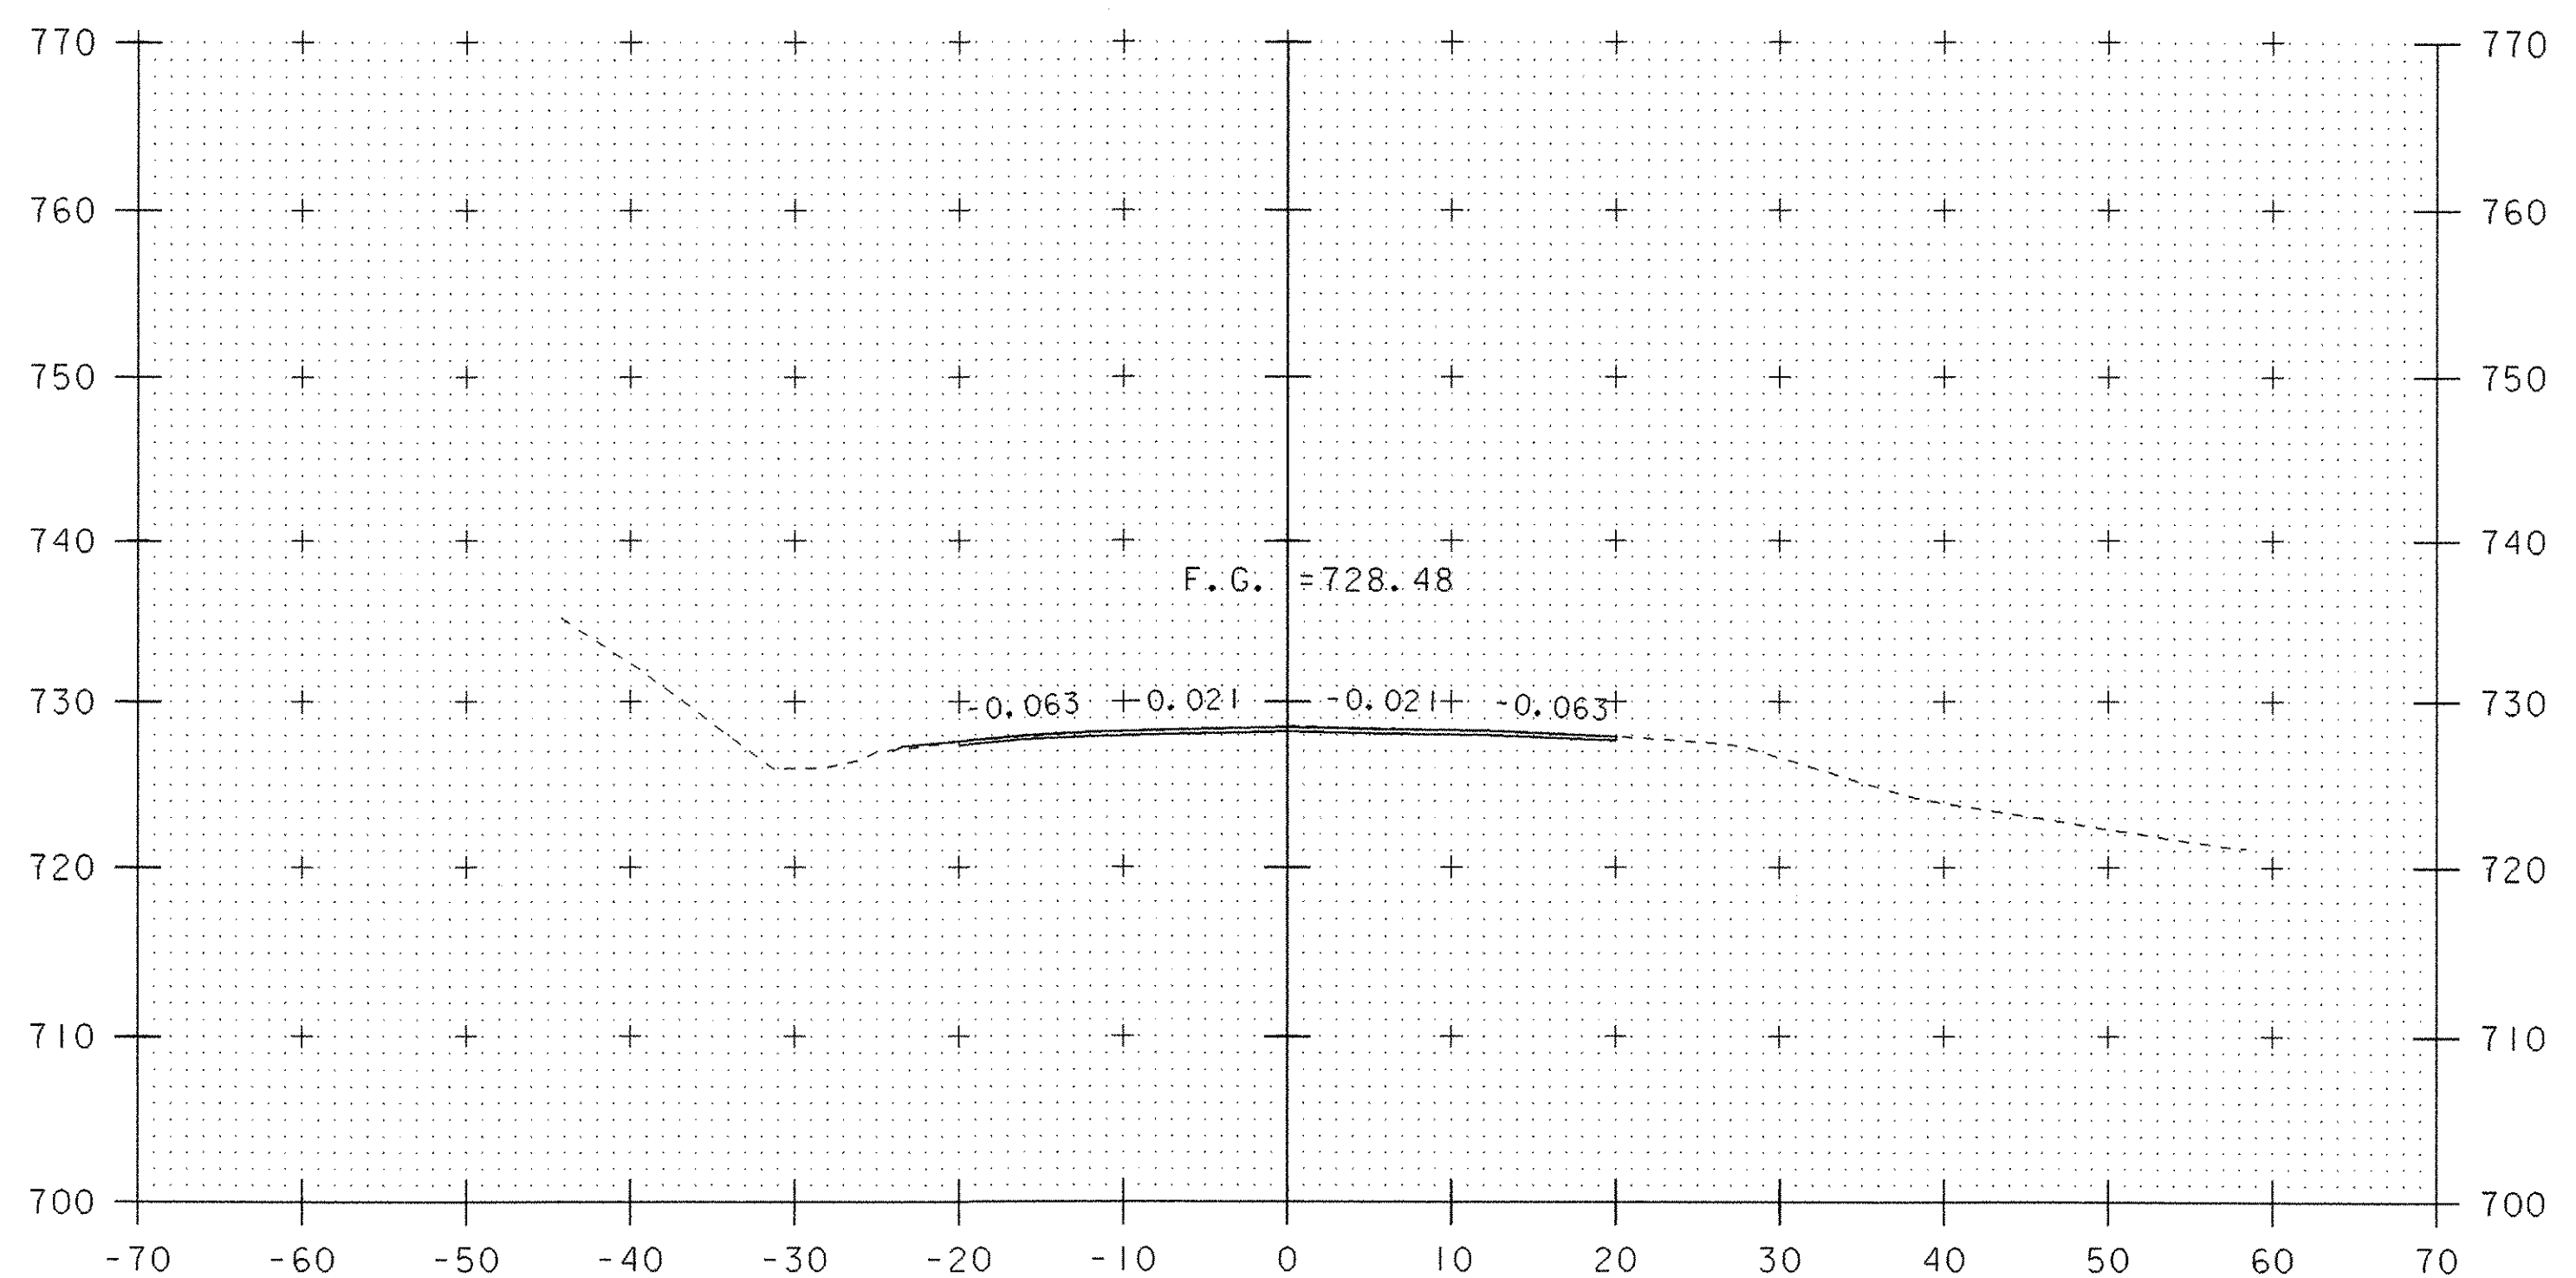

17+75

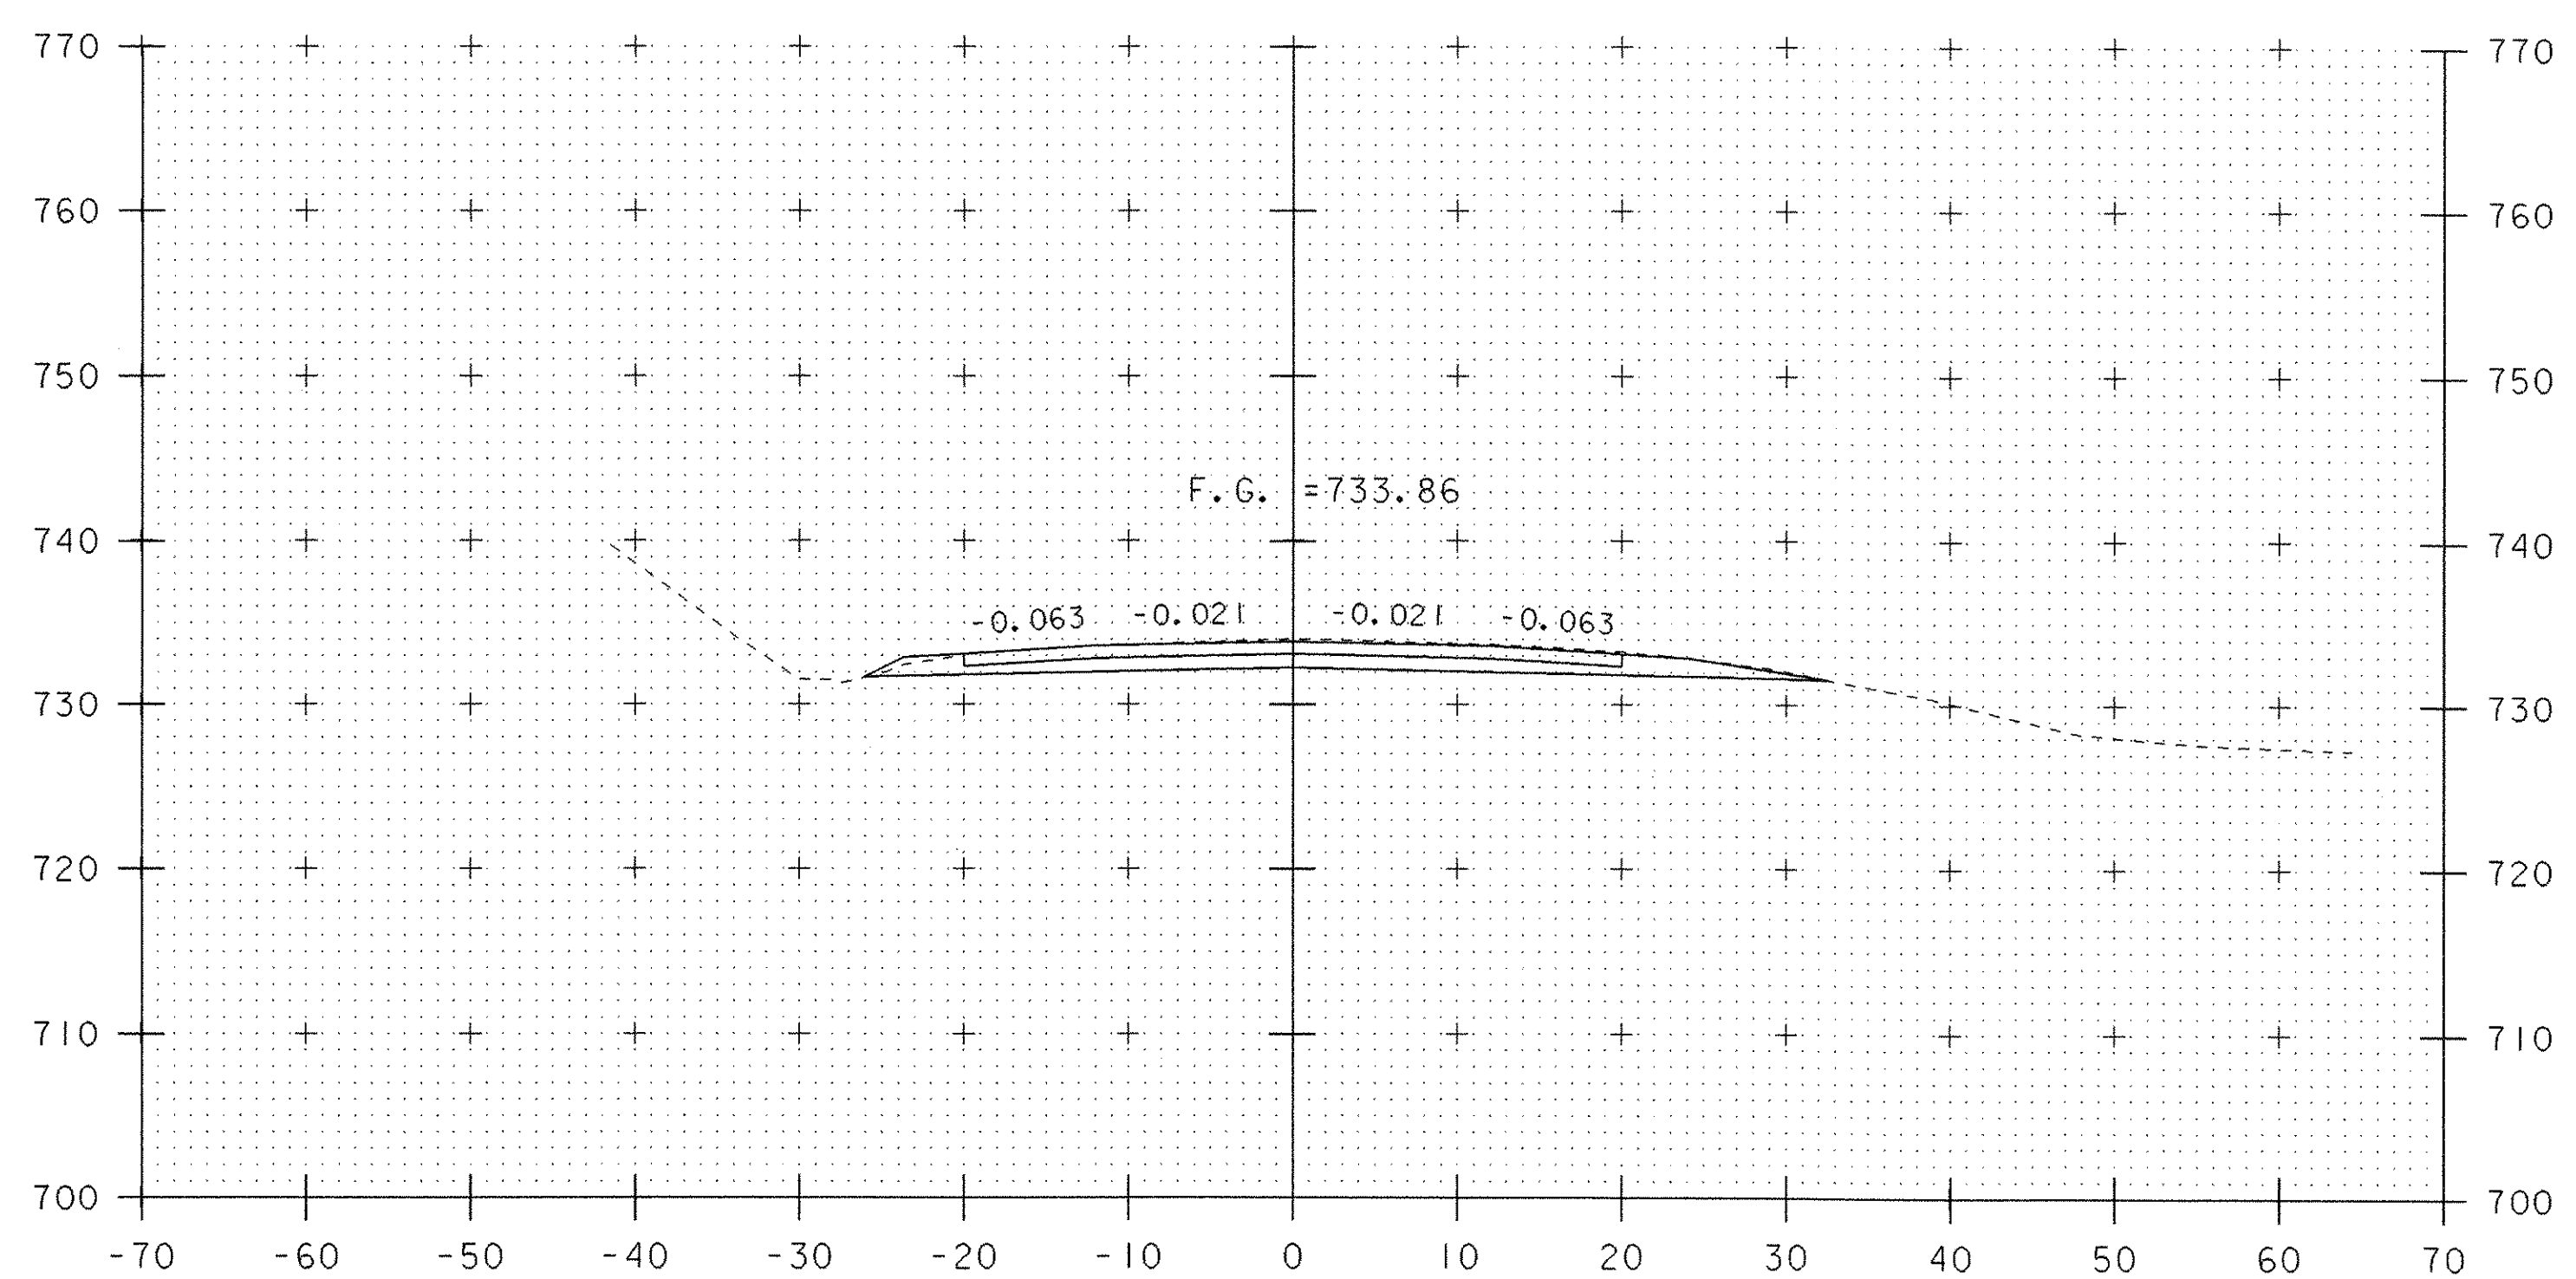

17+00

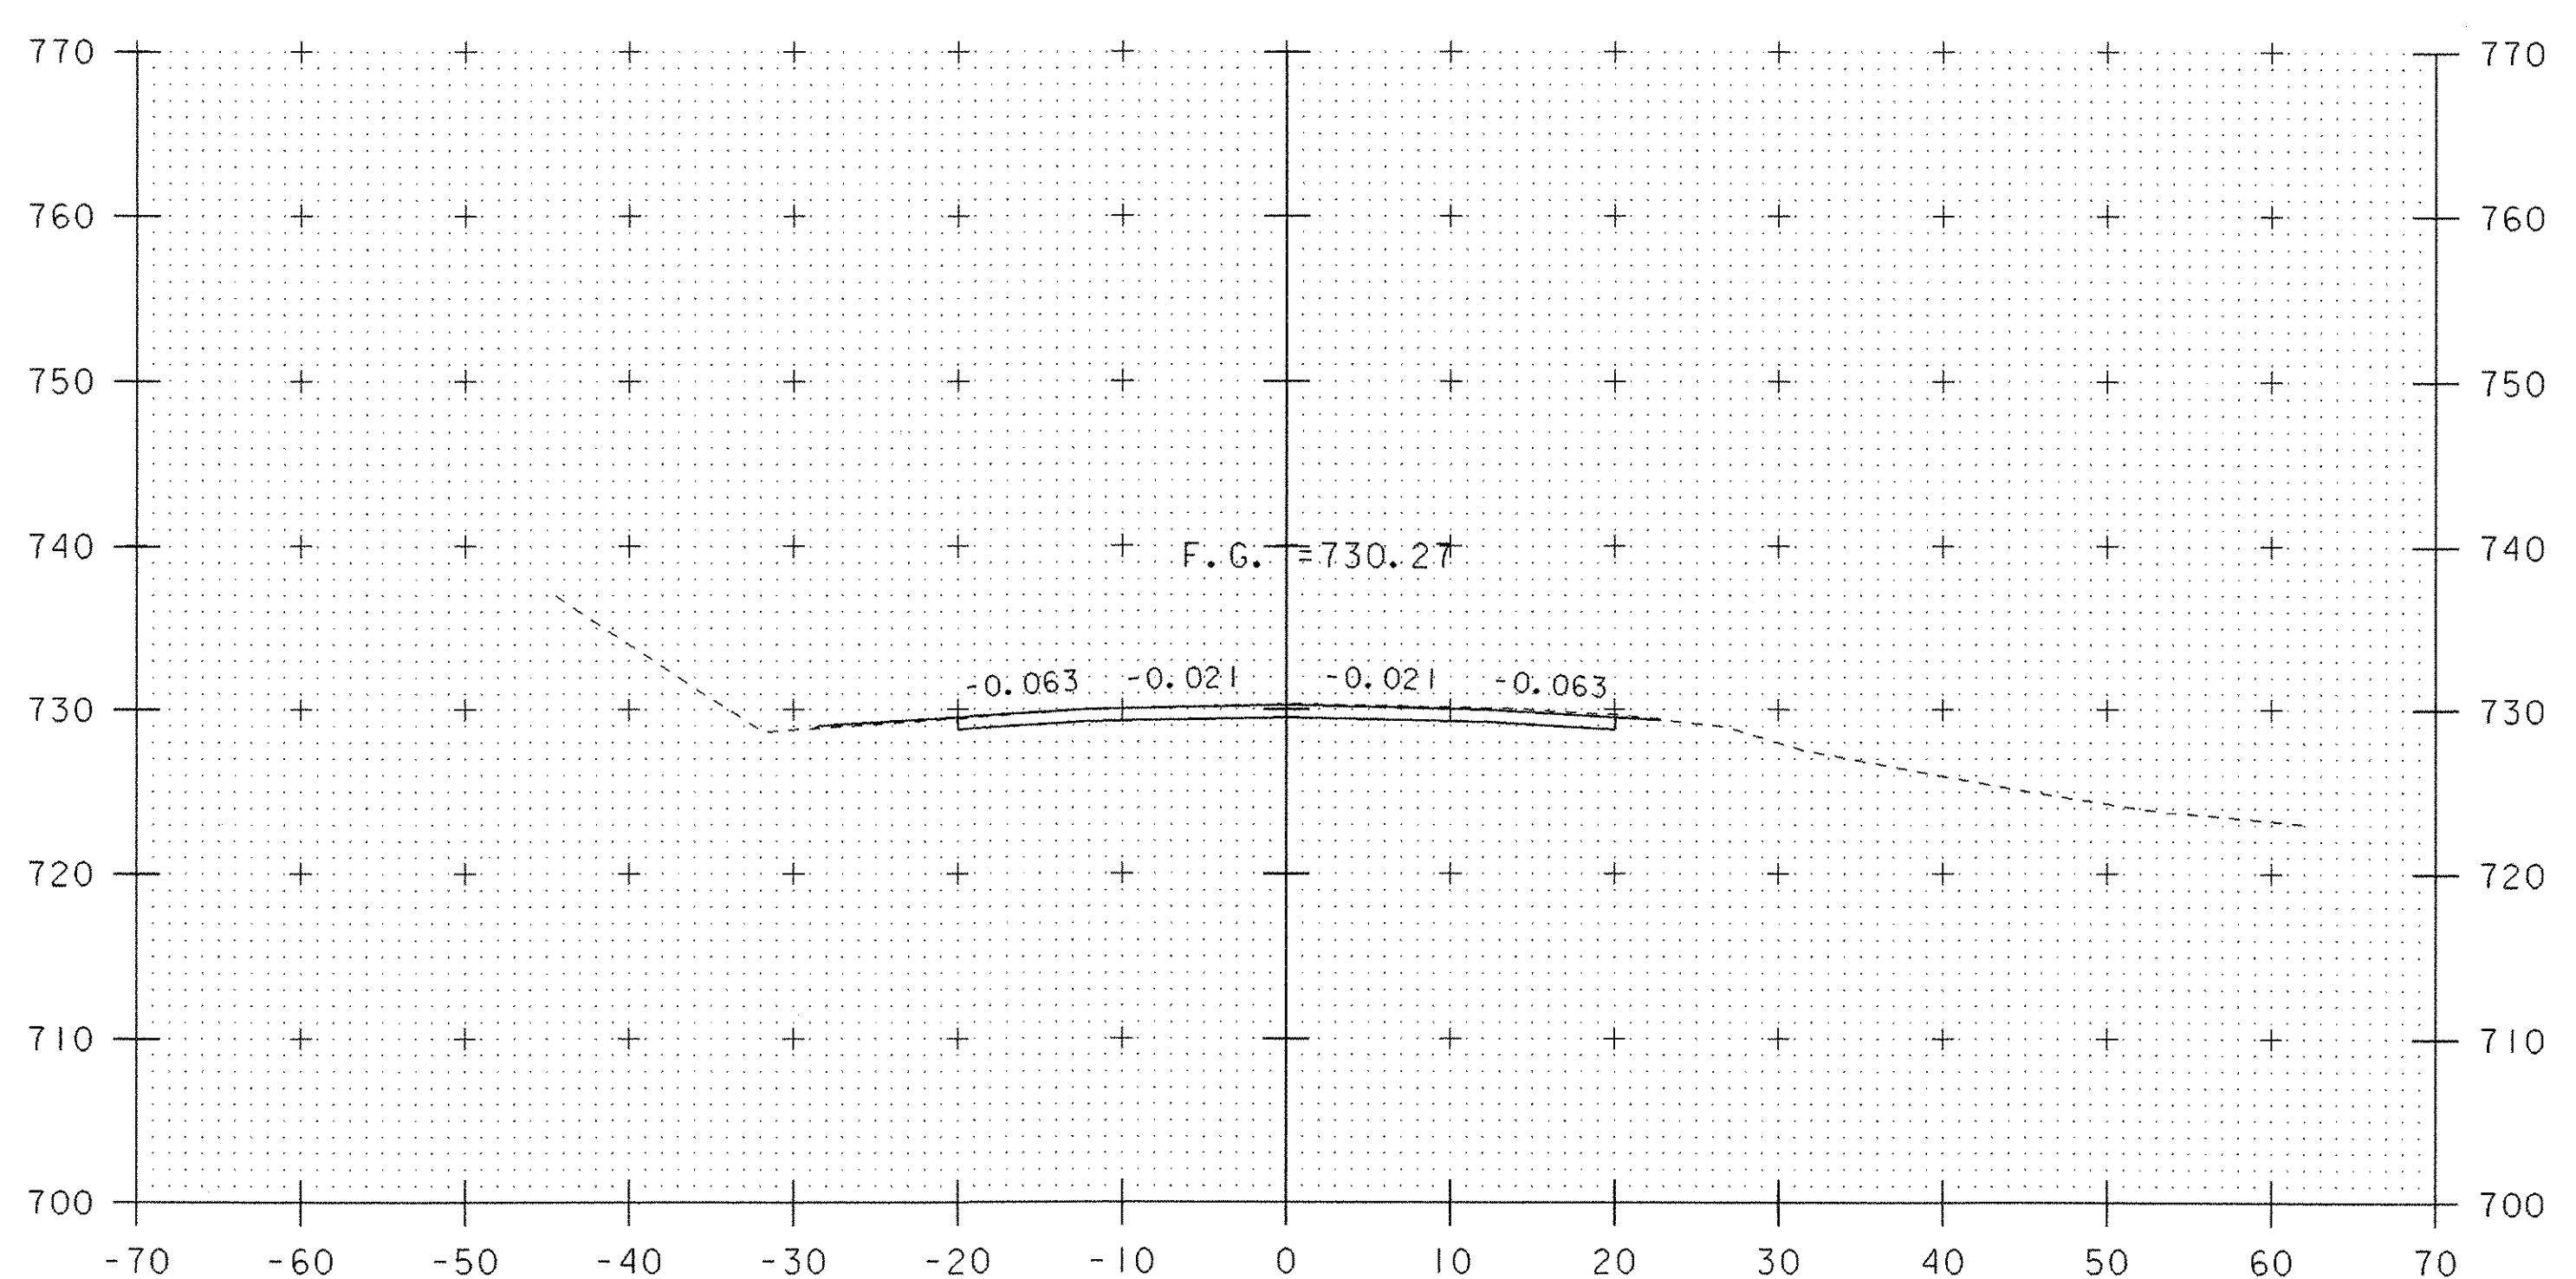

17+50

MAINLINE CROSS SECTIONS (6)



PROJECT NAME:	SPRINGFIELD	PLOT DATE:	21-MAY-2007
PROJECT NUMBER:	ST CULV (5)	DRAWN BY:	M. HALE
FILE NAME:	04c178\Structures\s04c178xsl.dgn	CHECKED BY:	D. PETERSON
PROJECT MANAGER:	R. R. WHITCOMB	SHEET	45 OF 52
DESIGNED BY:	J. PERRIGO		