



50+10

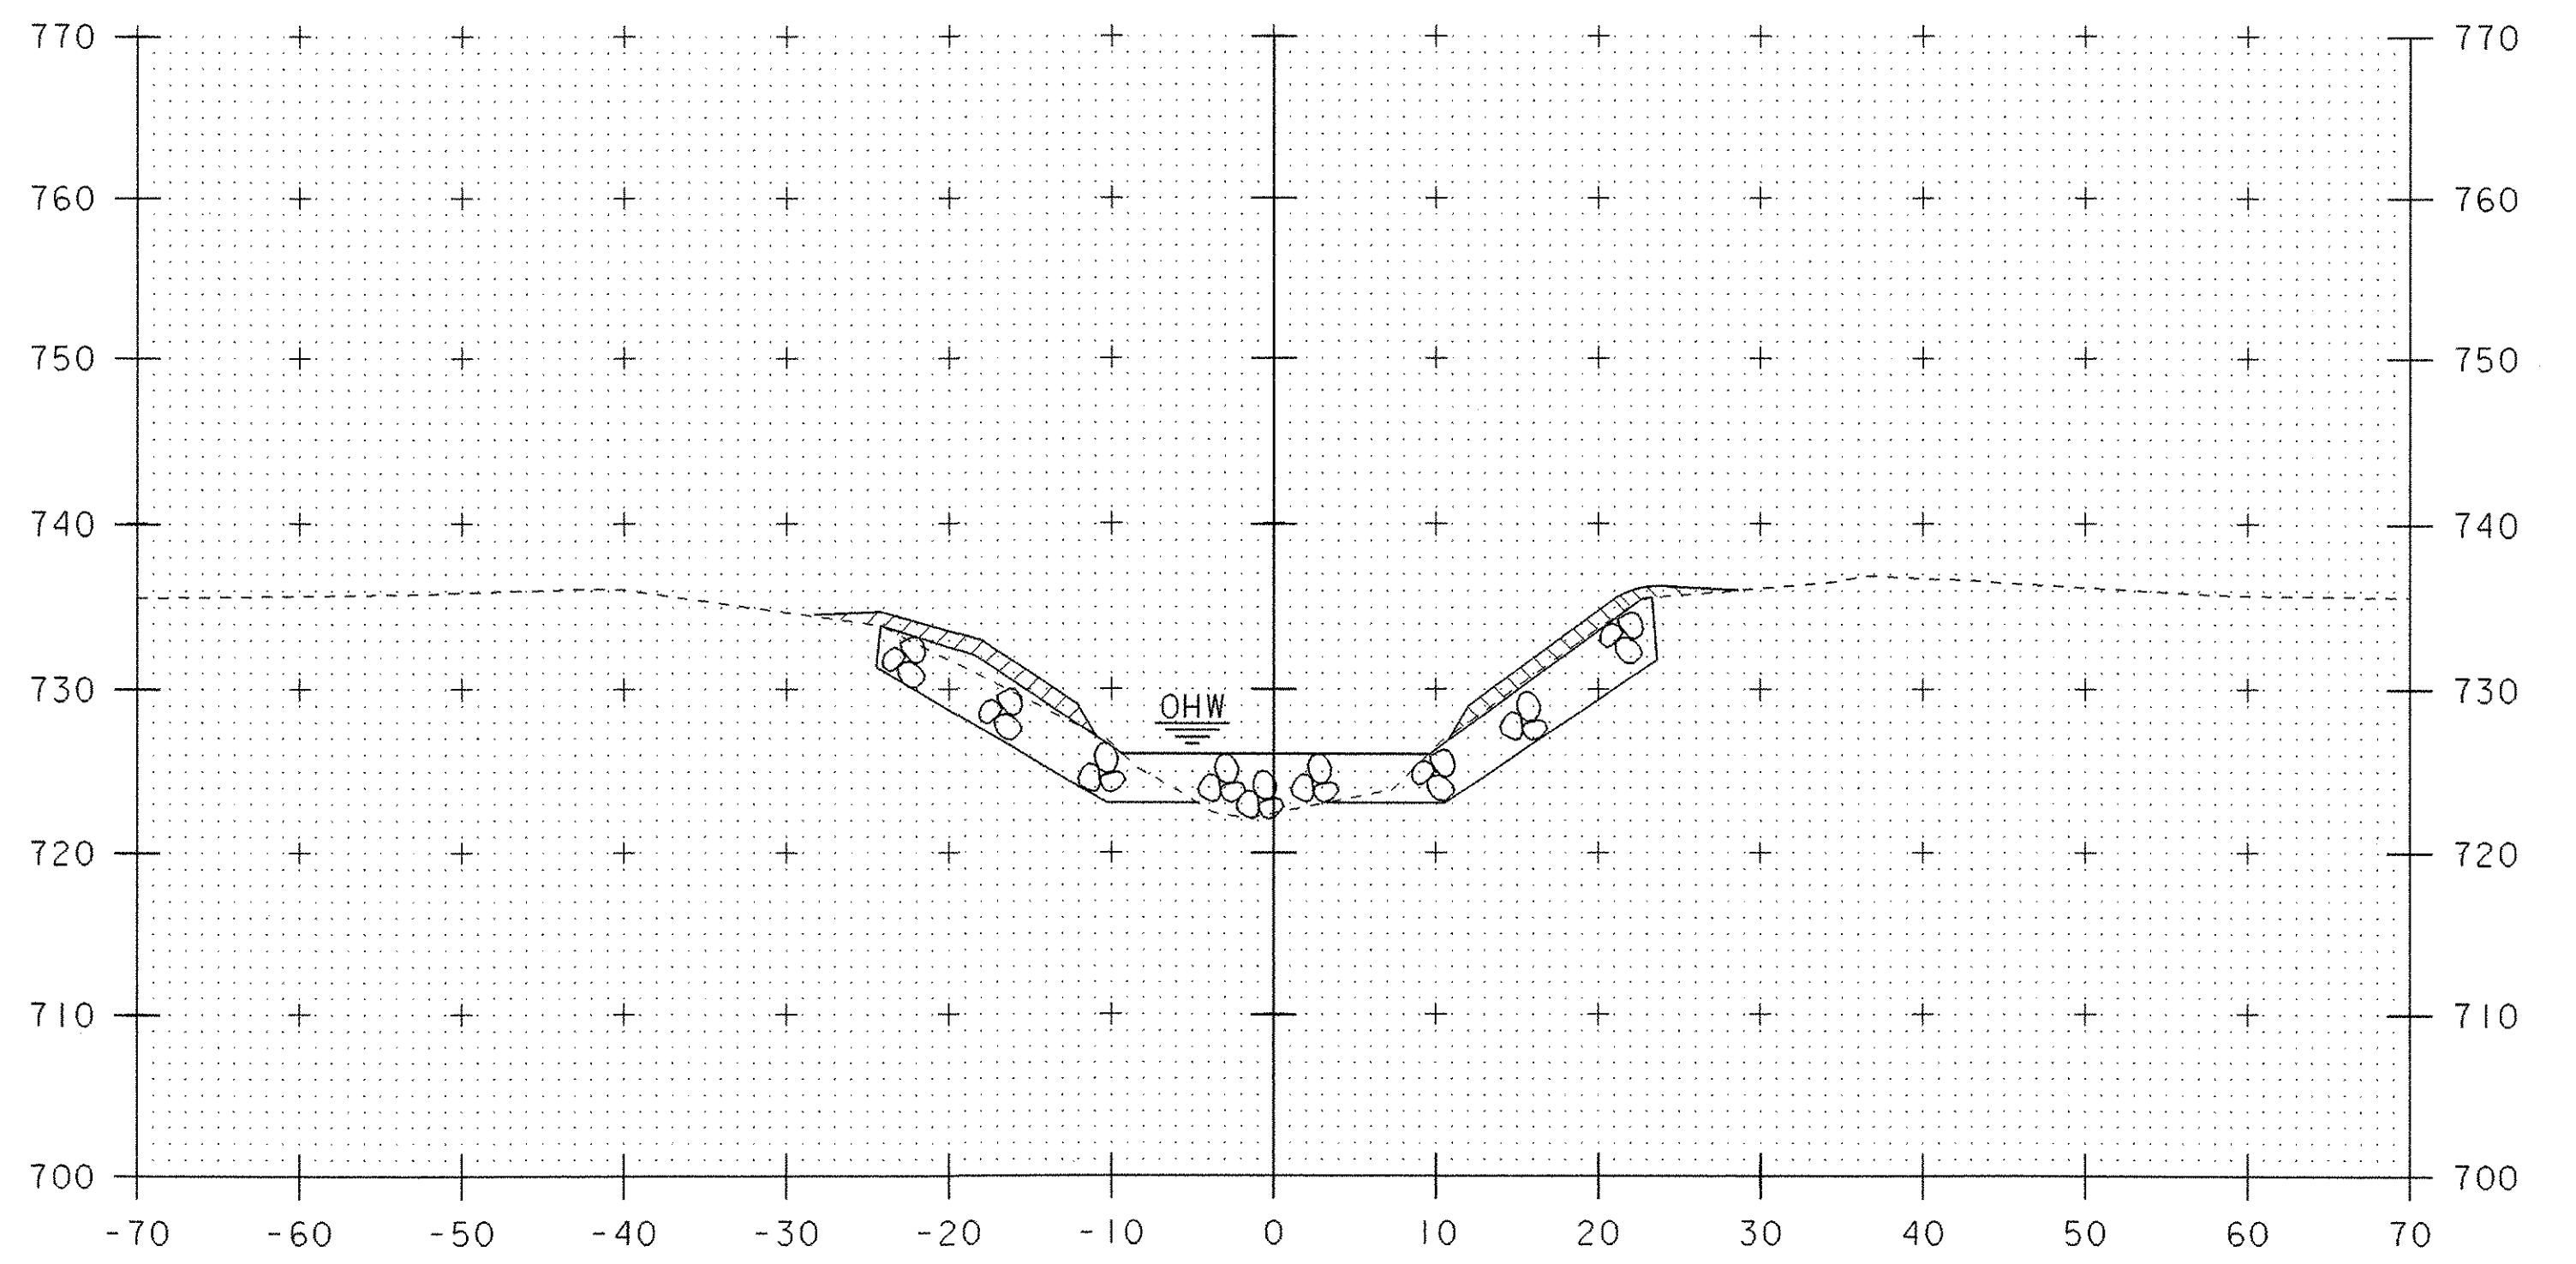


50+30

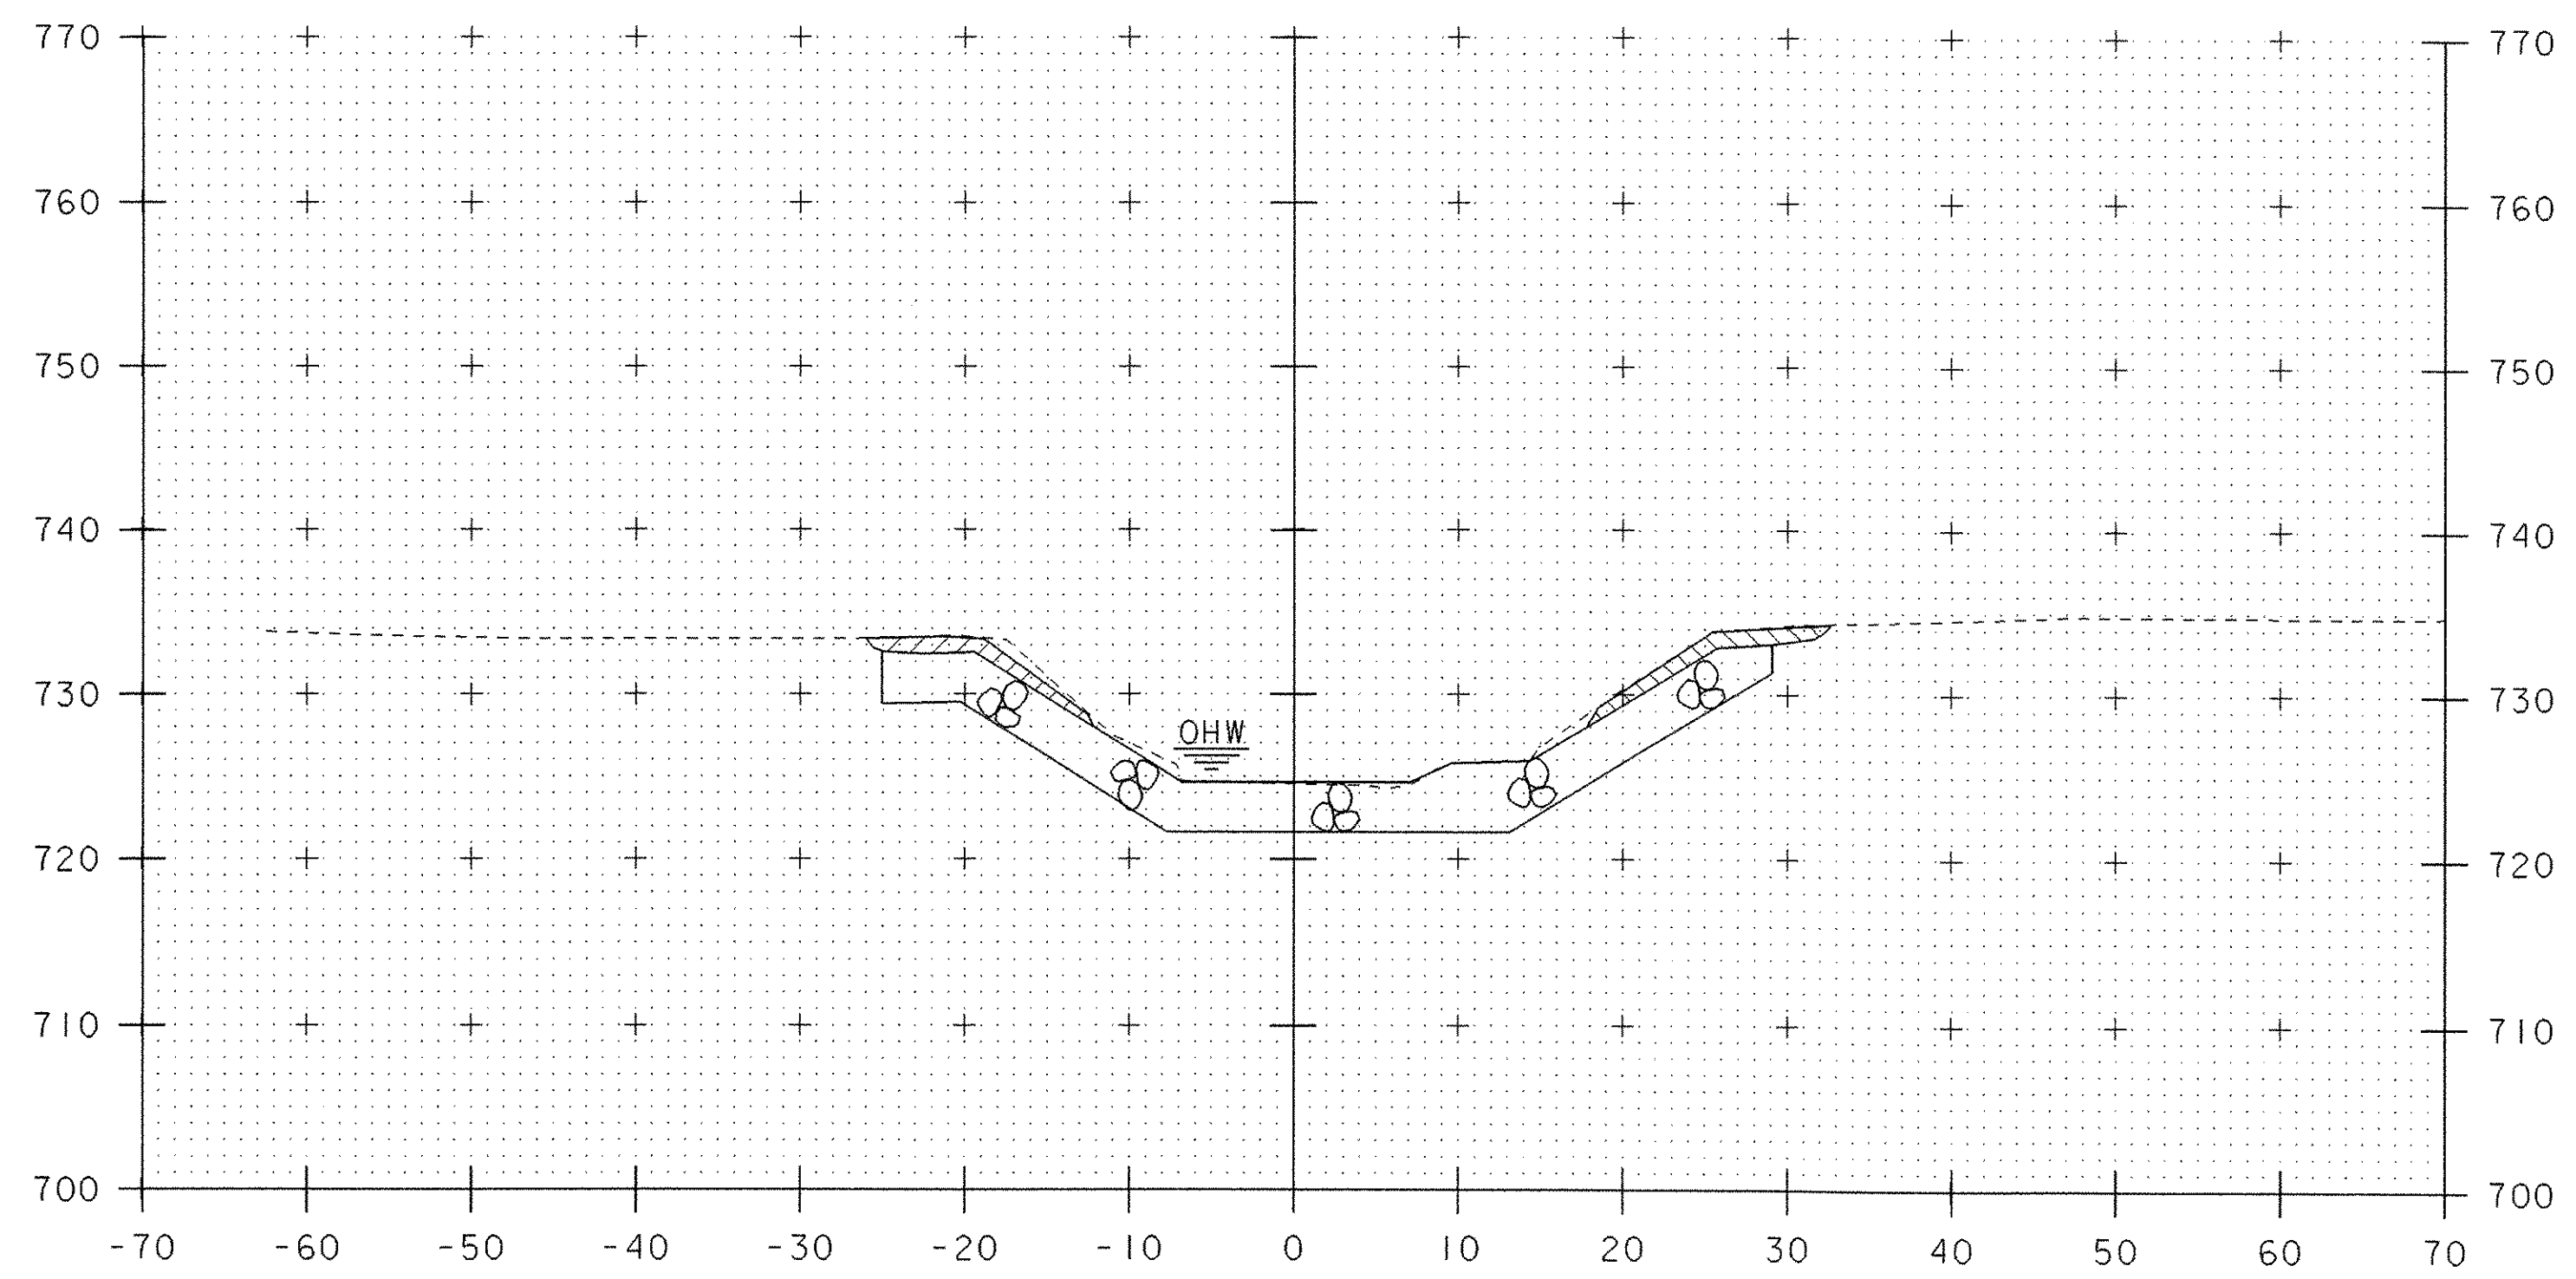


50+00

STA. 50+00.00
 BEGIN UNCL. CHAN. EXCAVATION
 GEOTEXTILE UNDER STONE FILL
 STONE FILL, TYPE III
 GRUBBING MATERIAL

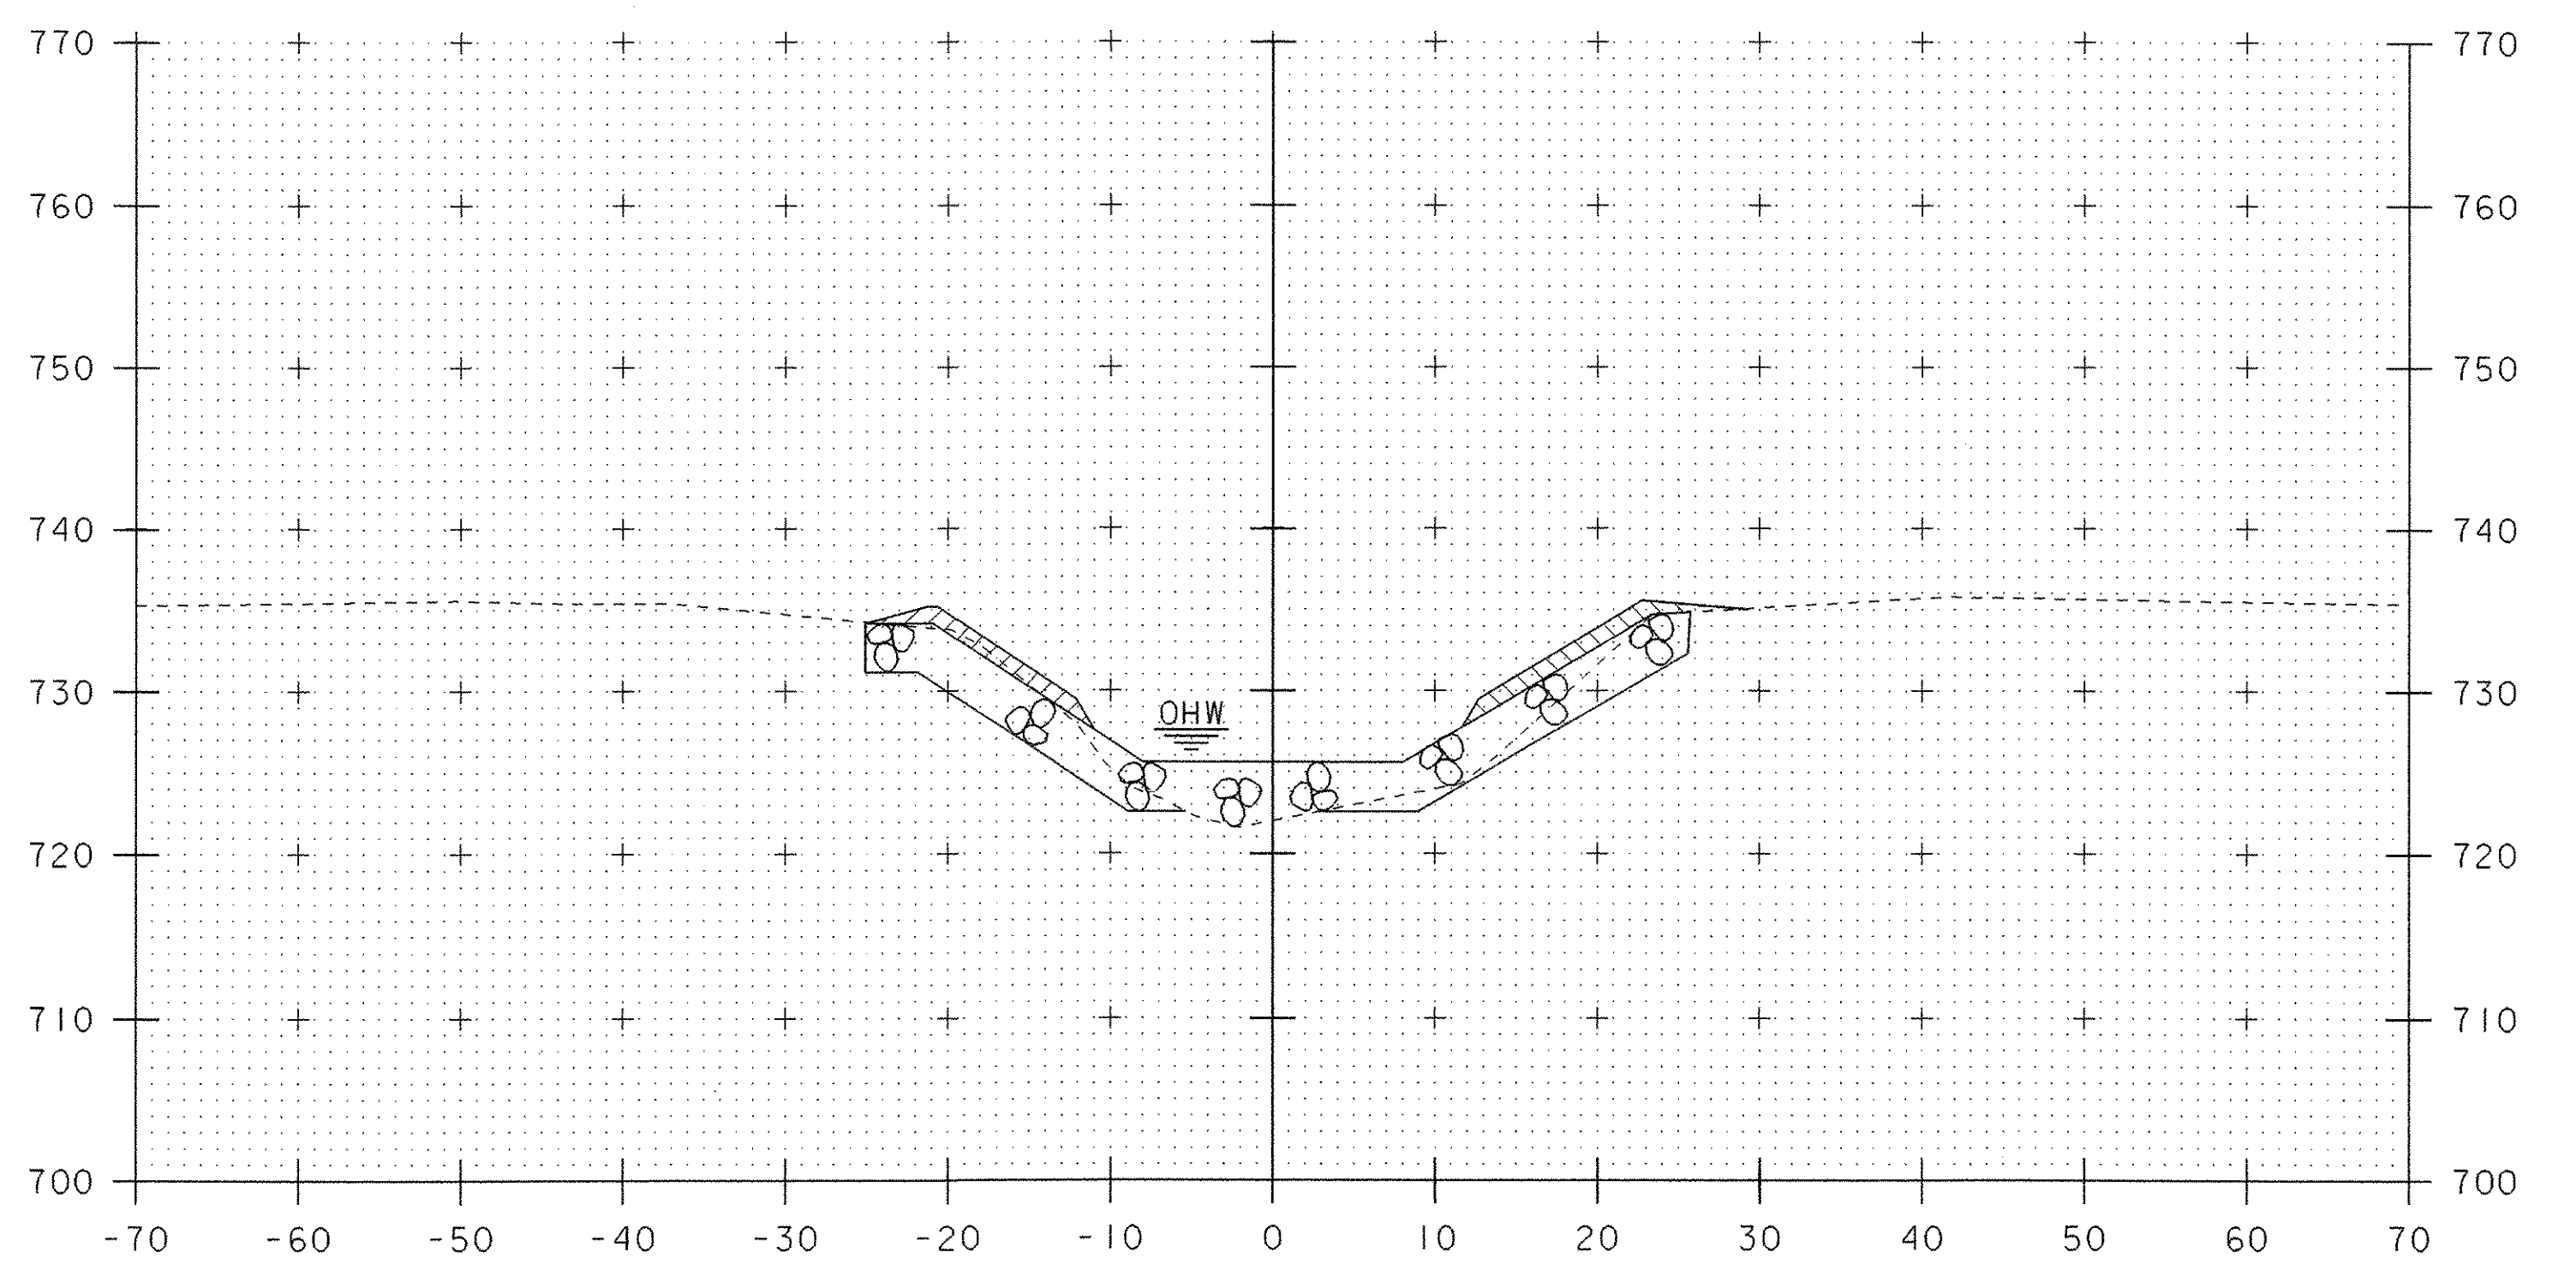

50+20

CHANNEL CROSS SECTIONS (1)

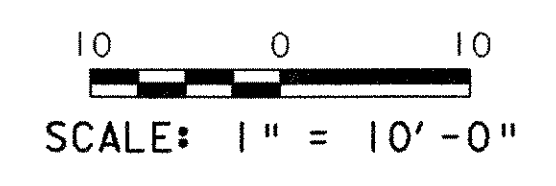

PROJECT NAME:	SPRINGFIELD	PLOT DATE:	21-MAY-2007
PROJECT NUMBER:	ST CULV (5)	DRAWN BY:	M. HALE
FILE NAME:	04c178\structures\s04c178xsl.dgn	CHECKED BY:	D. PETERSON
PROJECT MANAGER:	R. R. WHITCOMB	SHEET	47 OF 52
DESIGNED BY:	J. PERRIGO		
s04c178c01.i			