



51+70

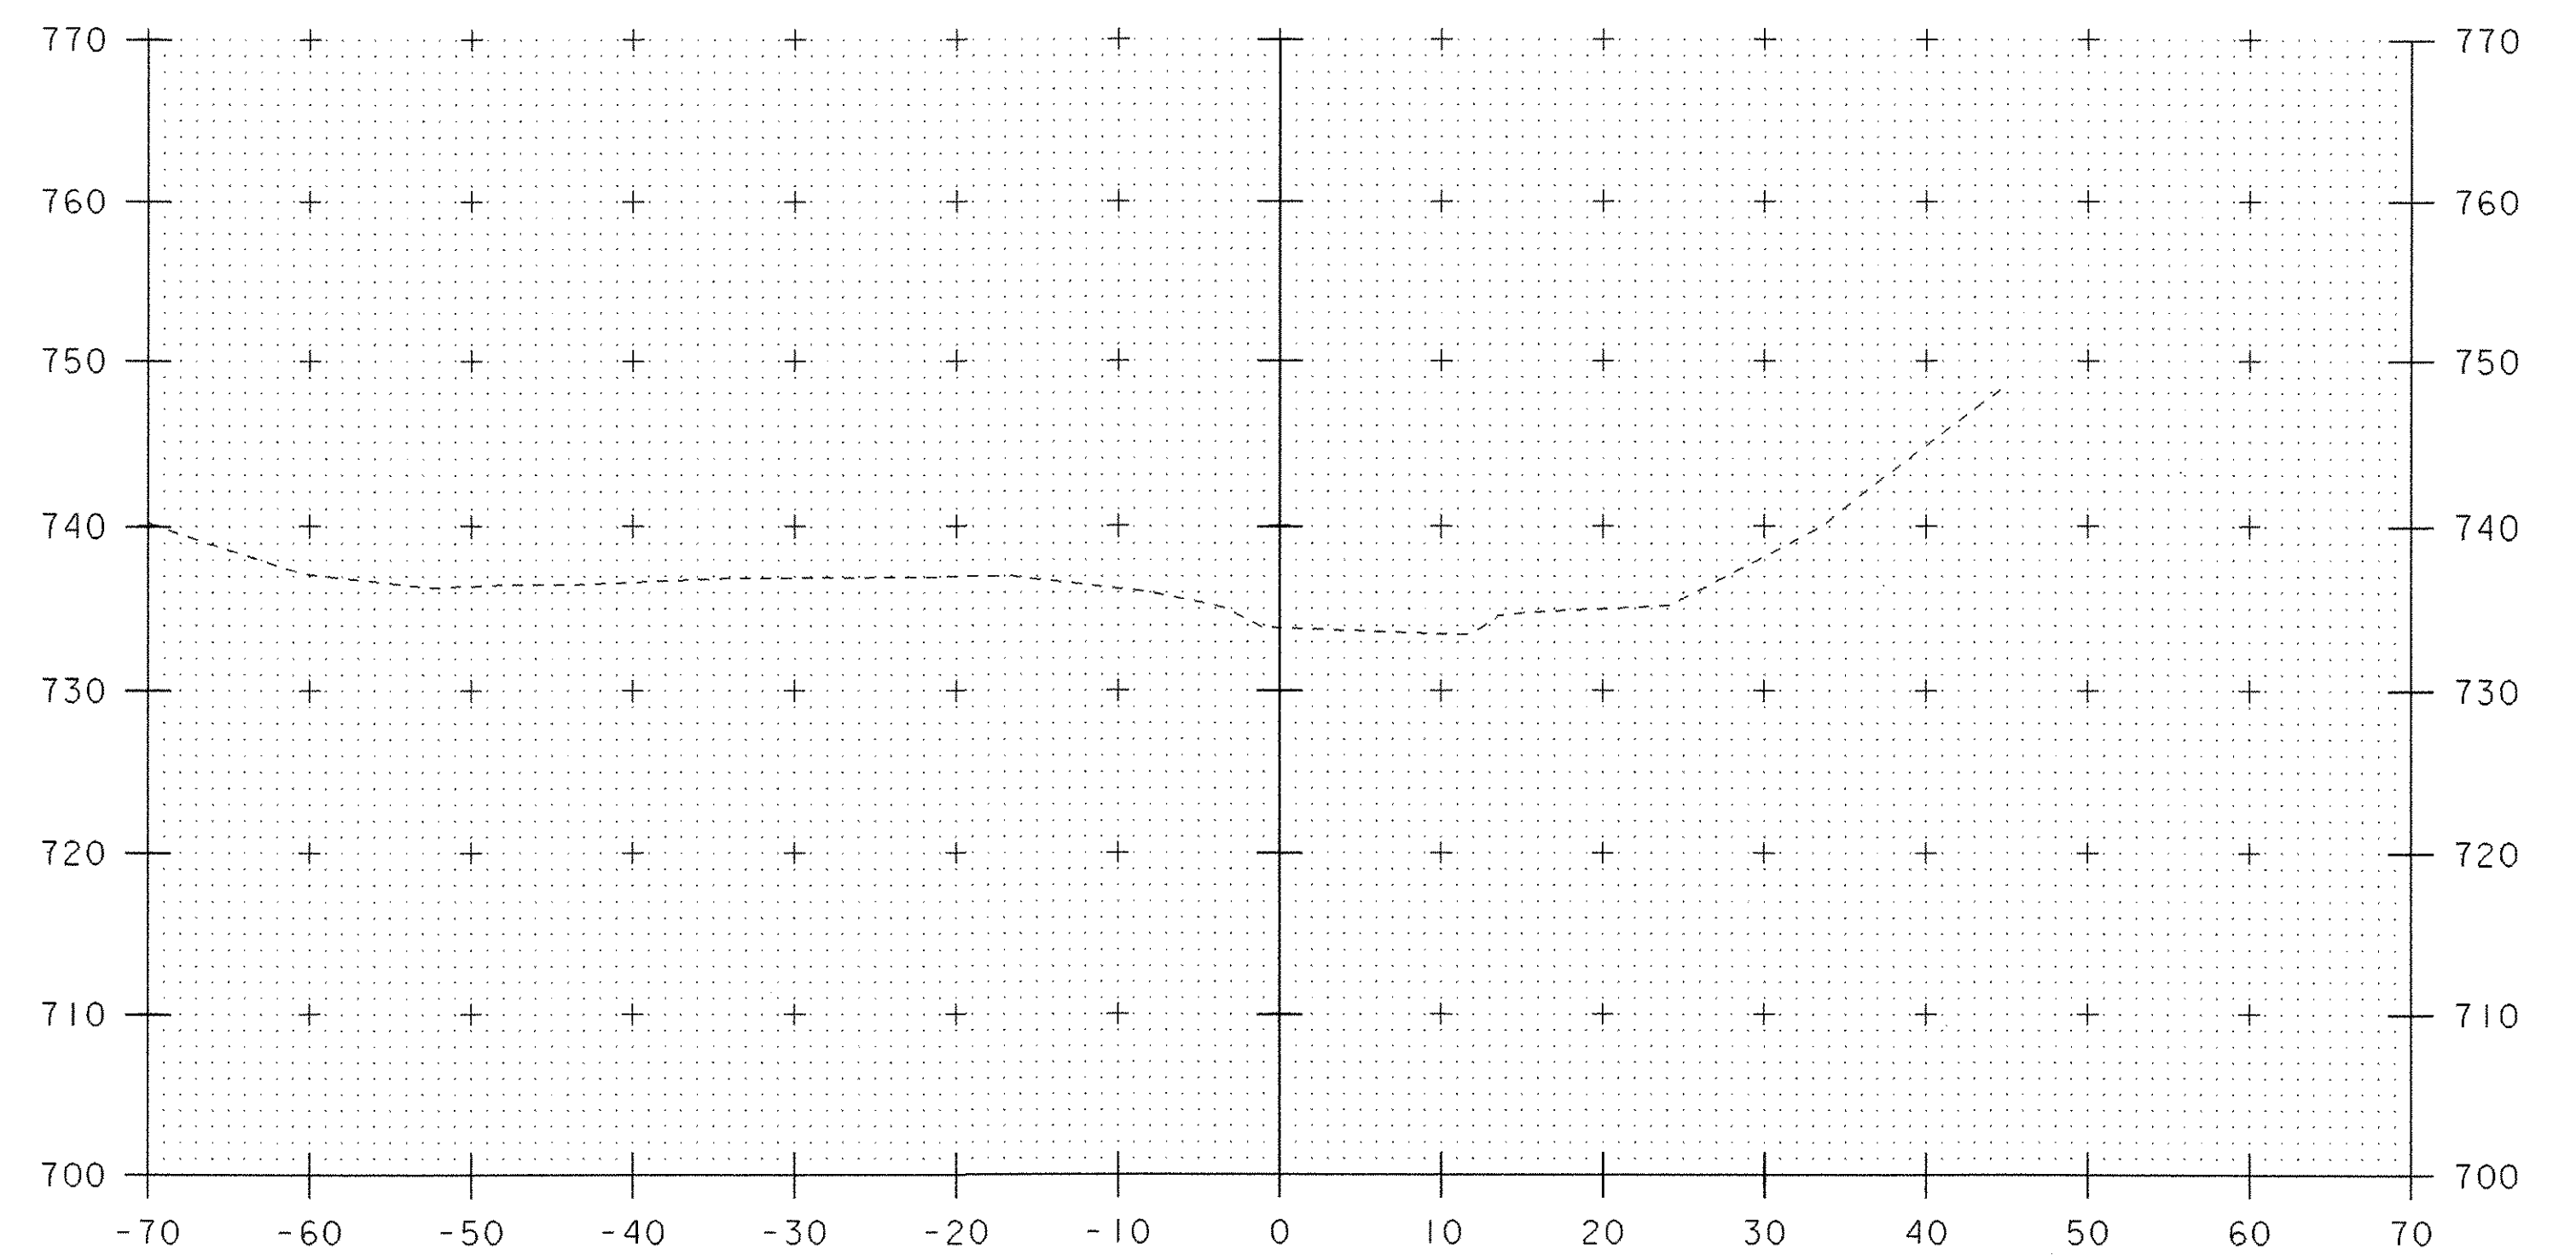


51+90

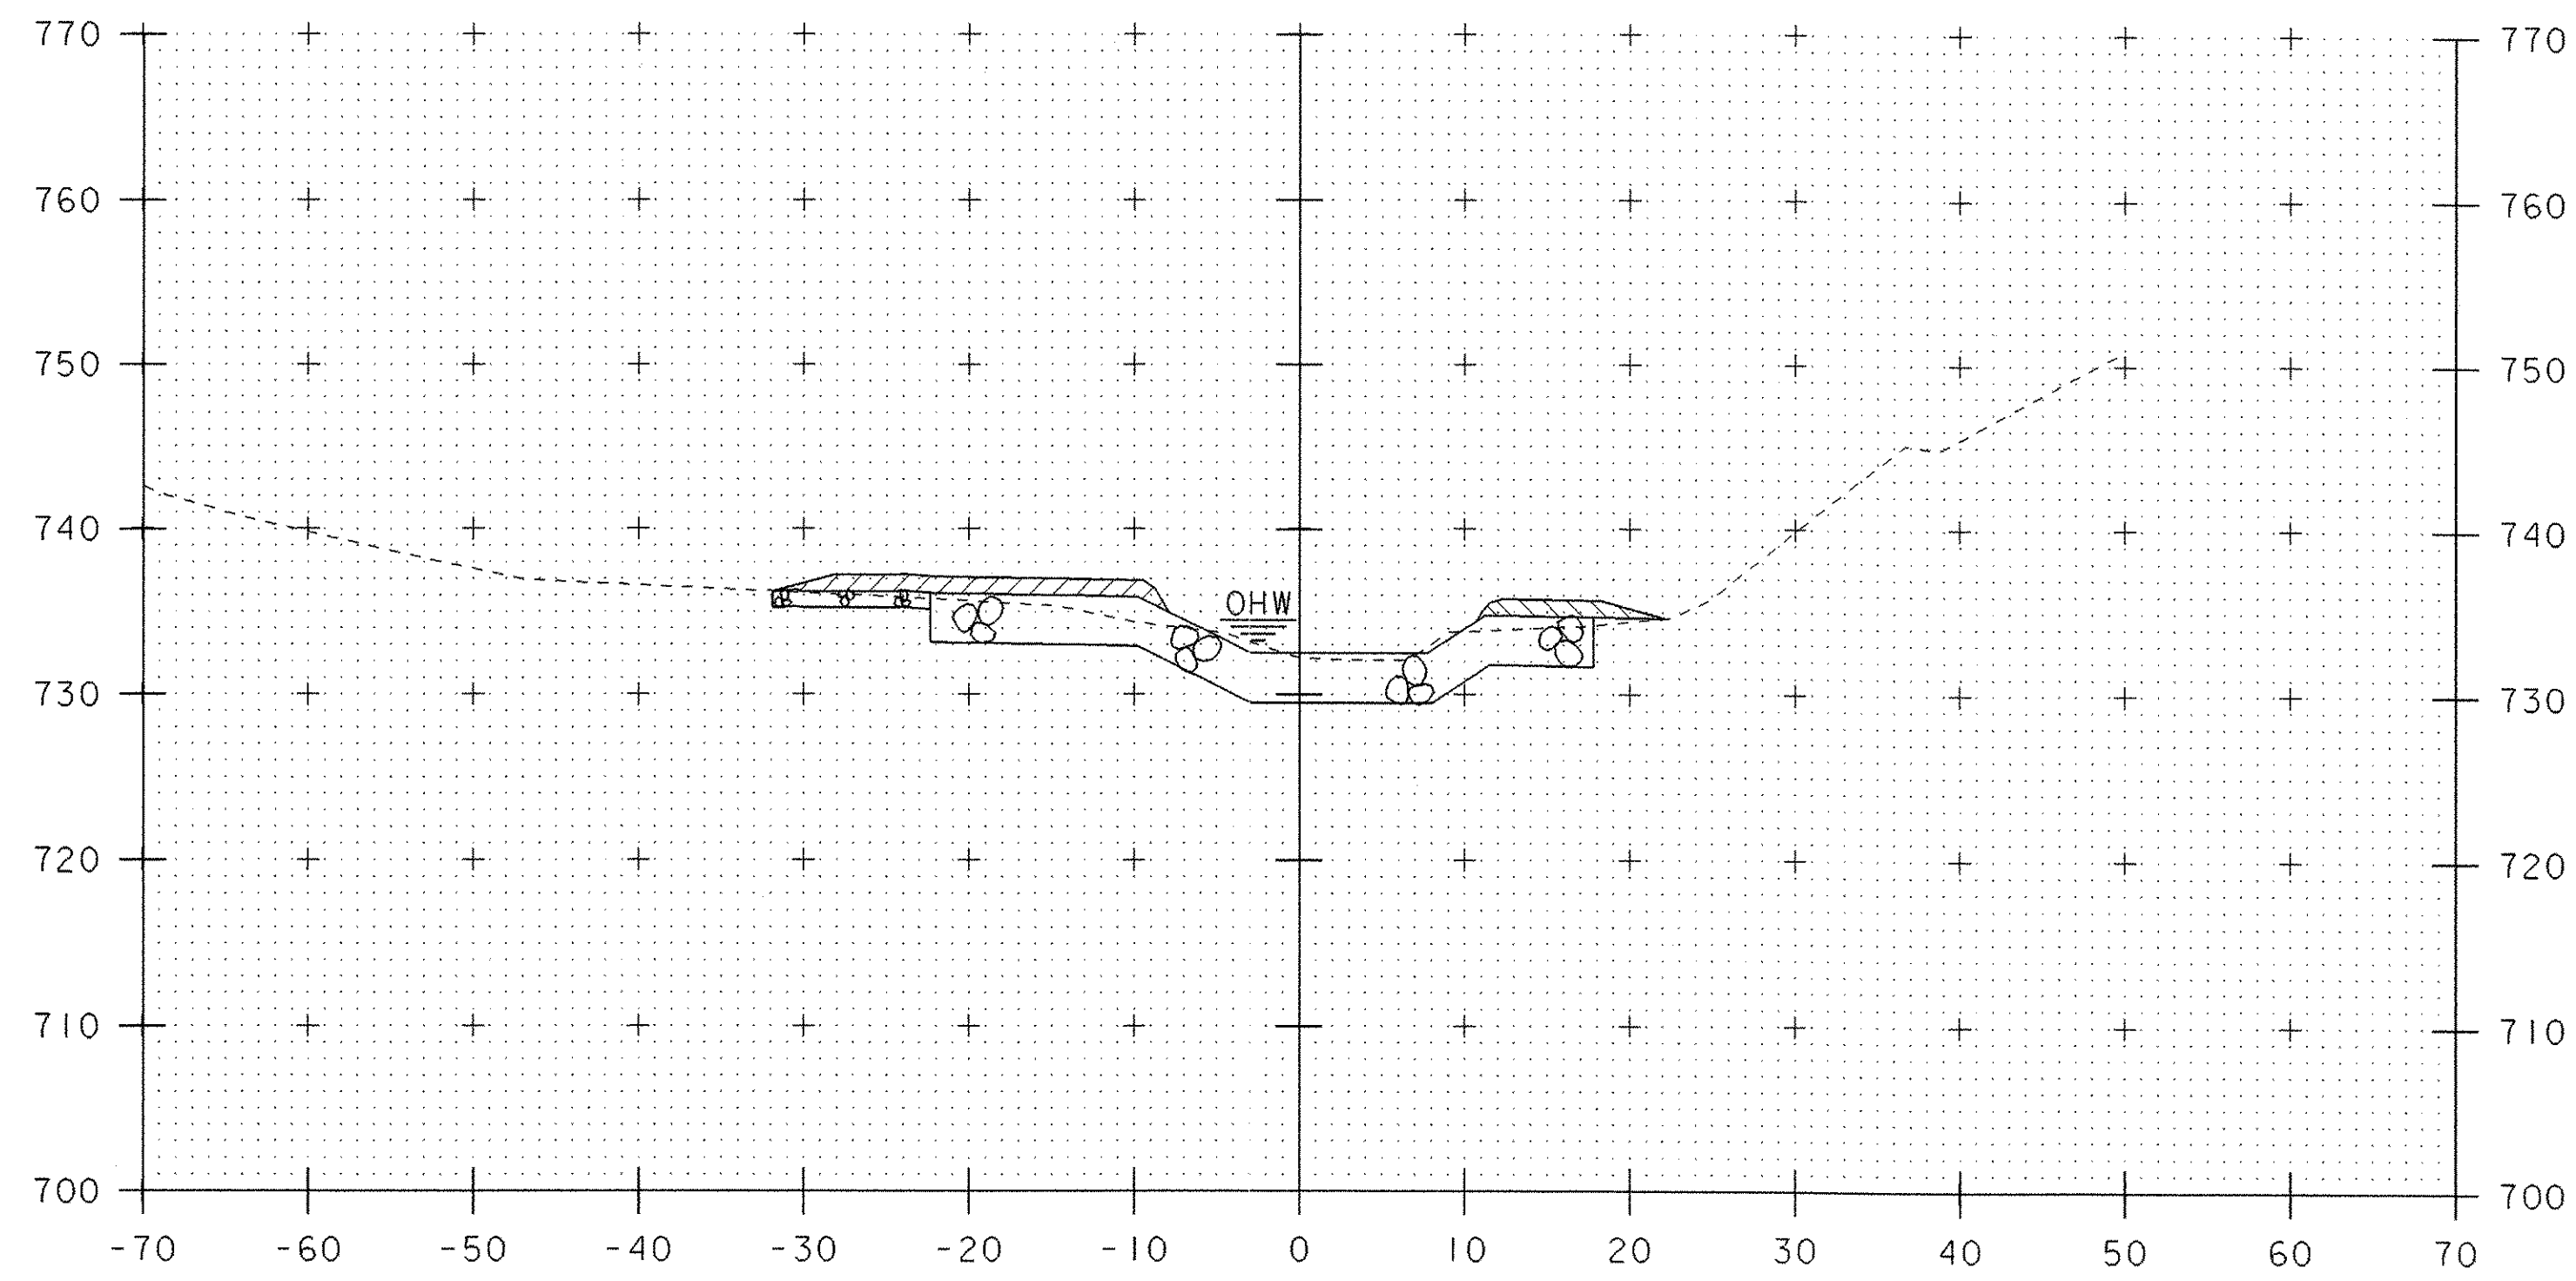

51+60

STA. 51+54.9 LT.  
 END STRUCTURE EXCAVATION  
 GRANULAR BACKFILL FOR STRUCTURES

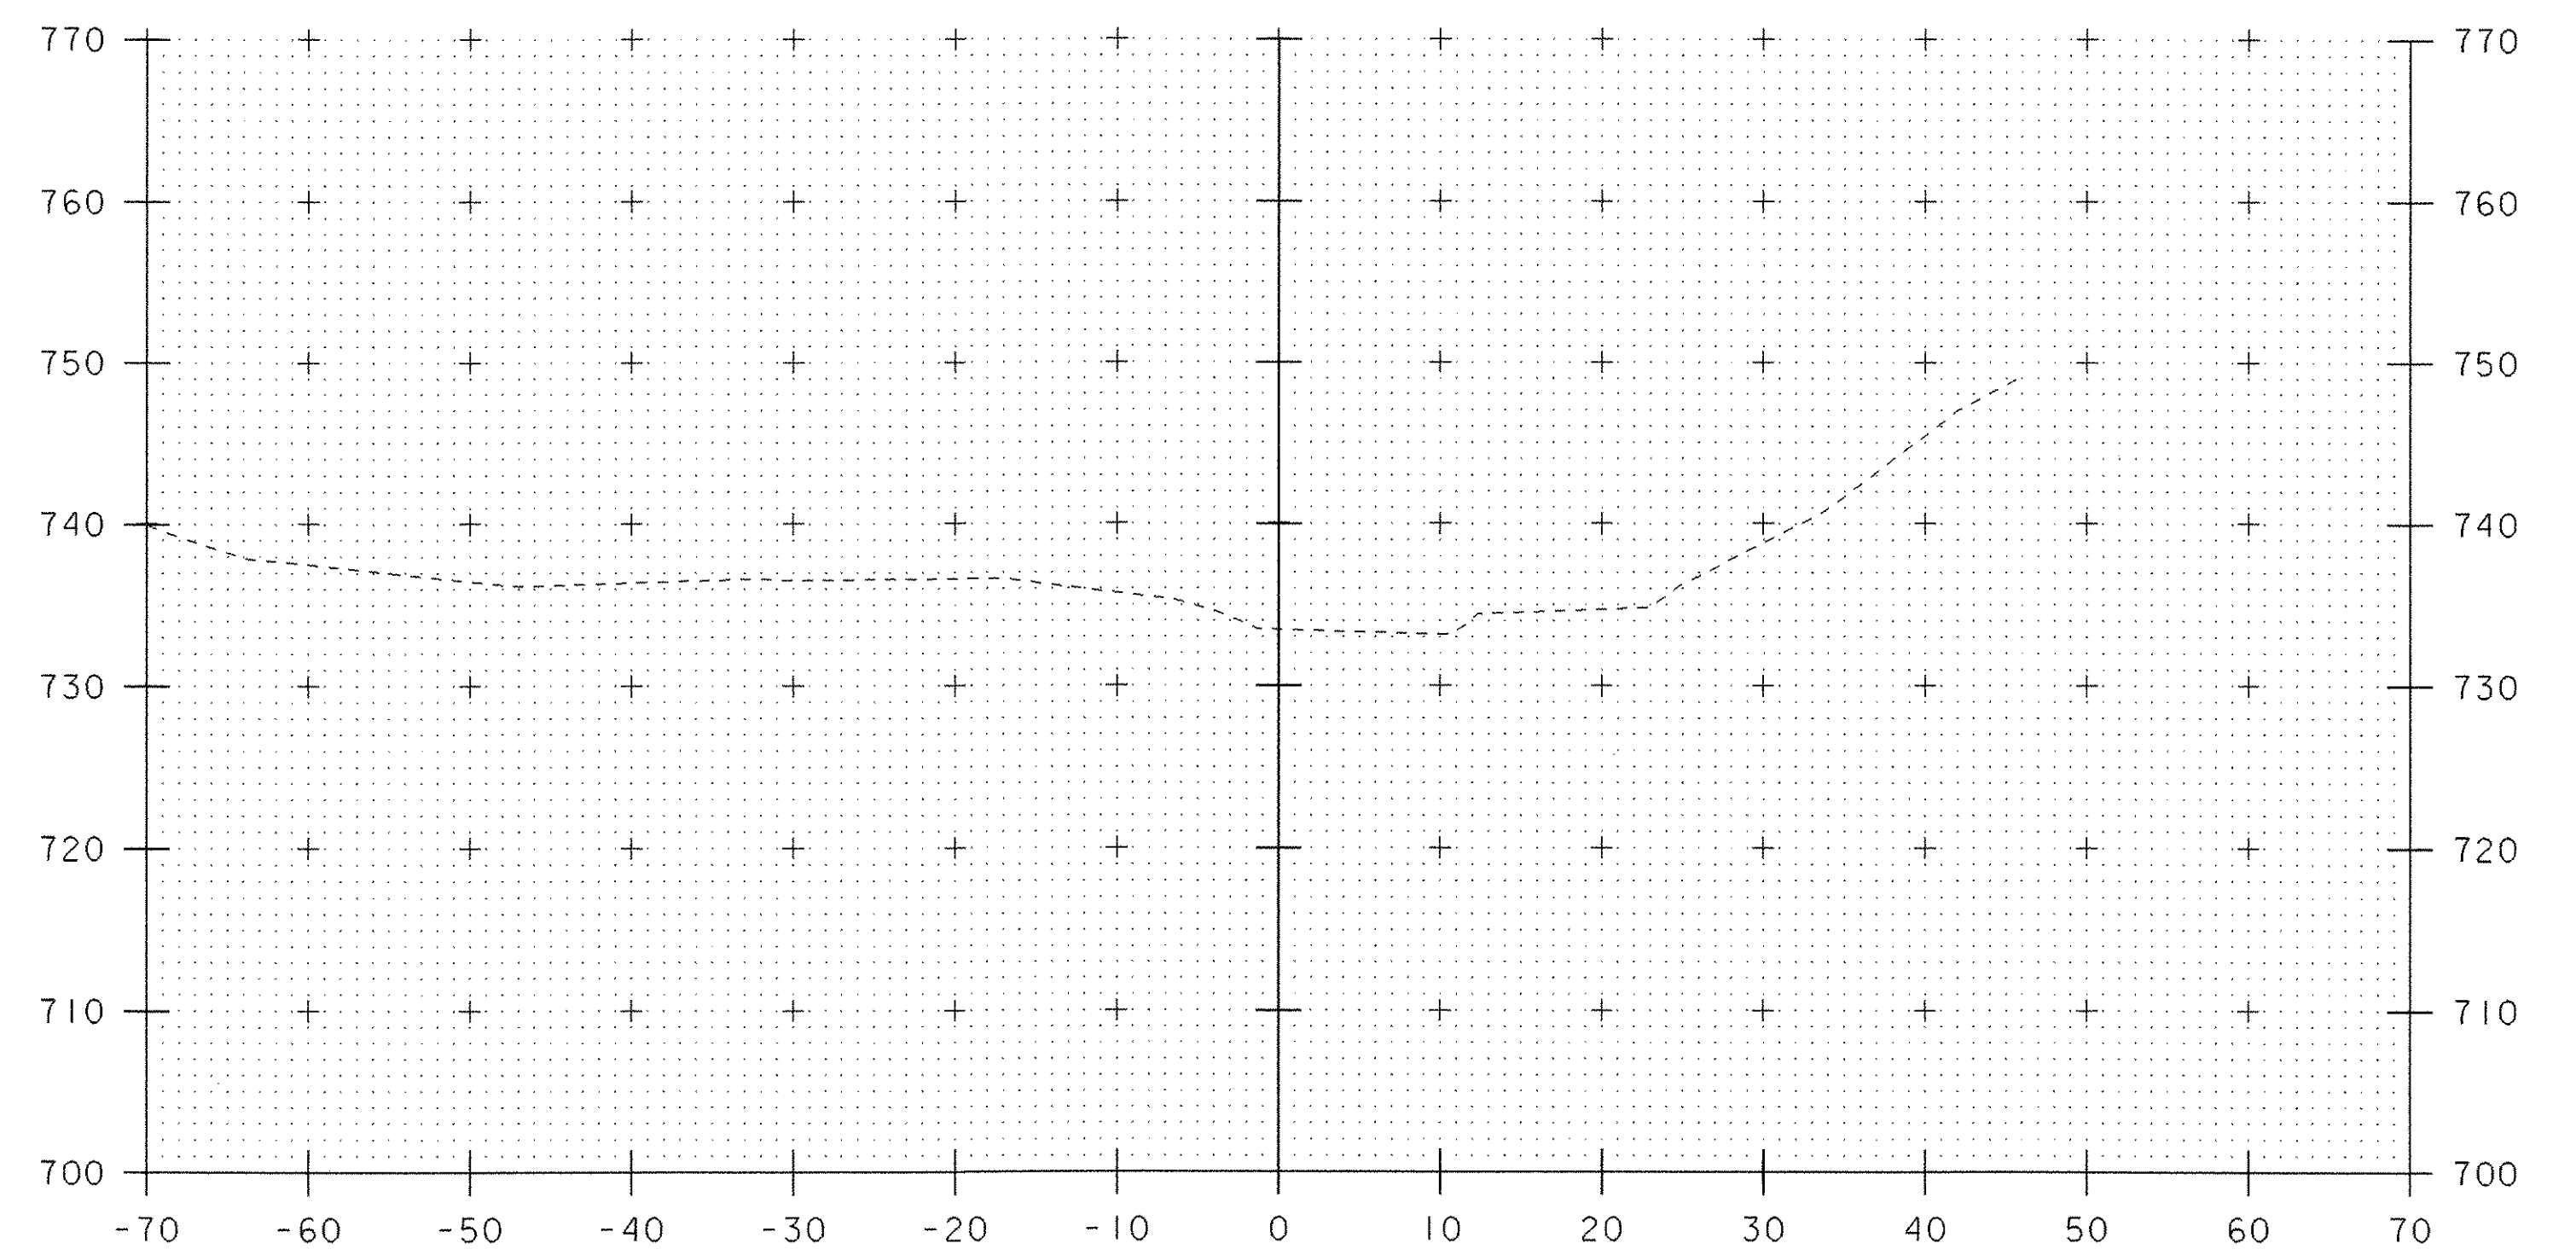

51+80

STA. 51+75.00  
 END UNCL. CHAN. EXCAVATION  
 GEOTEXTILE UNDER STONE FILL  
 STONE FILL, TYPE III  
 GRUBBING MATERIAL

10 0 10  
 SCALE: 1" = 10'-0"

CHANNEL CROSS SECTIONS (5)

PROJECT NAME:	SPRINGFIELD	PLOT DATE:	21-MAY-2007
PROJECT NUMBER:	ST CULV (5)	DRAWN BY:	M. HALE
FILE NAME:	04c178\Structures\s04c178xs1.dgn	CHECKED BY:	D. PETERSON
PROJECT MANAGER:	R. R. WHITCOMB	SHEET	51 OF 52
DESIGNED BY:	J. PERRIGO		
s04c178c05.i			