

INDEX OF SHEETS

SEE SHEET 2

RECORD PLANS

CONTRACTOR G W TATRO CONSTRUCTION, INC. - JEFFERSONVILLE, VT
 RESIDENT ENGINEER RAY HAYES
 CONSTRUCTION BEGAN APRIL 17, 2007
 CONSTRUCTION COMPLETE JUNE 12, 2007
 RECORD PLANS BY RAY HAYES & C. PIERCE

I HEREBY CERTIFY THAT ALL THE CONSTRUCTION REQUIRED BY THIS SET OF DRAWINGS HAS BEEN ACCOMPLISHED AS INDICATED HEREIN

BY [Signature] For Ray Hayes RESIDENT ENGINEER
 DATE 7/26/2010


NOTE Any further information concerning final quantities, amounts or other details relative to this project may be found at Central Files in the electronic archives

TRAFFIC DATA

VT 120		VT 236	
2006 ADT = 790	2026 ADT = 1175	2006 ADT = 440	2026 ADT = 655
2006 DHV = 110	2026 DHV = 165	2006 DHV = 65	2026 DHV = 95
2006 ADTT = 24	2026 ADTT = 35	2006 ADTT = 13	2026 ADTT = 20
%T = 3%		%T = 3%	
%D = 50%		%D = 50%	
V = 35 MPH		V = 35 MPH	

2006-2026 (20 YEAR) 18K ESAL = N/A
 2006-2046 URBAN MINOR ARTERIAL (40 YEAR) 18K ESAL = N/A





STATE OF VERMONT
 AGENCY OF TRANSPORTATION

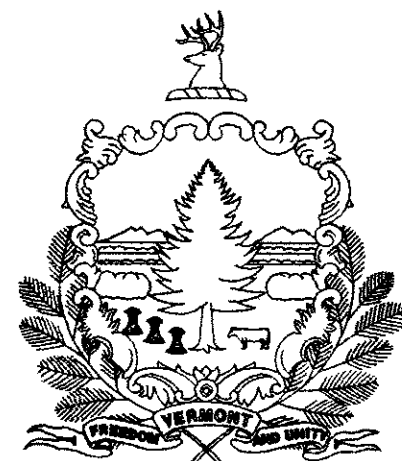

PROPOSED IMPROVEMENT
 TOWN OF FRANKLIN
 COUNTY OF FRANKLIN
 VERMONT ROUTES 120 & 236
 (MAJOR COLLECTOR)

PROJECT LOCATION:
 AT THE INTERSECTION OF VERMONT ROUTE 120 AND
 VERMONT ROUTE 236, 0.2 MILES SOUTH OF EAST FRANKLIN
 LENGTH OF ROADWAY = 200 FT

PROJECT DESCRIPTION:
 IMPROVEMENT OF INTERSECTIONS GEOMETRY AND SIGHT
 DISTANCE AT INTERSECTION OF VERMONT ROUTE 120 AND
 VERMONT ROUTE 236

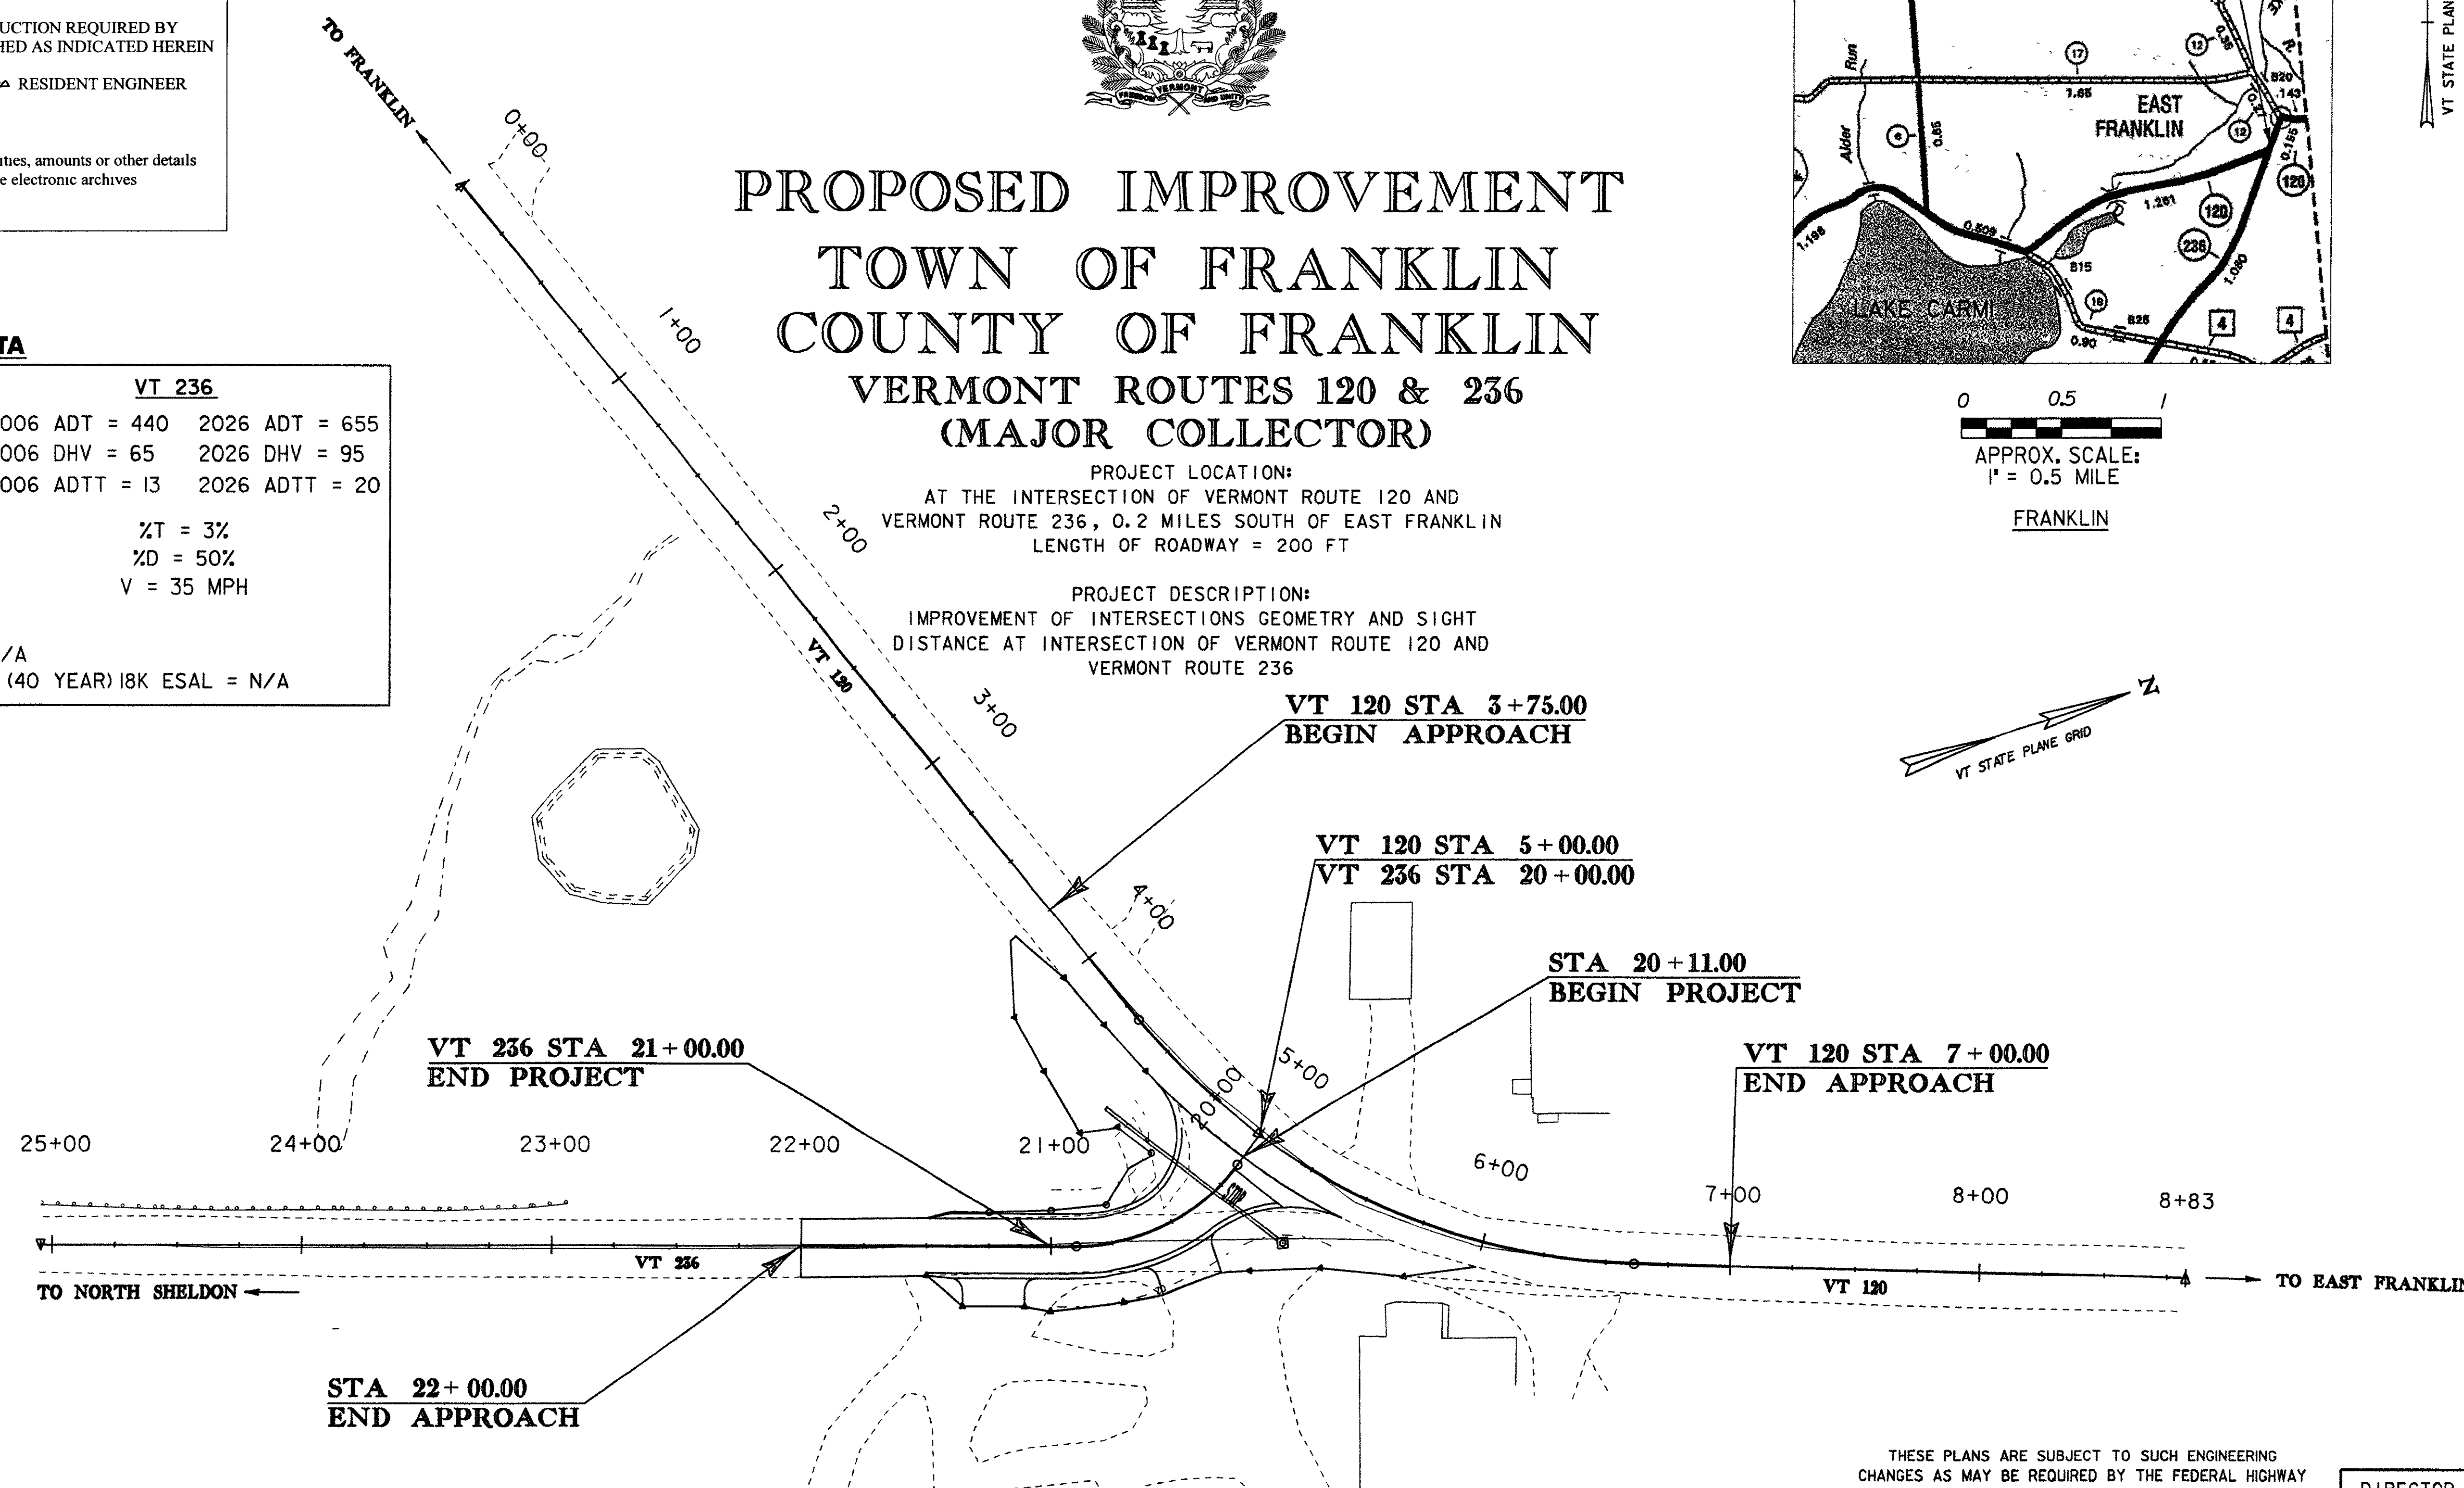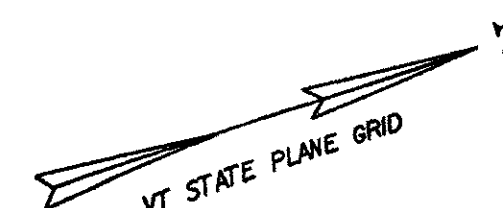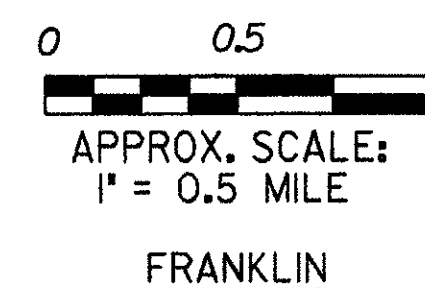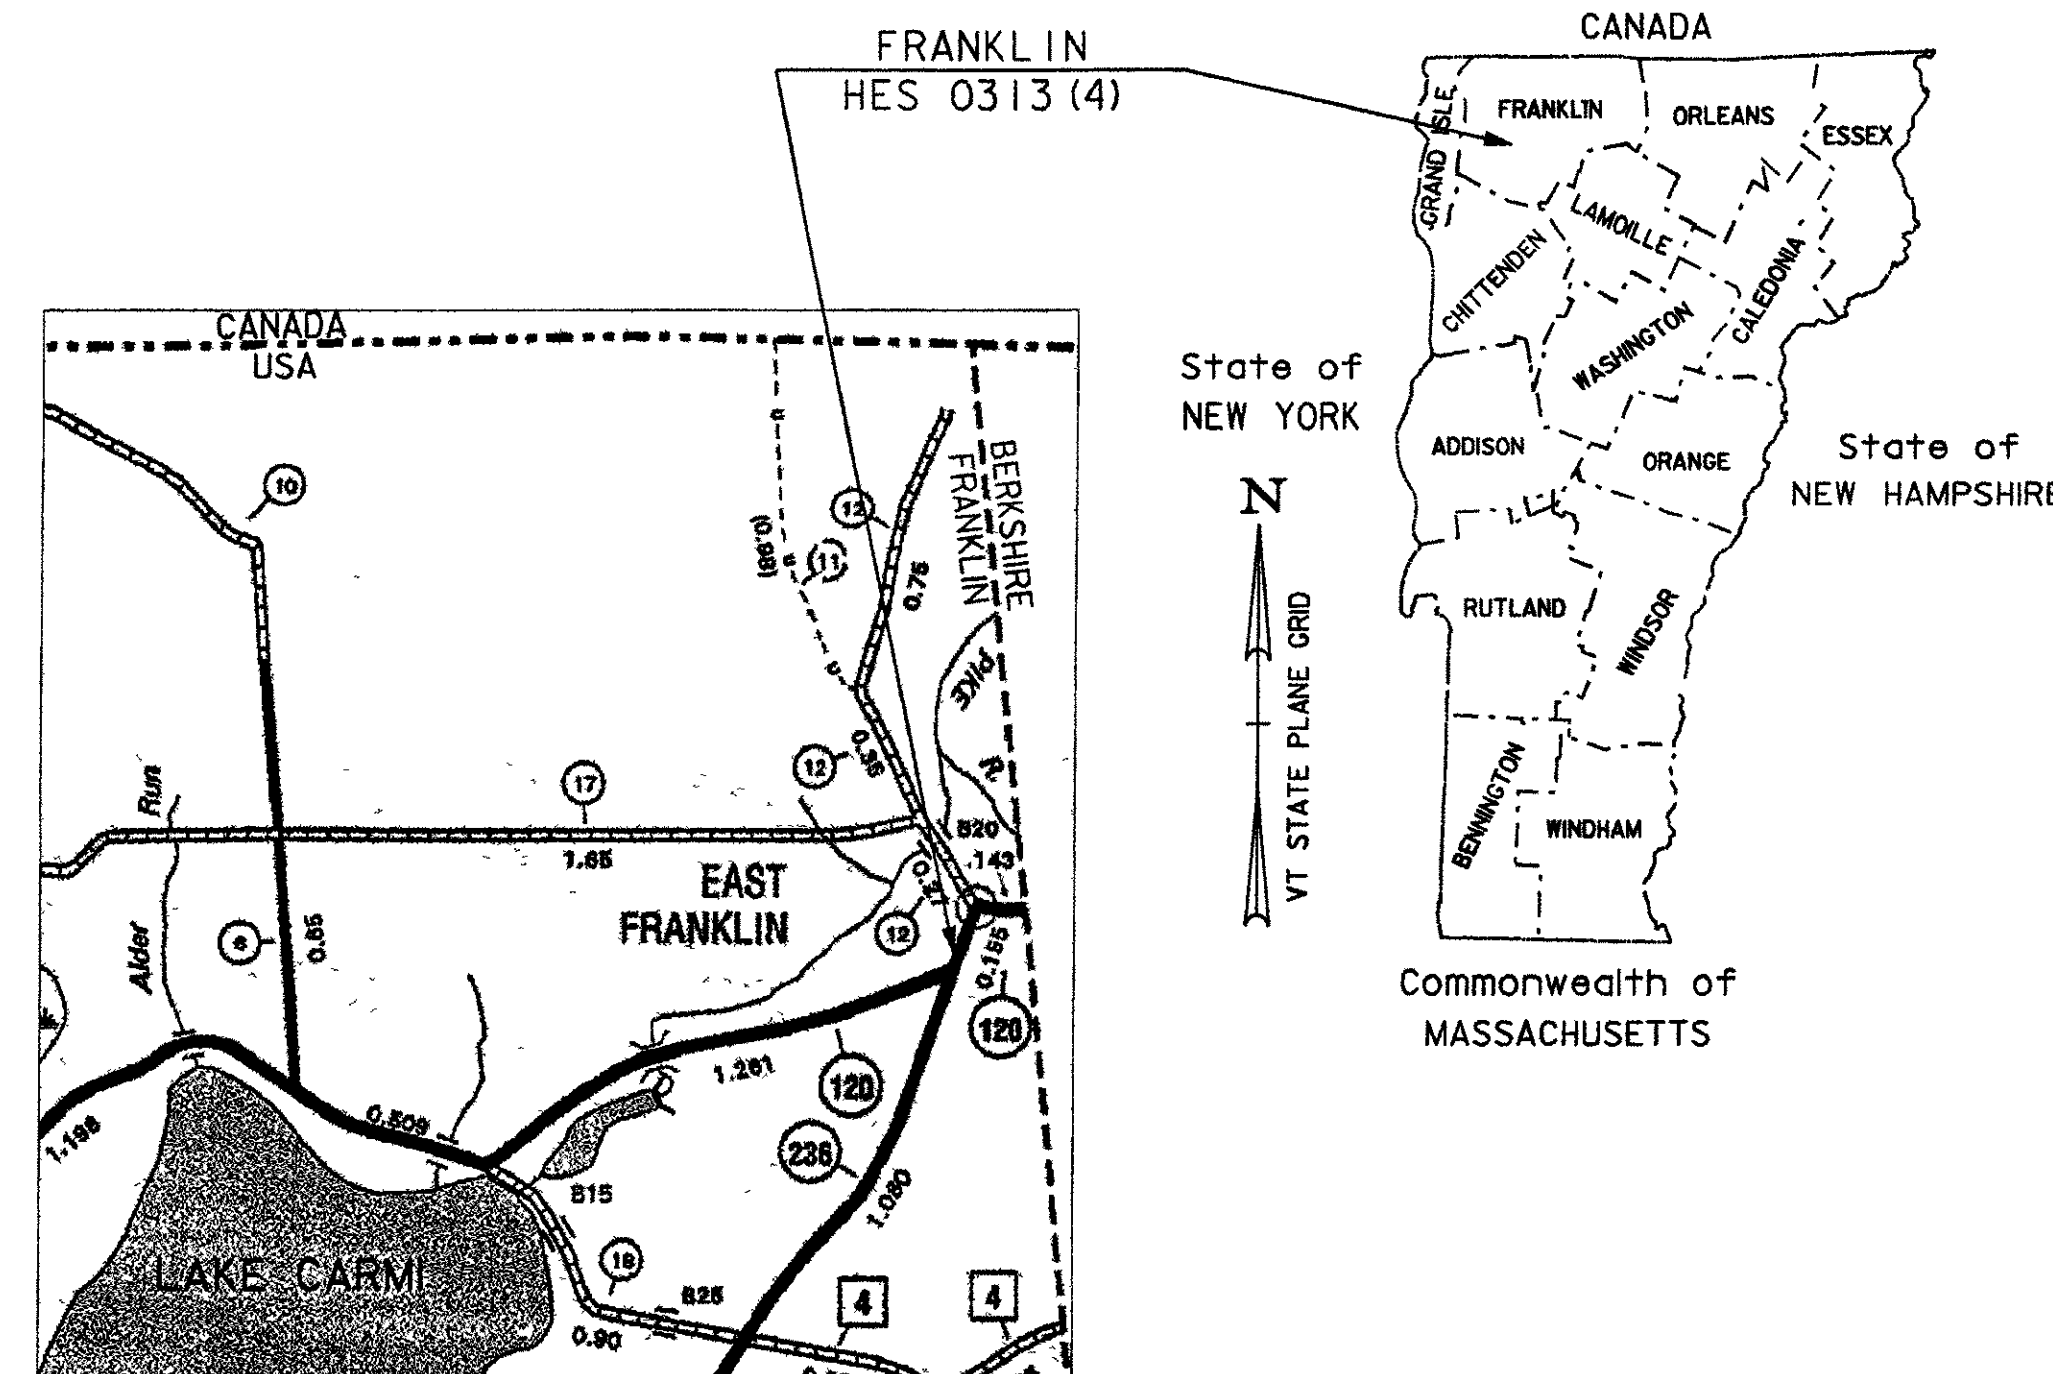


CONVENTIONAL SYMBOLS

COUNTY LINE	
TOWN LINE	
LIMITS OF ACCESS	
POINT OF ACCESS	
FENCE LINE	
STONE WALL	
TRAVELED WAY	
GUARD RAIL	
RAILROAD	
SURVEY LINE	
CULVERT	
POWER POLE	
TELEPHONE POLE	
TREES	
CONTROL OF ACCESS	
PROPERTY LINE	
R.O.W. TAKING LINE	
SLOPE RIGHTS	
TOP OF CUT	
TOE OF SLOPE	

SURVEYED BY : VTRANS
 SURVEYED DATE : 06/2005

DATUM
 VERTICAL: NAVD 88
 HORIZONTAL: NAD83

McFarland-Johnson, Inc.
 CONCORD CENTER, STE 210
 10 FERRY STREET, UNIT 11
 CONCORD, NH 03301
 PHONE (603) 225-2978
 FAX (603) 225-0095

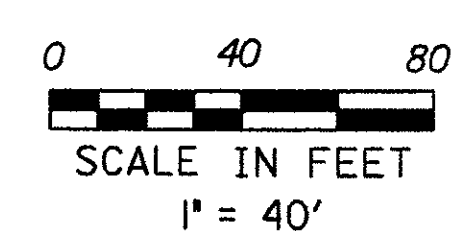

THESE PLANS ARE SUBJECT TO SUCH ENGINEERING CHANGES AS MAY BE REQUIRED BY THE FEDERAL HIGHWAY ADMINISTRATION OR THE DIRECTOR OF PROJECT DEVELOPMENT.
 CONSTRUCTION IS TO BE CARRIED ON IN ACCORDANCE WITH THESE PLANS AND THE STANDARD SPECIFICATIONS FOR CONSTRUCTION DATED 2001, AS APPROVED BY THE FEDERAL HIGHWAY ADMINISTRATION ON JANUARY 4, 2001 FOR USE ON THIS PROJECT, INCLUDING ALL SUBSEQUENT REVISIONS AND SUCH REVISED SPECIFICATIONS AND SPECIAL PROVISIONS AS ARE INCORPORATED IN THESE PLANS.

DIRECTOR OF PROGRAM DEVELOPMENT	APPROVED <u>[Signature]</u> DATE <u>10-23-09</u>
PROJECT MANAGER : GAMBLE	
PROJECT NAME : FRANKLIN	PROJECT NUMBER : HES 0313 (4)
SHEET 1 OF 23 SHEETS	