
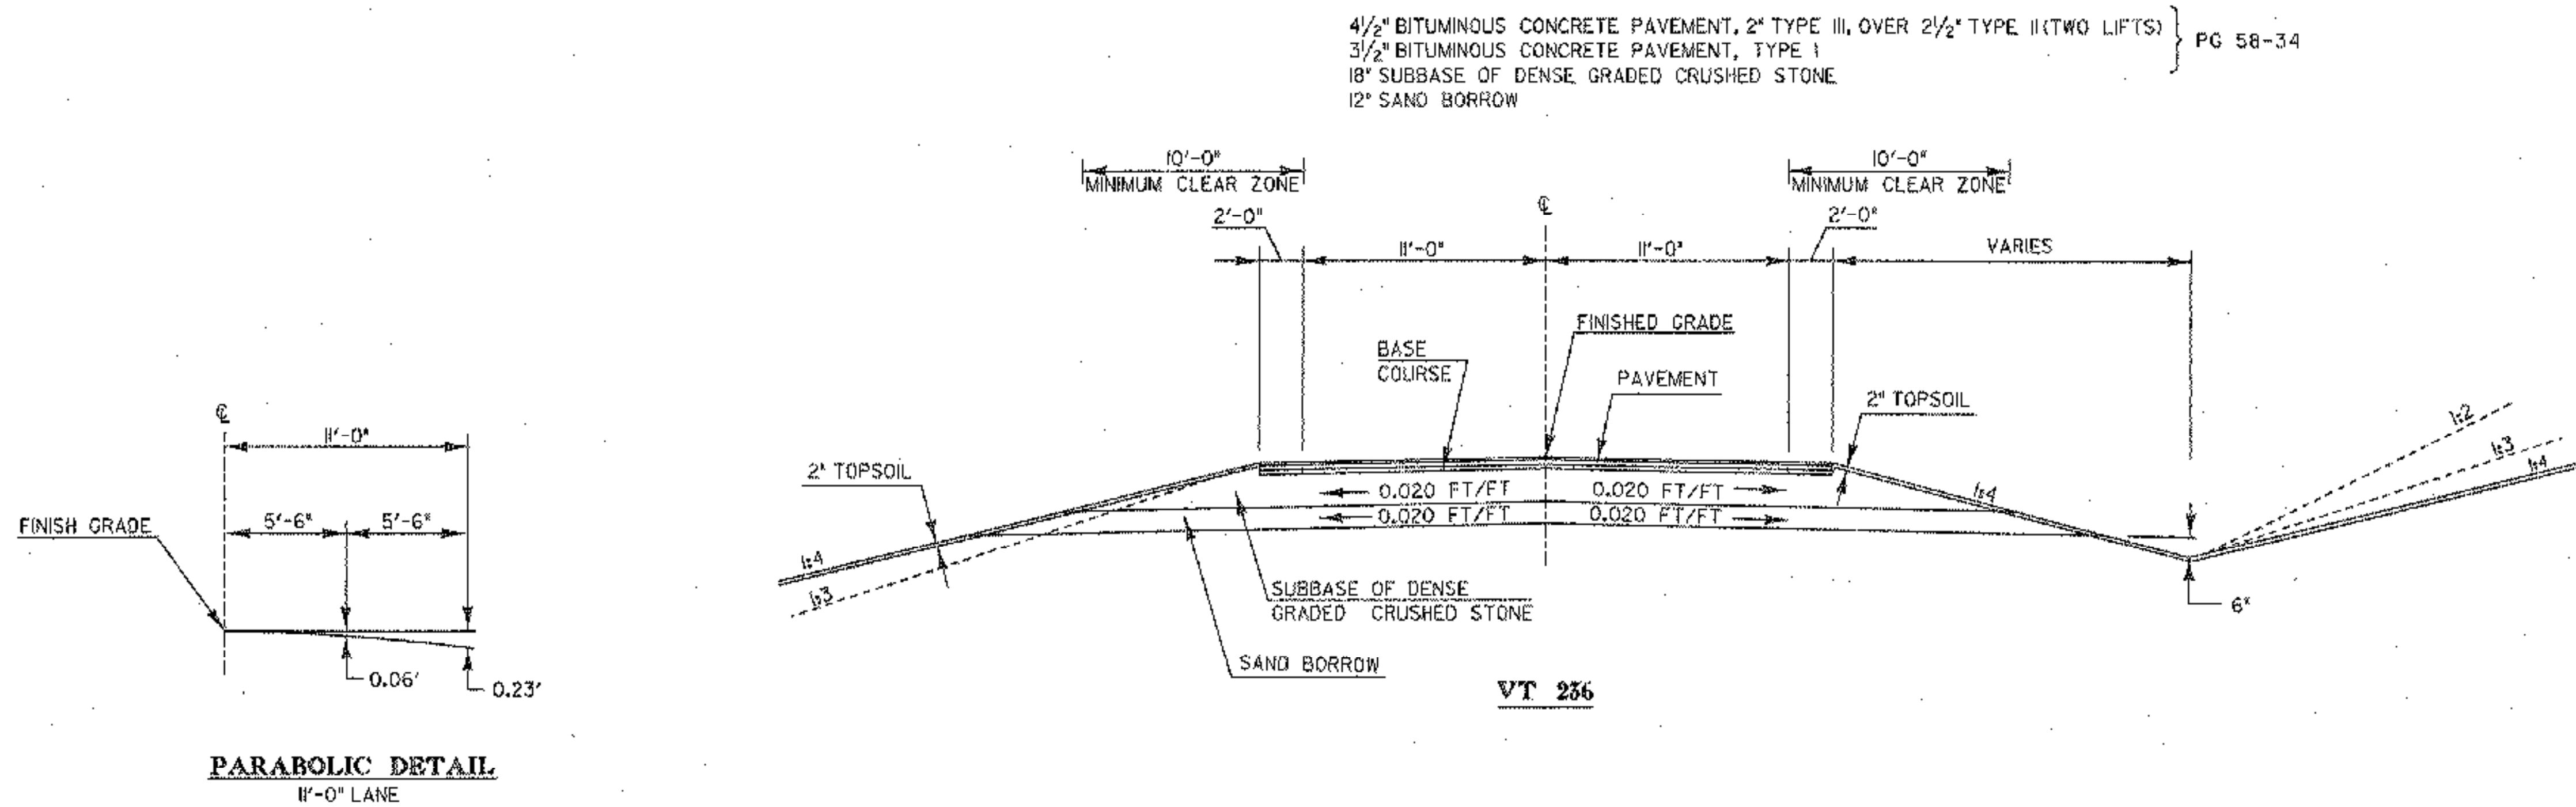
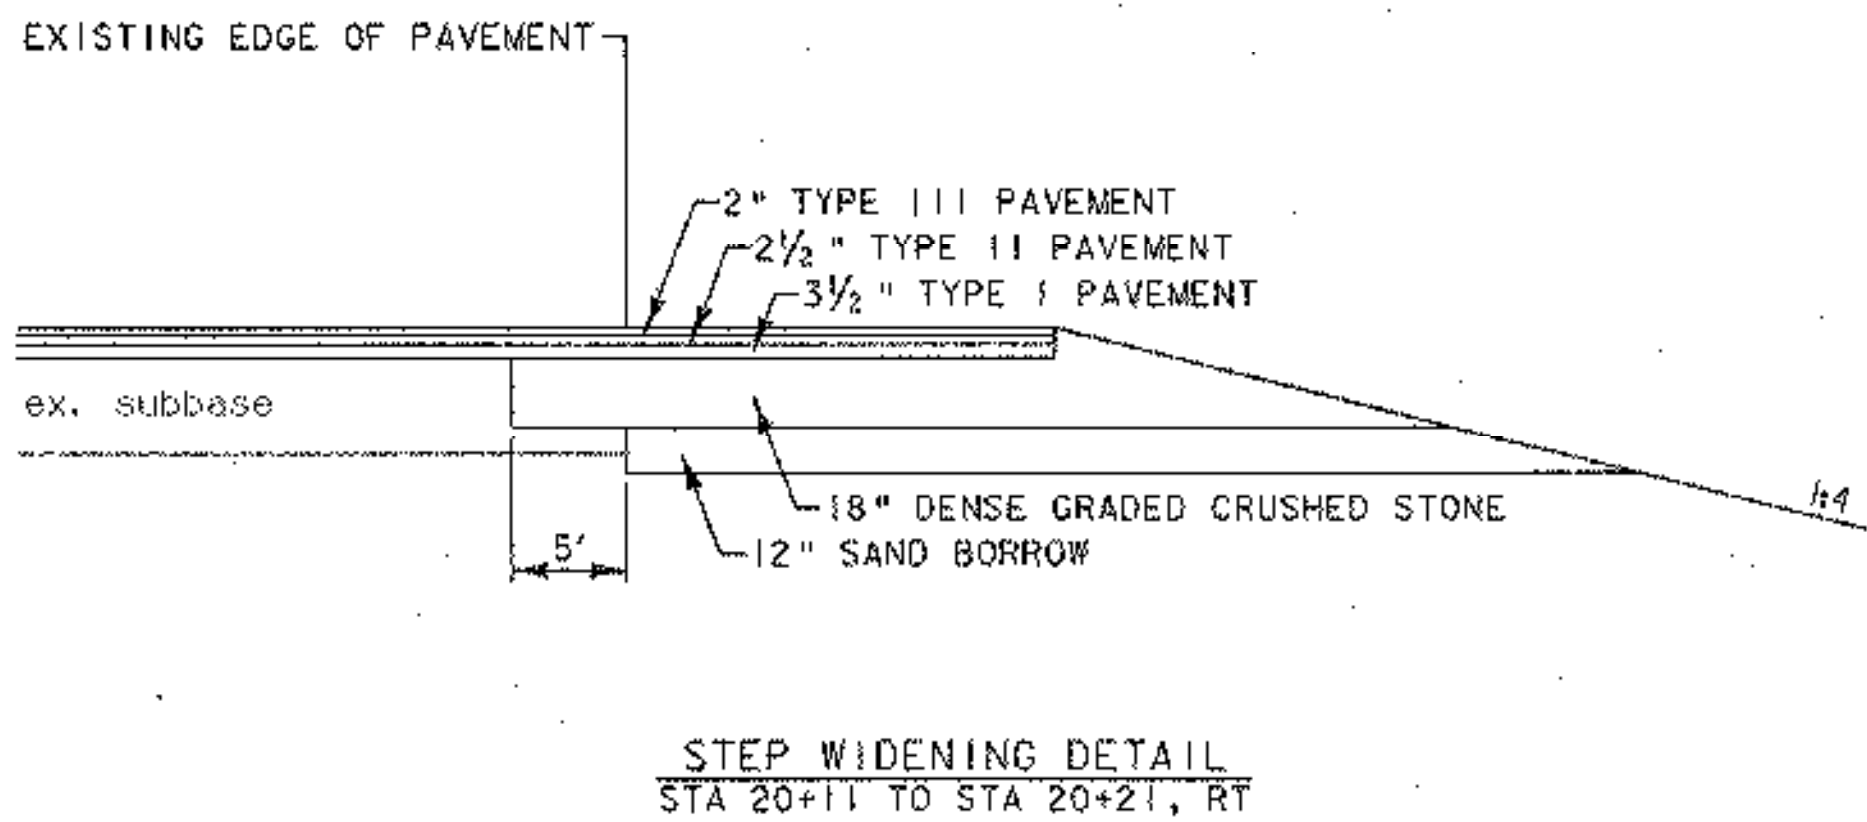
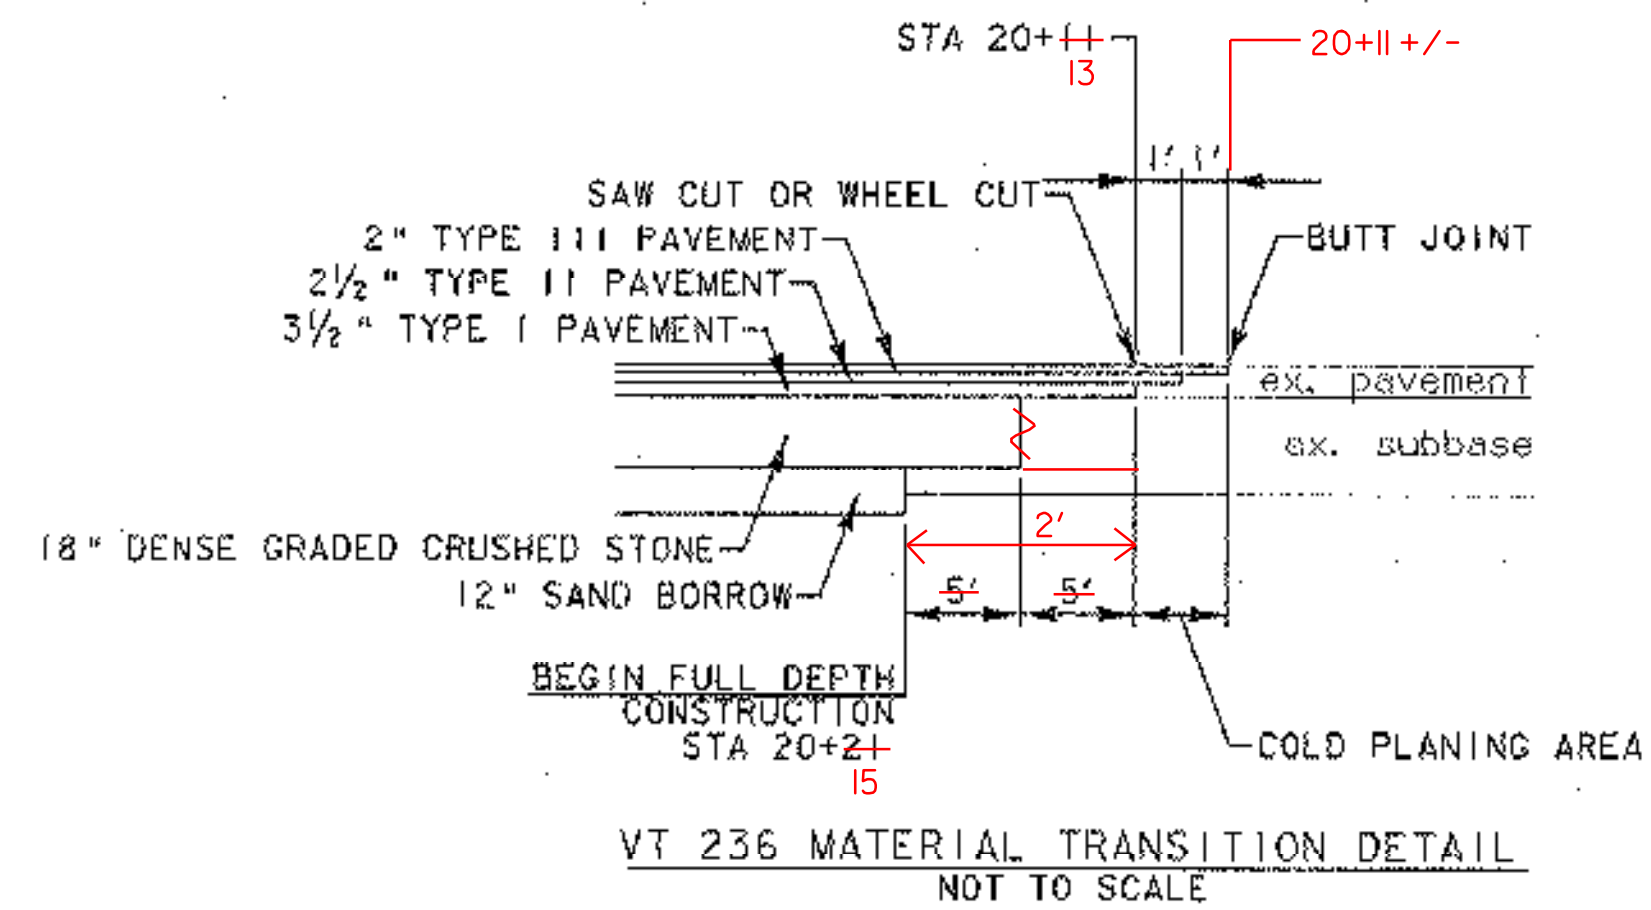


TYPICAL SECTIONS

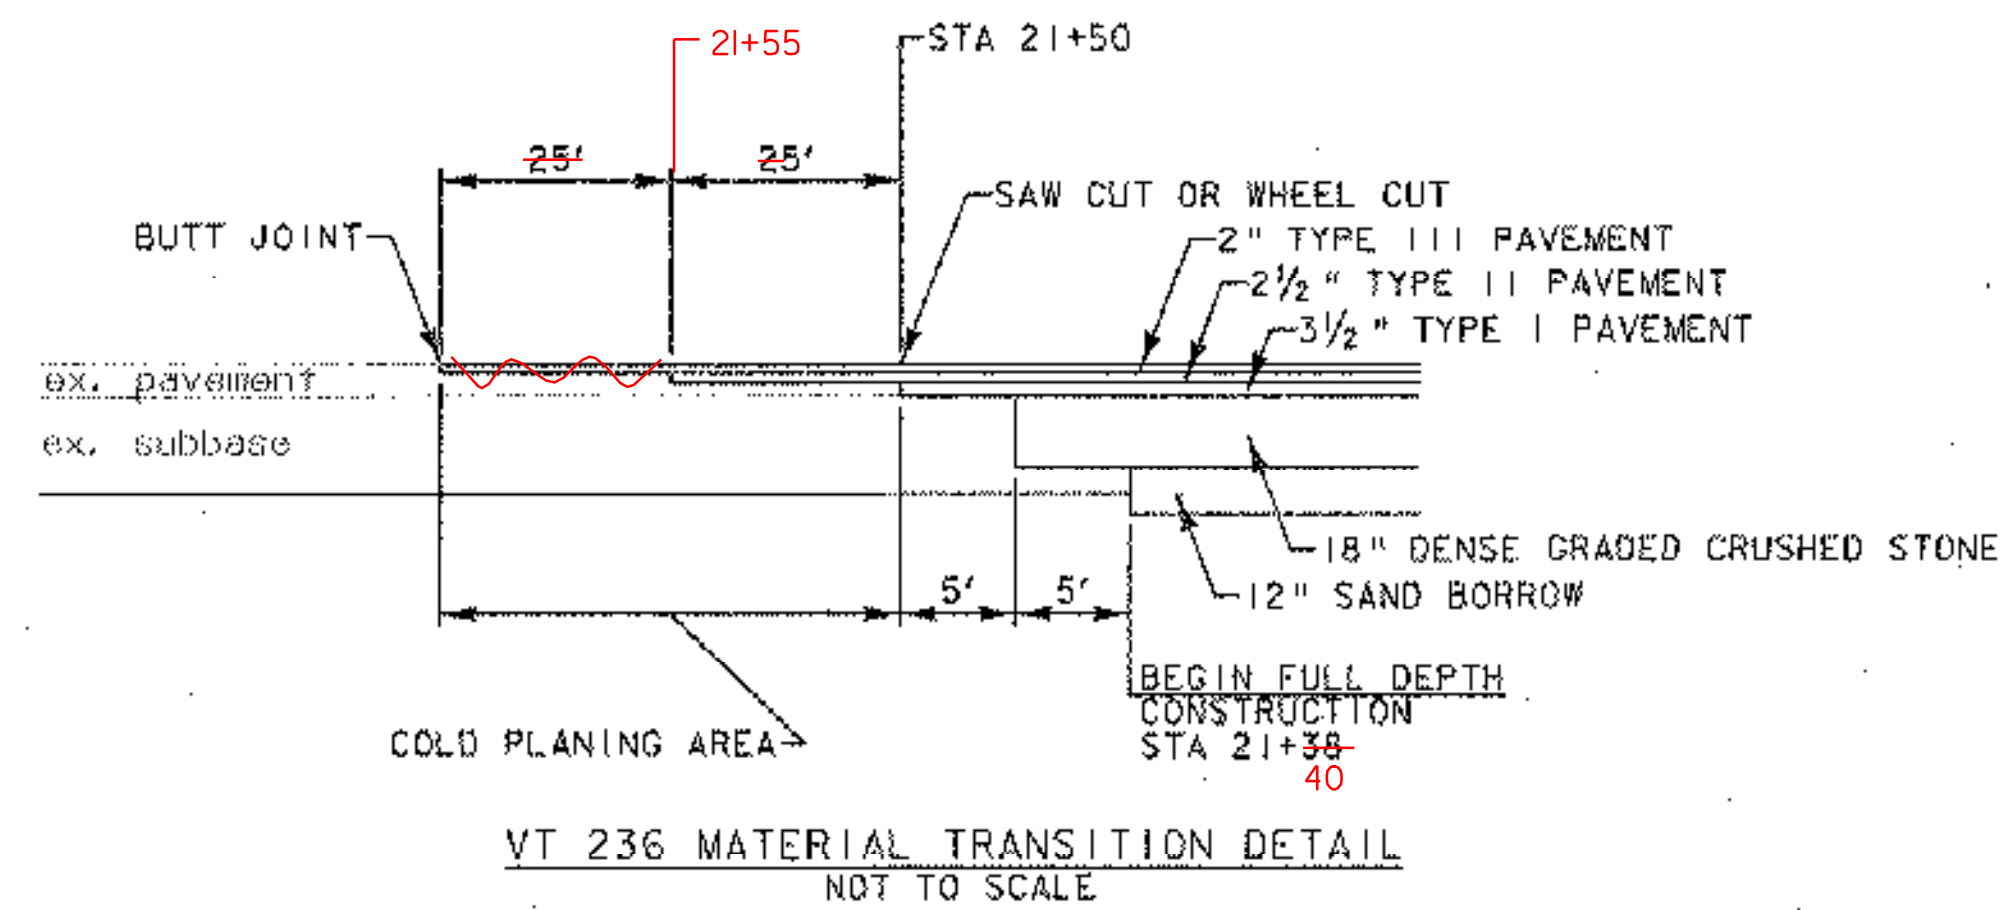

SEEDING FORMULA

RURAL AREAS				
% WT	lb/ac	NAME	PUR %	GERM %
5.0	4	RED TOP	95	90
37.5	23	CREeping RED FESCUE	98	85
15.0	9	BIRDSFOOT TREFLOIL	98	85
37.5	23	TALL FESCUE	95	90
5.0	4	ANNUAL RYE GRASS	95	85
100.0	63			

GENERAL NOTES

- SEED MIXTURE: SHALL NOT HAVE A WEED CONTENT EXCEEDING 0.40% BY WEIGHT AND SHALL BE FREE OF ALL NOXIOUS SEED.
- SEED: TO BE APPLIED PER SEEDING FORMULAS, OR AS DIRECTED BY THE ENGINEER.
- FERTILIZER: FORMULA 10-20-10, TO BE USED WITH SEED, APPLIED AT THE RATE OF 500 lb/ac (HYDRO SEEDERS MAY USE 19-19-19 FORMULA).
- AGRICULTURAL LIMESTONE: TO BE APPLIED AT THE RATE OF 2.0 tons/ac, OR AS DIRECTED BY THE ENGINEER.
- HAY MULCH: TO BE PLACED ON EARTH SLOPES AT THE RATE OF 2.0 tons/ac, OR AS DIRECTED BY THE ENGINEER.
- TOPSOIL: TO BE USED WITH SEED AS INDICATED ON THE PLANS, OR AS DIRECTED BY THE ENGINEER.
- MARKER POSTS: TO BE PLACED AS INDICATED OR AS DIRECTED BY THE ENGINEER.
- SLOPE ROUNDING: ALL CUT SLOPES TO BE ROUNDED IN ACCORDANCE WITH STANDARD SHEET B-5.
- TACK COAT: EMULSIFIED ASPHALT IS TO BE APPLIED AT THE RATE OF 0.002 gal/ft² BETWEEN SUCCESSIVE COURSES OF PAVEMENT AS DIRECTED BY THE ENGINEER.

MATERIALS TOLERANCE TABLE

MATERIAL ITEM	THICKNESS TOLERANCE
PAVEMENT (TOTAL DEPTH)	+/- 1/4 INCH
SUBBASE (TOTAL DEPTH)	+/- 1 INCH
SAND BORROW (TOTAL DEPTH)	+/- 1 INCH

NOTE: ALL DIMENSIONS IN FEET (FT) EXCEPT WHERE NOTED

PROJECT NAME: FRANKLIN	PLOT DATE: 02-NOV-2006
PROJECT NUMBER: HES 0313(4)	DRAWN BY: MJF
FILE NAME: Z04C202TYP	CHECKED BY: DMB
PROJECT LEADER: GAMBLE	SHEET 3 OF 26
DESIGNED BY: BRC	
TYPICAL SECTION - VT 236	

DATUM	
VERTICAL:	NAVD 88
HORIZONTAL:	NAD83

NOT TO SCALE