


VT 236

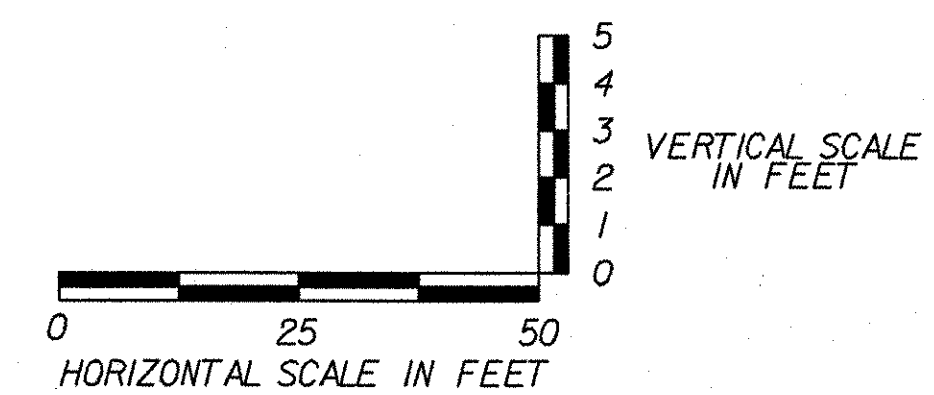

DATUM
 VERTICAL: NAVD 88
 HORIZONTAL: NAD83

PROJECT NAME: FRANKLIN
 PROJECT NUMBER: HES 0313(4)
 FILE NAME: PROF01.DGN
 PROJECT LEADER: GAMBLE
 DESIGNED BY: BRC
 PROFILE - VT 236
 PLOT DATE: 11-OCT-2006
 DRAWN BY: MJF
 CHECKED BY: DMB
 SHEET 13 OF 26