


- LEGEND**
- → → → → EXISTING DRAINAGE PATTERNS
  - ▲—▲—▲— WETLANDS
  - ARCH— ARCHAEOLOGICAL AREAS

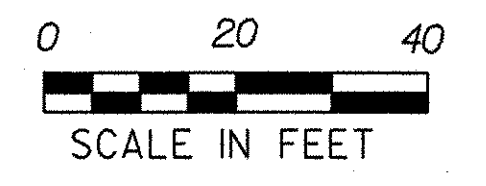

**DATUM**  
 VERTICAL: NAVD 88  
 HORIZONTAL: NAD83

PROJECT NAME: FRANKLIN	
PROJECT NUMBER: HES 0313(4)	
FILE NAME: EC02.DGN	PLOT DATE: 11-OCT-2006
PROJECT LEADER: GAMBLE	DRAWN BY: MJF
DESIGNED BY: BRC	CHECKED BY: DMB
EXISTING CONDITIONS SITE PLAN	SHEET 15 OF 26