


FINAL CONDITIONS SITE PLAN

- NOTES:
1. PROPOSED CONTOURS NOT SHOWN. SEE CROSS SECTIONS FOR PROPOSED GRADING.
 2. DISTURBED SOIL SHALL BE SEEDED AND MULCHED TO ESTABLISH PERMANENT STABILIZATION.

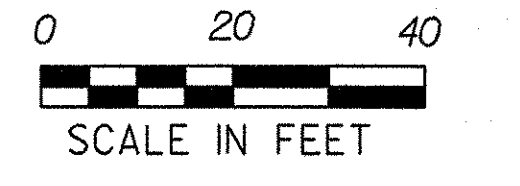

DATUM
 VERTICAL: NAVD 88
 HORIZONTAL: NAD83

PROJECT NAME: FRANKLIN	PLOT DATE: 11-OCT-2006
PROJECT NUMBER: HES 0313(4)	DRAWN BY: MJF
FILE NAME: ECO4.DGN	CHECKED BY: DMB
PROJECT LEADER: GAMBLE	SHEET 17 OF 26
DESIGNED BY: BRC	
FINAL CONDITIONS SITE PLAN	