

SIGN LEGEND

R = REMOVE
 S = SALVAGE
 N = NEW
 RET = RETAIN
 B-B = BACK TO BACK

DATUM

VERTICAL: NAVD 88
 HORIZONTAL: NAD83


DURABLE 4" YELLOW LINE (SOLID) (THERMOPLASTIC)
 STA 20+17.0 TO STA 22+00.0, LT (CENTER LINE)
 STA 20+17.0 TO STA 22+00.0, RT (CENTER LINE)
 STA 4+00.0 TO STA 4+80.0, LT (CENTER LINE)
 STA 4+00.0 TO STA 4+80.0, RT (CENTER LINE)
 STA 5+20.0 TO STA 7+00.0, LT (CENTER LINE)
 STA 5+20.0 TO STA 7+00.0, RT (CENTER LINE)

DURABLE 4" WHITE LINE (SOLID) (THERMOPLASTIC)
 STA 20+17.0 TO STA 22+00.0, LT (EDGE LINE)
 STA 20+17.0 TO STA 22+00.0, RT (EDGE LINE)

DURABLE LETTER OR SYMBOL (THERMOPLASTIC)
 STA 20+25.0, LT - "STOP"

DURABLE 24" STOP BAR (THERMOPLASTIC)
 STA 20+17.0, LT (25 FT)

SIGN REMOVALS 15 EA

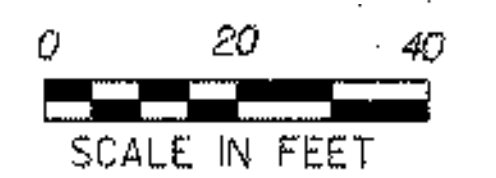

PROJECT NAME:	FRANKLIN
PROJECT NUMBER:	HES 0313(4)
FILE NAME:	TSOLDGN
PROJECT LEADER:	GAMBLE
DESIGNED BY:	BRC
TRAFFIC SIGN & PAVEMENT MARKINGS	
PLOT DATE:	11-OCT-2006
DRAWN BY:	MJF
CHECKED BY:	DMB
SHEET	23 OF 26