


BEGIN PROJECT  
 STA 20+11

DATUM  
 VERTICAL: NAVD 88  
 HORIZONTAL: NAD83

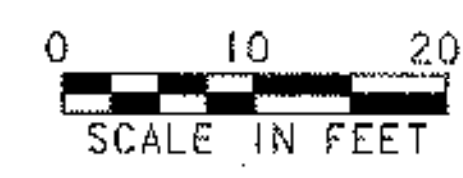

PROJECT NAME: FRANKLIN  
 PROJECT NUMBER: HES 0313(4)  
 FILE NAME: XS VT236.DGN  
 PROJECT LEADER: GAMBLE  
 DESIGNED BY: BRC  
 VT 236 CROSS SECTIONS

PLOT DATE: 11-OCT-2006  
 DRAWN BY: MJF  
 CHECKED BY: DMB  
 SHEET 25 OF 26