

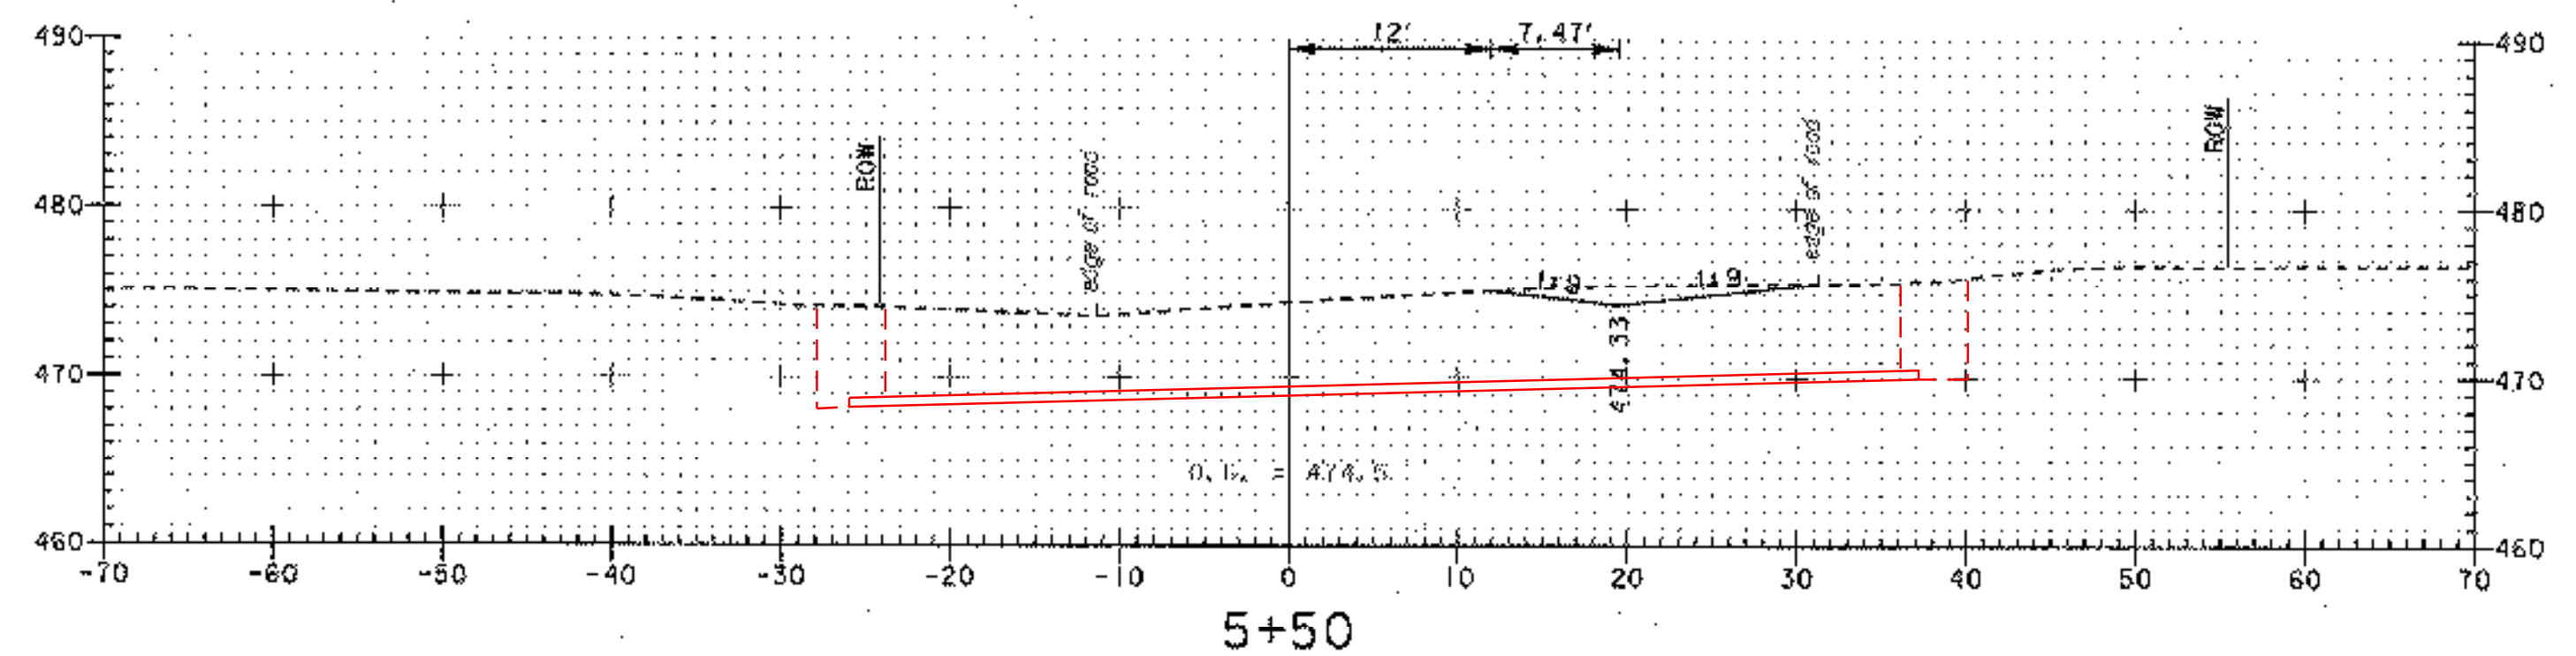
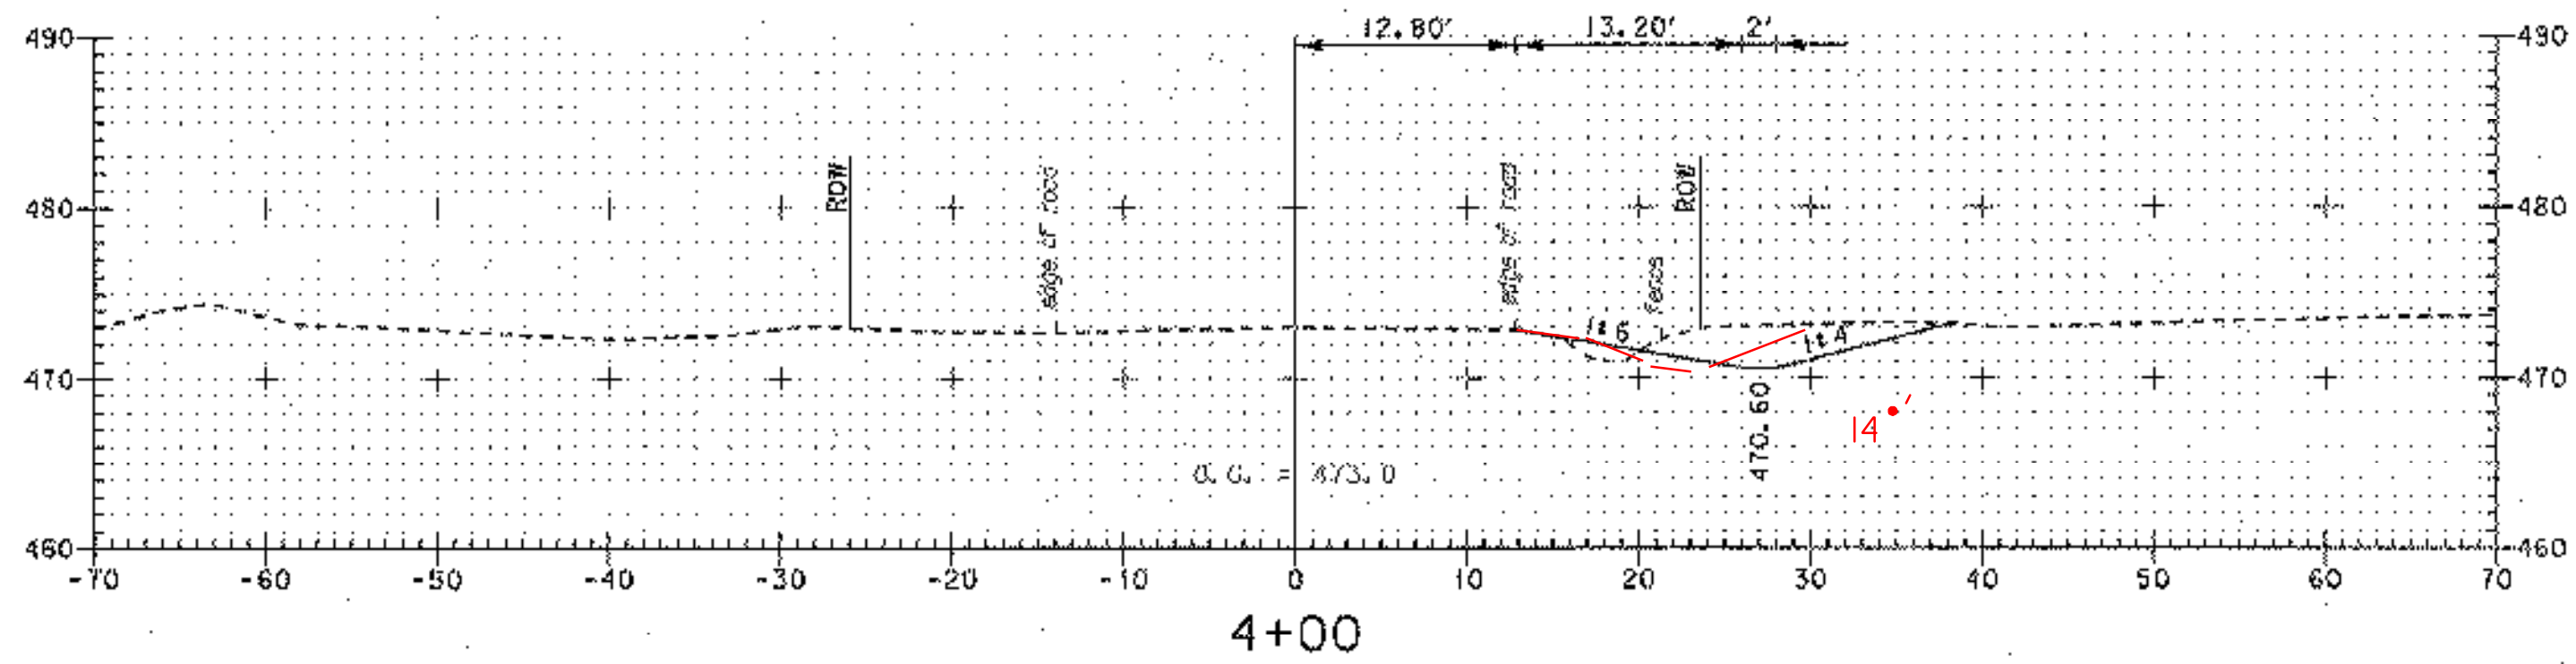
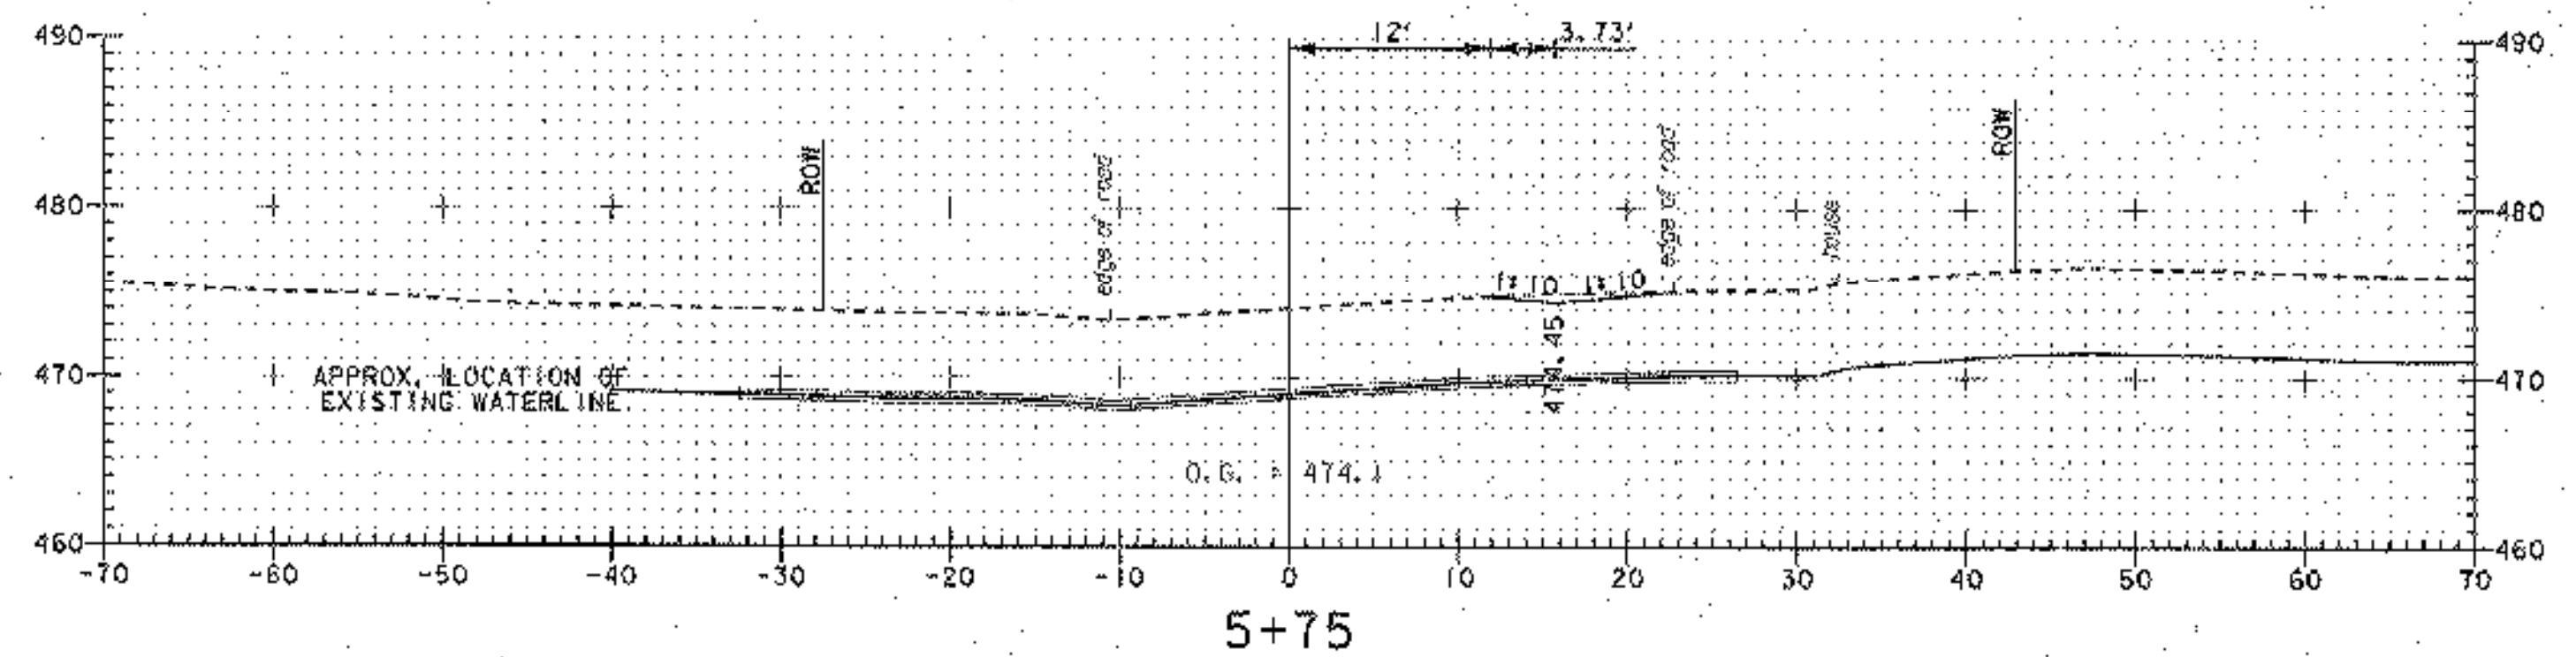
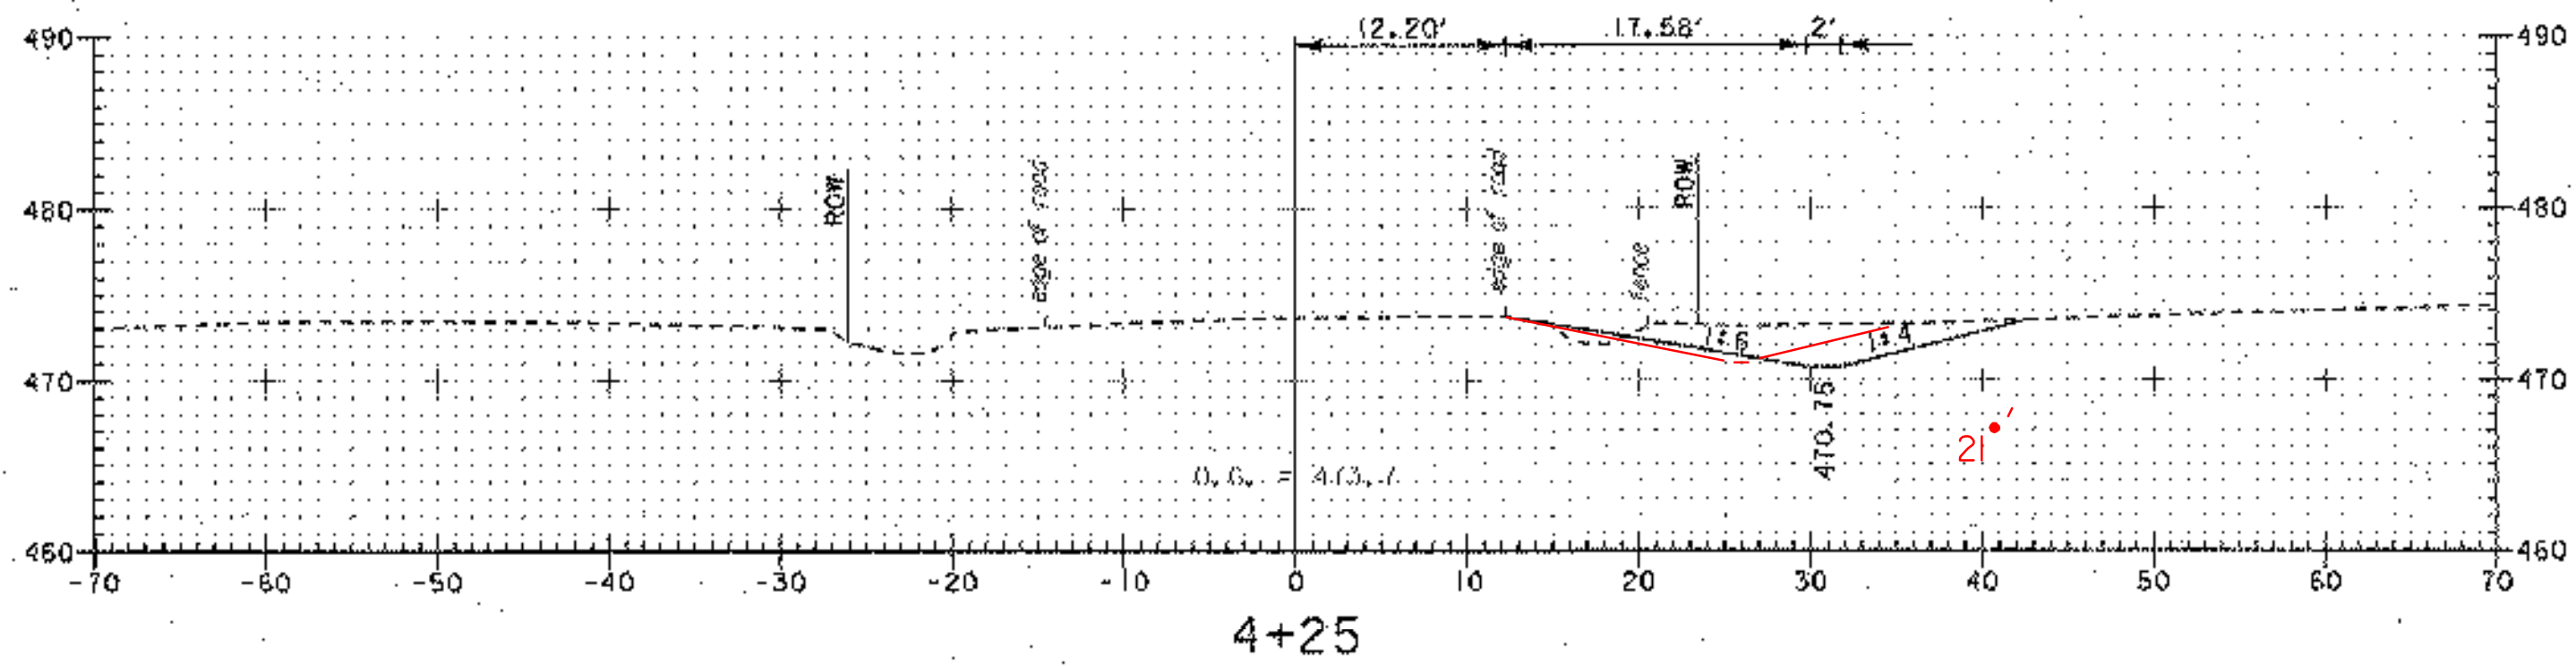


4+62 - SAME COMMON AS 4+50
(END OF CULVERT)

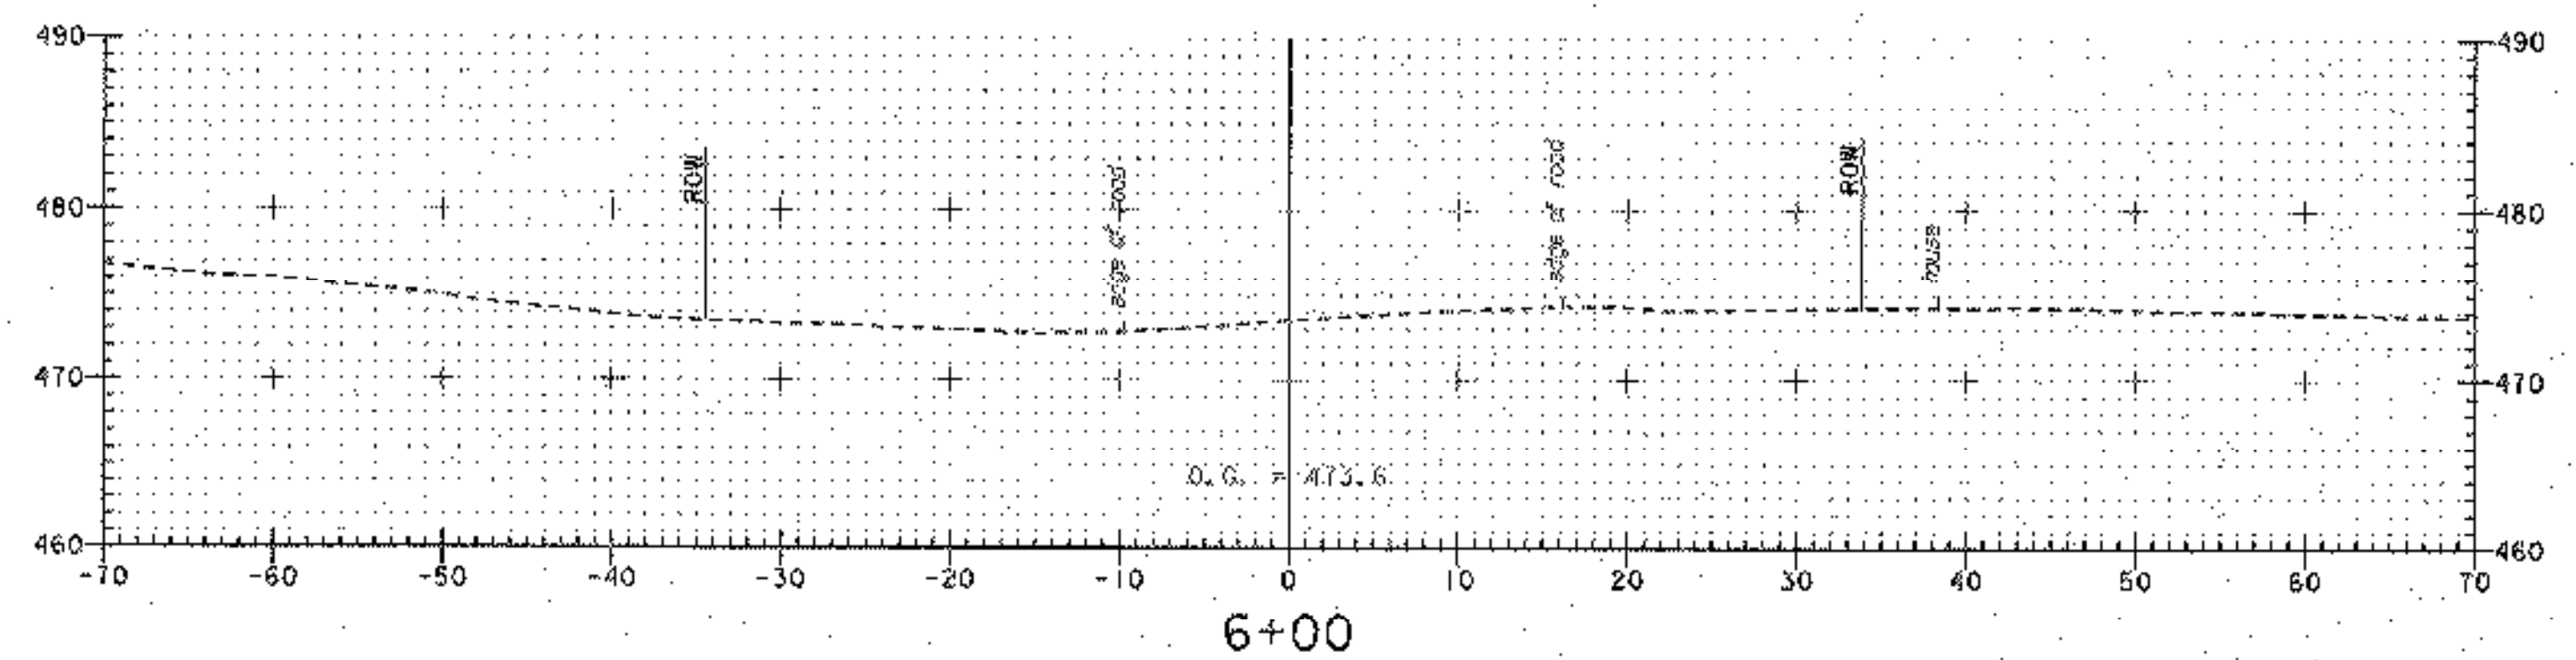

3+75 ZERO COMMON EXC. - DITCH

DATUM
VERTICAL: NAVD 88
HORIZONTAL: NAD83

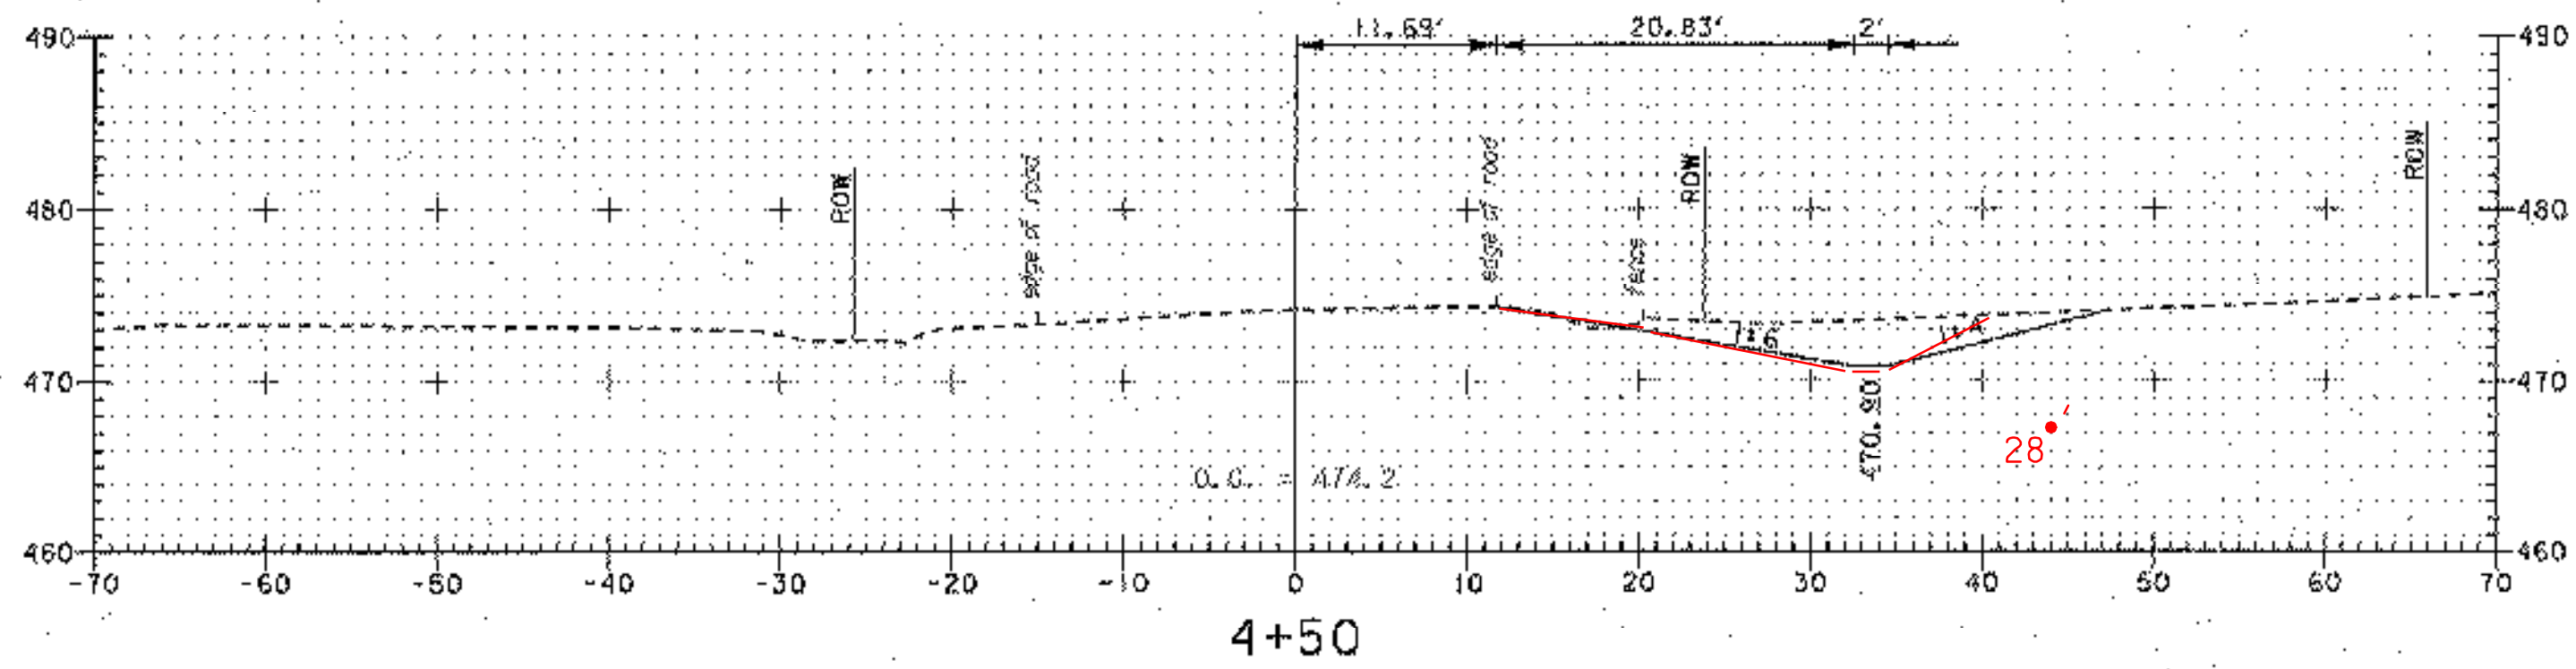

PROJECT NAME: FRANKLIN
PROJECT NUMBER: HES 0313(4)
FILE NAME: XS VT120.DGN
PROJECT LEADER: GAMBLE
DESIGNED BY: BRC
VT 120 CROSS SECTIONS
PLOT DATE: 11-OCT-2006
DRAWN BY: MJF
CHECKED BY: DMB
SHEET 26 OF 26