

INDEX OF SHEETS
SEE SHEET 2

STATE OF VERMONT
AGENCY OF TRANSPORTATION



PROPOSED IMPROVEMENT
CITY OF RUTLAND & TOWN OF PROCTOR
COUNTY OF RUTLAND

U.S. BUSINESS ROUTE 4 (PRINCIPAL ARTERIAL), VT. ROUTE 3 (MINOR ARTERIAL)

&
U.S. ROUTE 7, U.S. ROUTE 4 (PRINCIPAL ARTERIALS)

RECORD PLANS

CONTRACTOR: PECKHAM ROAD CORPORATION - WHITE PLAINS, NY

RESIDENT ENGINEER: TIM POCKETTE

CONSTRUCTION BEGAN: FEBRUARY 24, 2014

CONSTRUCTION COMPLETE: OCTOBER 14, 2015


RECORD PLANS BY: TIM POCKETTE & PAUL BEYOR

I HEREBY CERTIFY THAT ALL THE CONSTRUCTION REQUIRED BY THIS SET OF DRAWINGS HAS BEEN ACCOMPLISHED AS INDICATED HEREIN.

BY Tim Pockette RESIDENT ENGINEER

DATE 06-15-2018


NOTE: Any further information concerning final quantities, amounts or other details relative to this project may be found at Central Files in the electronic archives.

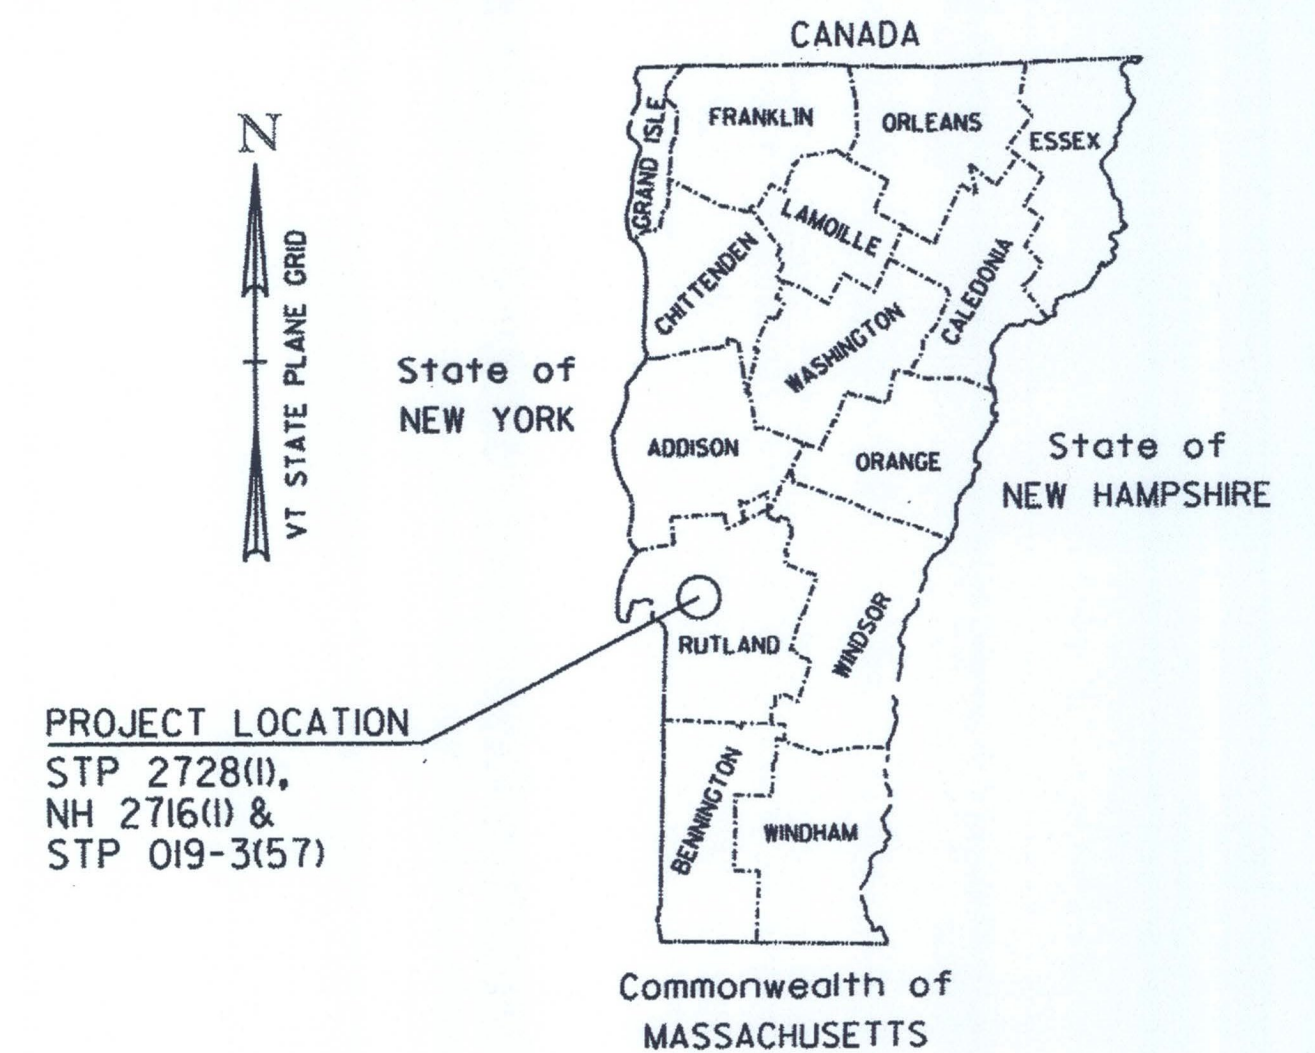

RUTLAND CITY - PROCTOR
STP 2728(1)
SEE SHEET 28
FOR ADDITIONAL PROJECT INFORMATION
AND THE SUPERPAVE DESIGN CRITERIA

RUTLAND CITY
NH 2716(1)
SEE SHEET 145
FOR ADDITIONAL PROJECT INFORMATION
AND THE SUPERPAVE DESIGN CRITERIA

RUTLAND CITY
STP 019-3(57)
SEE SHEET 263
FOR ADDITIONAL PROJECT INFORMATION

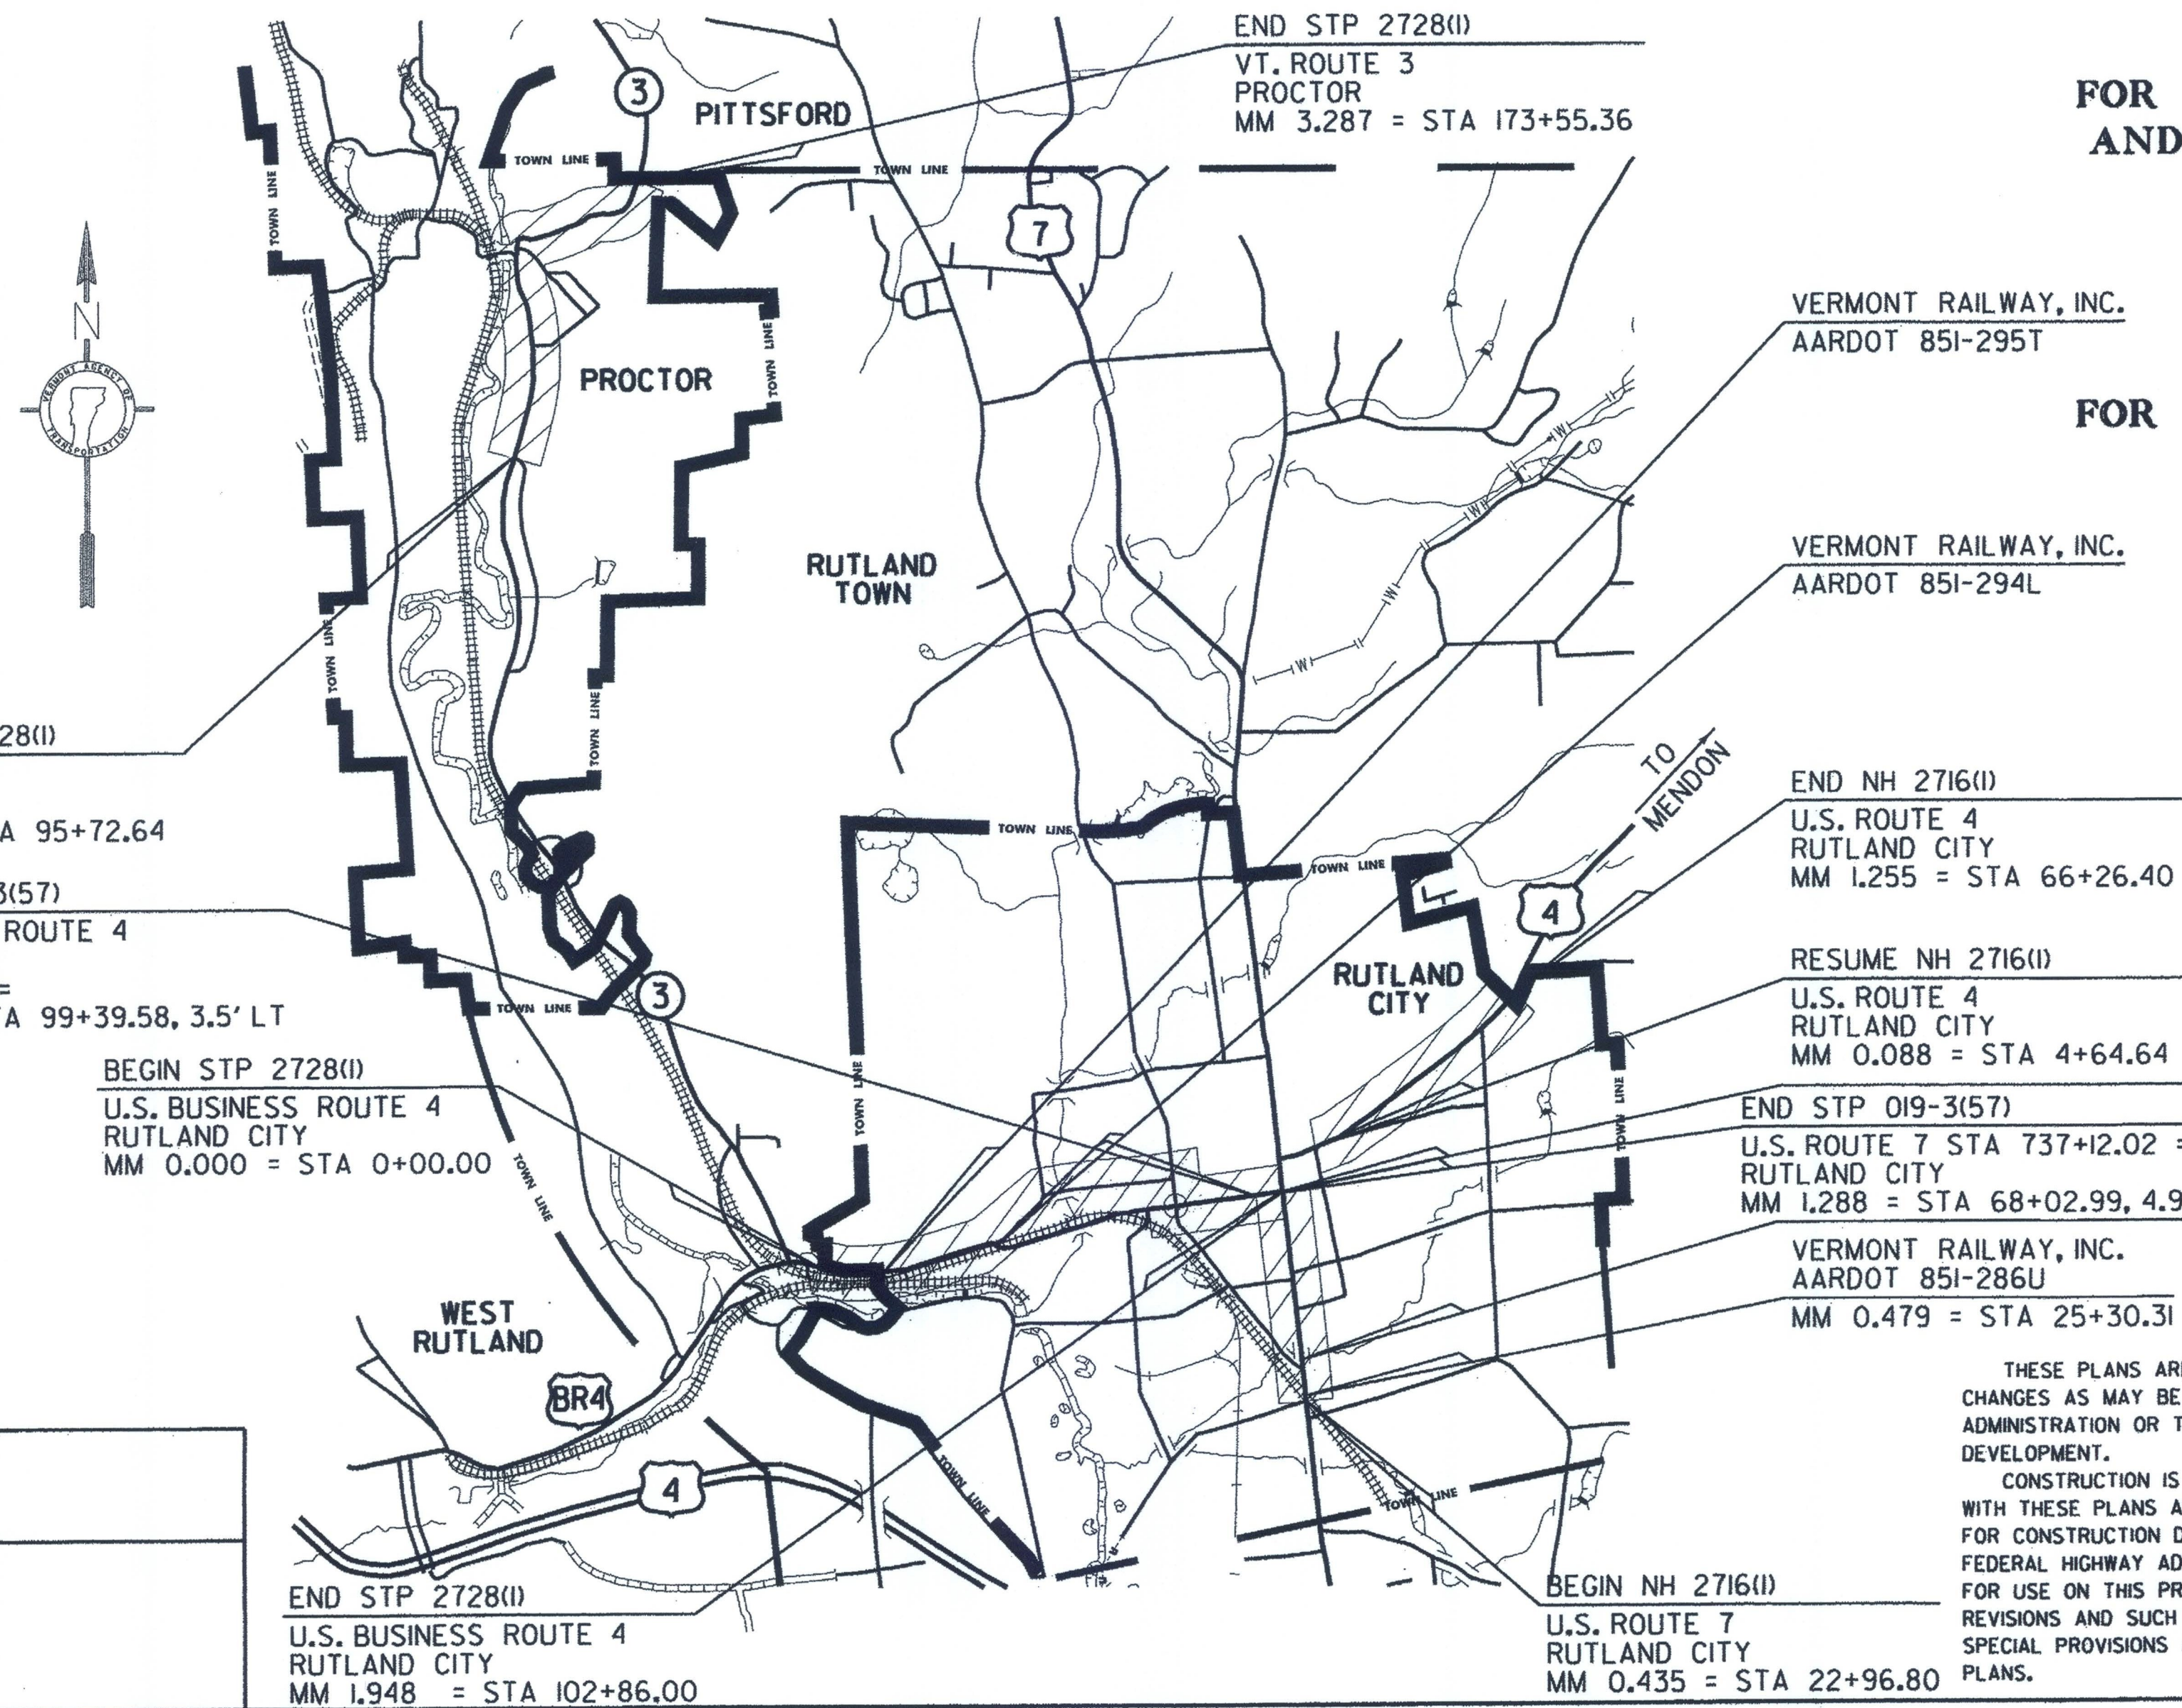


QUALITY ASSURANCE PROGRAM: LEVEL 1

CONVENTIONAL SYMBOLS

COUNTY LINE	
TOWN LINE	
LIMITS OF ACCESS	
POINT OF ACCESS	
FENCE LINE	
STONE WALL	
TRAVELED WAY	
GUARD RAIL	
RAILROAD	
SURVEY LINE	
CULVERT	
POWER POLE	
TELEPHONE POLE	
TREES	
CONTROL OF ACCESS	
PROPERTY LINE	
R.O.W. TAKING LINE	
SLOPE RIGHTS	
TOP OF CUT	
TOE OF SLOPE	

SURVEYED BY : NA
SURVEYED DATE : NA

DATUM
VERTICAL NA
HORIZONTAL NA

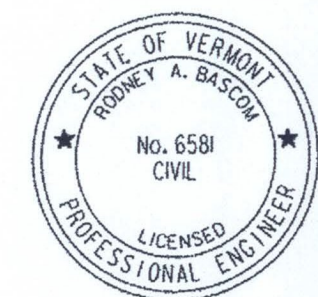

PLANS PREPARED BY

Rodney A. Bacon

CHA

THESE PLANS ARE SUBJECT TO SUCH ENGINEERING CHANGES AS MAY BE REQUIRED BY THE FEDERAL HIGHWAY ADMINISTRATION OR THE DIRECTOR OF PROGRAM DEVELOPMENT.

CONSTRUCTION IS TO BE CARRIED ON IN ACCORDANCE WITH THESE PLANS AND THE STANDARD SPECIFICATIONS FOR CONSTRUCTION DATED 2011, AS APPROVED BY THE FEDERAL HIGHWAY ADMINISTRATION ON JULY 20, 2011 FOR USE ON THIS PROJECT, INCLUDING ALL SUBSEQUENT REVISIONS AND SUCH REVISED SPECIFICATIONS AND SPECIAL PROVISIONS AS ARE INCORPORATED IN THESE PLANS.

DIRECTOR OF PROGRAM DEVELOPMENT	
APPROVED <u>Rodney A. Bacon</u>	DATE <u>7-23-13</u>
PROJECT MANAGER : MIKE FOWLER, P.E.	
PROJECT NAME : RUTLAND CITY-PROCTOR & RUTLAND CITY	
PROJECT NUMBER : STP 2728 (1), NH 2716 (1) & STP 019-3 (57)	
SHEET 1 OF 392 SHEETS	

FILE NAME = U:\17752\CADD\NH\2716\87\188_comp.evr.dgn
DATE = 7/23/13
USER = 498