

646.406 DURABLE 4 INCH WHITE LINE, RECESSED POLYUREA
 (ALL LINES WILL INCLUDE EDGE LINE BREAKS AND RADIUS FOR TOWN HIGHWAYS)
 PROCTOR:
 STA 119+75.00 - STA 125+75.00 EDGE LINE LT
 STA 119+75.00 - STA 122+92.00 EDGE LINE RT

646.416 DURABLE 4 INCH YELLOW LINE, RECESSED POLYUREA
 (ALL LINES WILL INCLUDE C/L BREAKS FOR TOWN HIGHWAYS) S=SOLID, D=DASHED
 PROCTOR:
 STA 119+75.00 - STA 125+75.00 LT C RT S - S



646.501 DURABLE CROSSWALK MARKING, TYPE 1 TAPE
 PROCTOR:
 STA 122+76.00 LT, TH-41

646.602 TEMPORARY 4 INCH WHITE LINE, PAINT
 (ALL LINES WILL INCLUDE EDGE LINE BREAKS AND RADIUS FOR TOWN HIGHWAYS)
 PROCTOR:
 STA 119+75.00 - STA 125+75.00 EDGE LINE LT
 STA 119+75.00 - STA 122+92.00 EDGE LINE RT

646.612 TEMPORARY 4 INCH YELLOW LINE, PAINT
 (ALL LINES WILL INCLUDE C/L BREAKS FOR TOWN HIGHWAYS) S=SOLID, D=DASHED
 PROCTOR:
 STA 119+75.00 - STA 125+75.00 LT C RT S - S

646.702 TEMPORARY CROSSWALK MARKING, PAINT
 PROCTOR:
 STA 122+76.00 LT, TH-41

675.50 REMOVING SIGNS AS SHOWN - 5

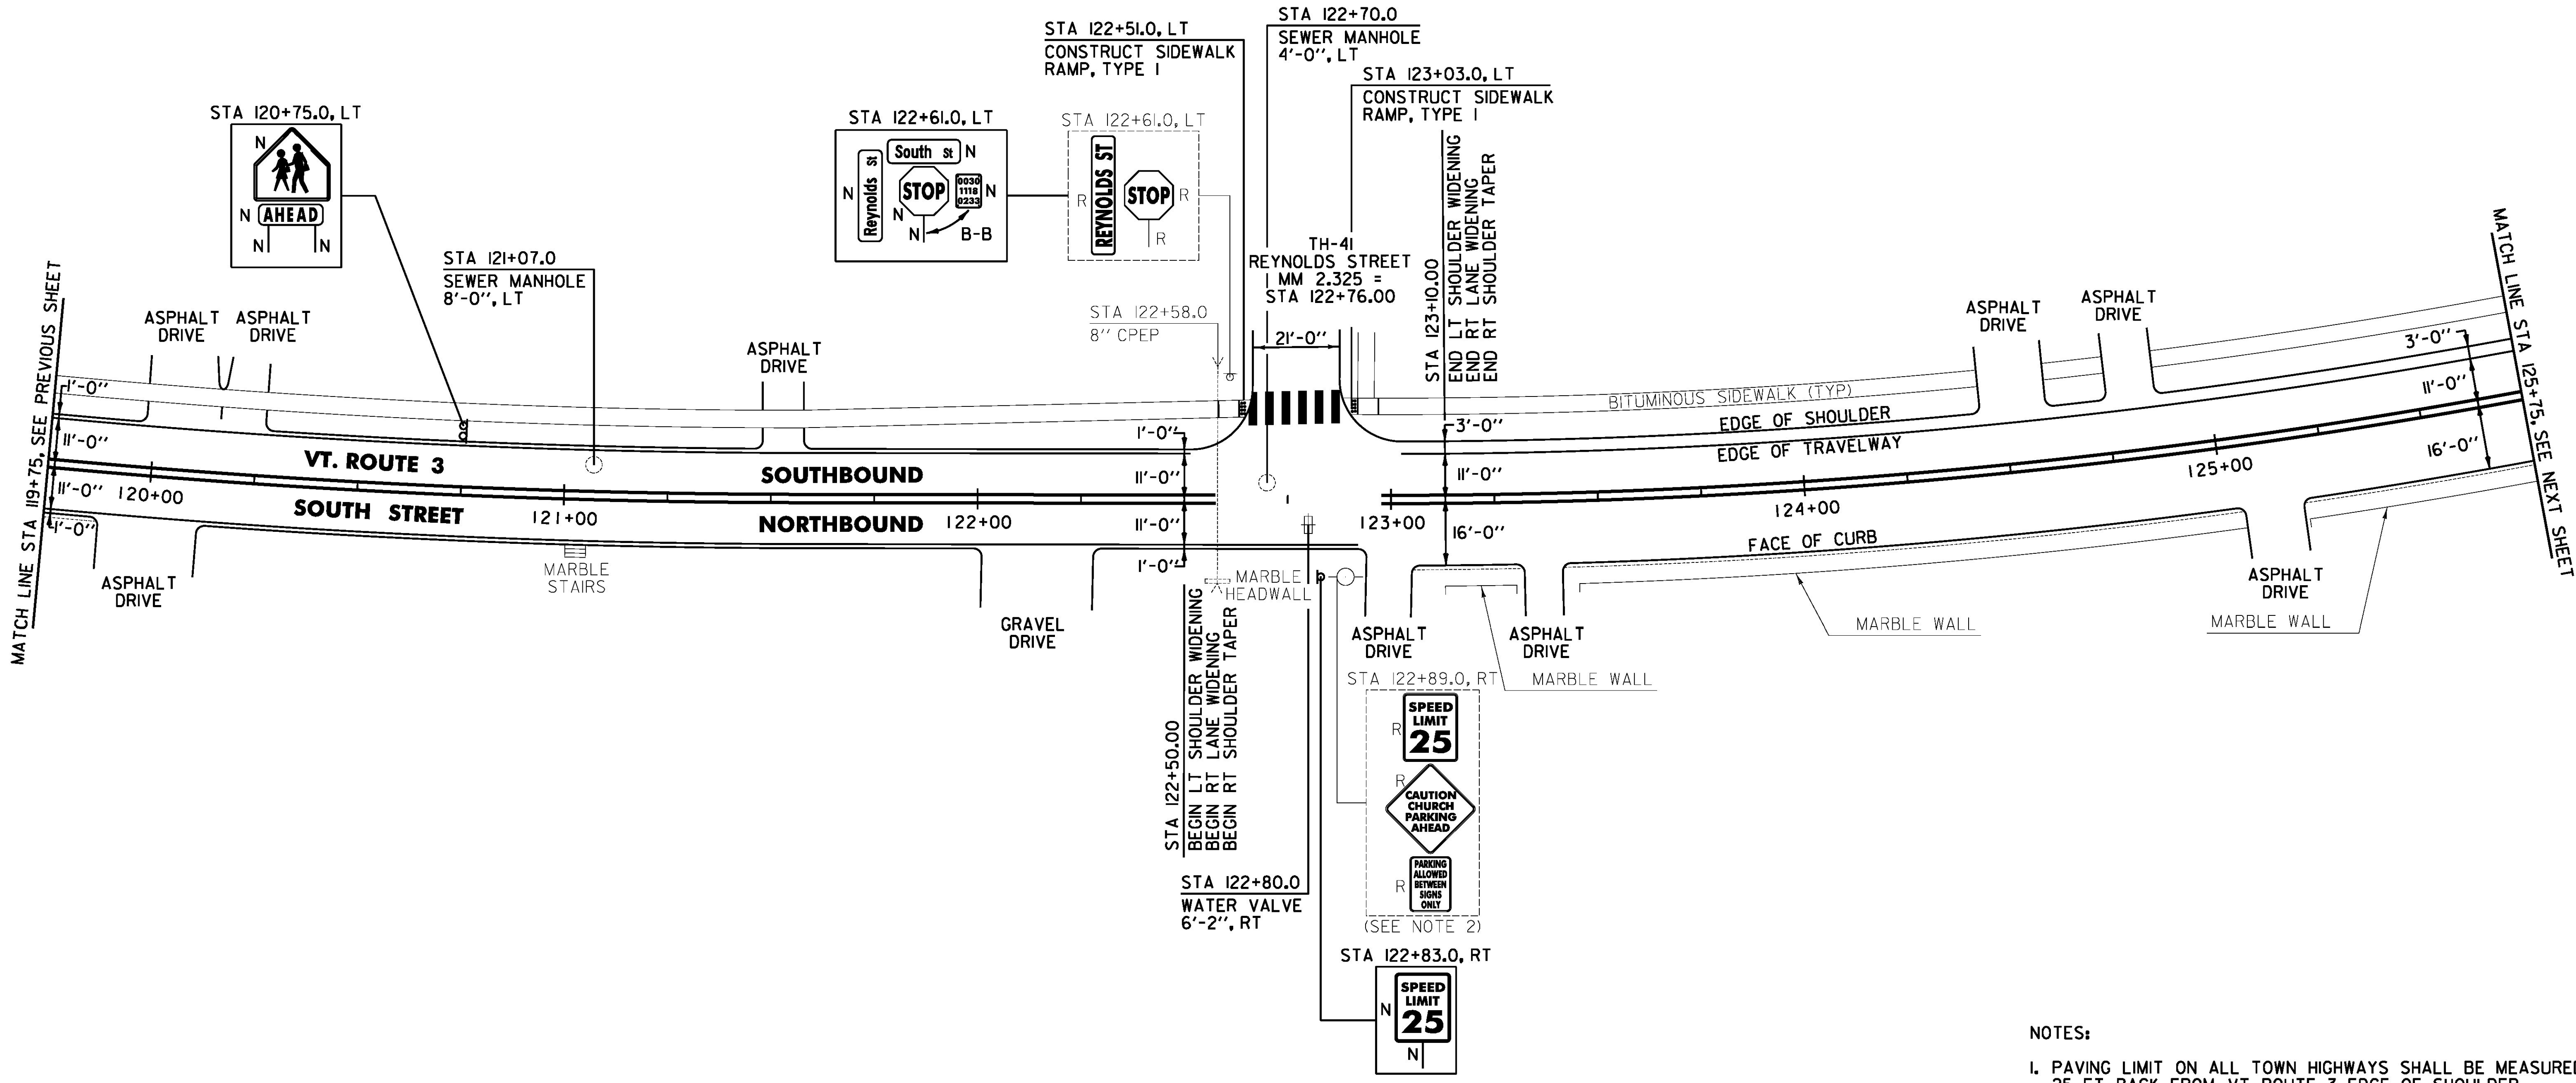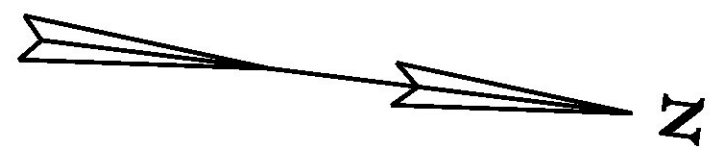

604.42 CHANGING ELEVATION OF SEWER MANHOLES
 PROCTOR:
 STA 121+07.0 LT
 STA 122+70.0 LT

616.28 CAST-IN-PLACE CONCRETE CURB, TYPE B
 PROCTOR:
 STA 122+51.0 LT (14.0 LF)
 STA 123+03.0 LT (14.0 LF)

618.10 PORTLAND CEMENT CONCRETE SIDEWALK, 5 INCH
 PROCTOR:
 STA 122+51.0 LT (6.7 SY)
 STA 123+03.0 LT (6.7 SY)

618.30 DETECTABLE WARNING SURFACE
 PROCTOR:
 STA 122+51.0 LT (10.0 SF)
 STA 123+03.0 LT (10.0 SF)

629.20 ADJUST ELEVATION OF VALVE BOX
 PROCTOR:
 STA 122+80.0 RT

- NOTES:
- PAVING LIMIT ON ALL TOWN HIGHWAYS SHALL BE MEASURED 25 FT BACK FROM VT. ROUTE 3 EDGE OF SHOULDER UNLESS DENOTED OTHERWISE ON THE PLANS OR AS DIRECTED BY THE ENGINEER.
 - EXISTING SIGNS ARE MOUNTED TO THE UTILITY POLE.

SIGN LEGEND
 R = REMOVE
 S = SALVAGE
 N = NEW
 RET = RETAIN
 B-B = BACK TO BACK
 EXISTING = -----
 NEW = _____
 ⊕ = RETURN TO THE TOWN OF PROCTOR

NOT TO SCALE
PROJECT LAYOUT SHEET #25

| | |
|-----------------|------------------------|
| PROJECT NAME: | RUTLAND CITY - PROCTOR |
| PROJECT NUMBER: | STP 2728(1) |
| FILE NAME: | p07d282.dgn |
| PROJECT LEADER: | D.E.G. |
| DESIGNED BY: | L.M.B. |
| IPARM FILE: | p07d282i25.1 |
| PLOT DATE: | 7/19/2013 |
| DRAWN BY: | W.G.P. |
| CHECKED BY: | J.P.S. |
| SHEET | 70 OF 392 |

FILE NAME: I:\17765\CA000\WSTIN\STP 2728\p07d282.dgn - rml_25.dgn
 DATE/TIME: 7/19/2013 4:49:16
 USER: J.P.S.