

646.406 DURABLE 4 INCH WHITE LINE, RECESSED POLYUREA
 (ALL LINES WILL INCLUDE EDGE LINE BREAKS AND RADIUS FOR TOWN HIGHWAYS)
 PROCTOR:
 STA 125+75.00 - STA 131+75.00 EDGE LINE LT
 STA 128+89.00 - STA 131+75.00 EDGE LINE RT



646.602 TEMPORARY 4 INCH WHITE LINE, PAINT
 (ALL LINES WILL INCLUDE EDGE LINE BREAKS AND RADIUS FOR TOWN HIGHWAYS)
 PROCTOR:
 STA 125+75.00 - STA 131+75.00 EDGE LINE LT
 STA 128+89.00 - STA 131+75.00 EDGE LINE RT

646.446 DURABLE 8 INCH WHITE LINE, RECESSED POLYUREA
 PROCTOR:
 STA 128+87.00 - STA 128+99.00 FIRE HYDRANT NO PARKING ZONE, RT

675.50 REMOVING SIGNS
 AS SHOWN - 4
675.60 ERECTING SALVAGED SIGNS
 AS SHOWN - 2

646.416 DURABLE 4 INCH YELLOW LINE, RECESSED POLYUREA
 (ALL LINES WILL INCLUDE C/L BREAKS FOR TOWN HIGHWAYS) S=SOLID, D=DASHED
 PROCTOR:
 STA 125+75.00 - STA 131+75.00

646.612 TEMPORARY 4 INCH YELLOW LINE, PAINT
 (ALL LINES WILL INCLUDE C/L BREAKS FOR TOWN HIGHWAYS) S=SOLID, D=DASHED
 PROCTOR:
 STA 125+75.00 - STA 131+75.00

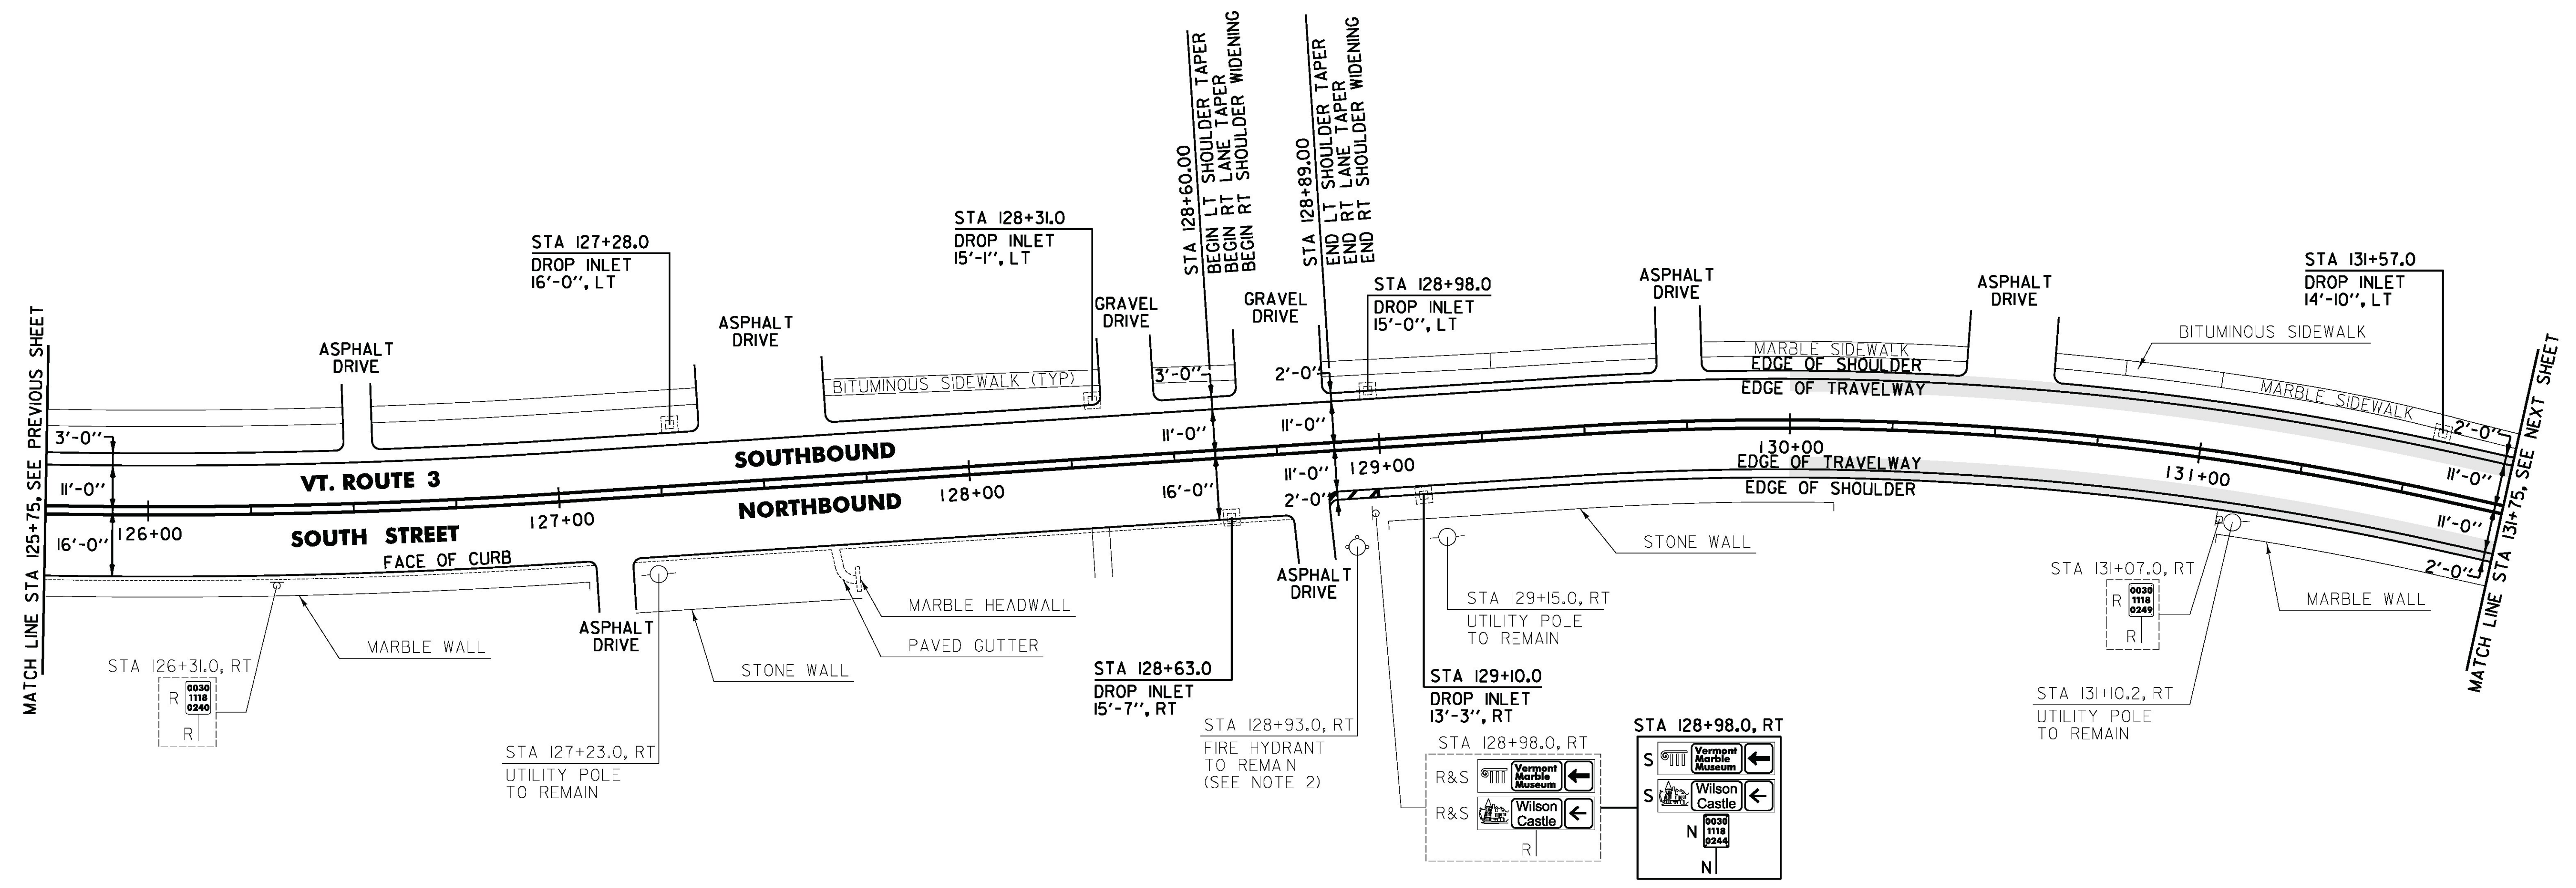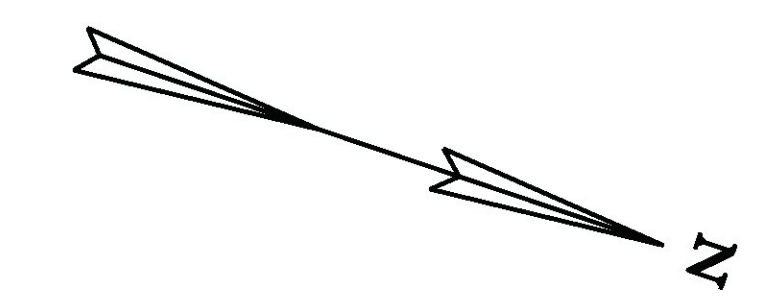

604.412, 604.415 OR 604.418 REHAB. DROP INLETS, CATCH BASINS OR MANHOLES (SEE NOTE 1)
 PROCTOR:
 STA 127+28.0 LT
 STA 128+31.0 LT
 STA 128+63.0 RT
 STA 128+98.0 LT
 STA 129+10.0 RT
 STA 131+57.0 LT

- NOTES:**
1. THE CONTRACTOR SHALL REHABILITATE THE EXISTING DROP INLETS, CATCH BASINS, OR MANHOLES TO A DEPTH AS DIRECTED BY THE ENGINEER. ALL REHABILITATION WORK WILL BE PAID FOR UNDER THE APPLICABLE REHABILITATION ITEM AS DIRECTED BY THE ENGINEER. ALL EXISTING UTILITIES MARKED "TO REMAIN" SHALL NOT BE ALTERED OR REHABILITATED UNLESS DIRECTED OTHERWISE BY THE ENGINEER.
 2. SEE SHEET 44 FOR FIRE HYDRANT PAVEMENT MARKING DETAIL.
 3. SEE SHEET 31 FOR PAVEMENT REPAIR DETAIL.

SIGN LEGEND
 R = REMOVE
 S = SALVAGE
 N = NEW
 RET = RETAIN
 B-B = BACK TO BACK
 EXISTING = - - - - -
 NEW = _____
 ⊕ = RETURN TO THE TOWN OF PROCTOR

PROJECT LAYOUT SHEET #26	NOT TO SCALE	
	PROJECT NAME: RUTLAND CITY - PROCTOR	PROJECT NUMBER: STP 2728(1)
	FILE NAME: p07d282.dgn PROJECT LEADER: D.E.G. DESIGNED BY: L.M.B. IPARM FILE: p07d282i26.l	PLOT DATE: 7/19/2013 DRAWN BY: W.G.P. CHECKED BY: J.P.S. SHEET 71 OF 392

FILE NAME: U:\177653\CA000\WSTIN\STP 2728\p07d282.dwg - rml_26.dgn
 DATE/TIME: 7/19/2013 4:49:16