
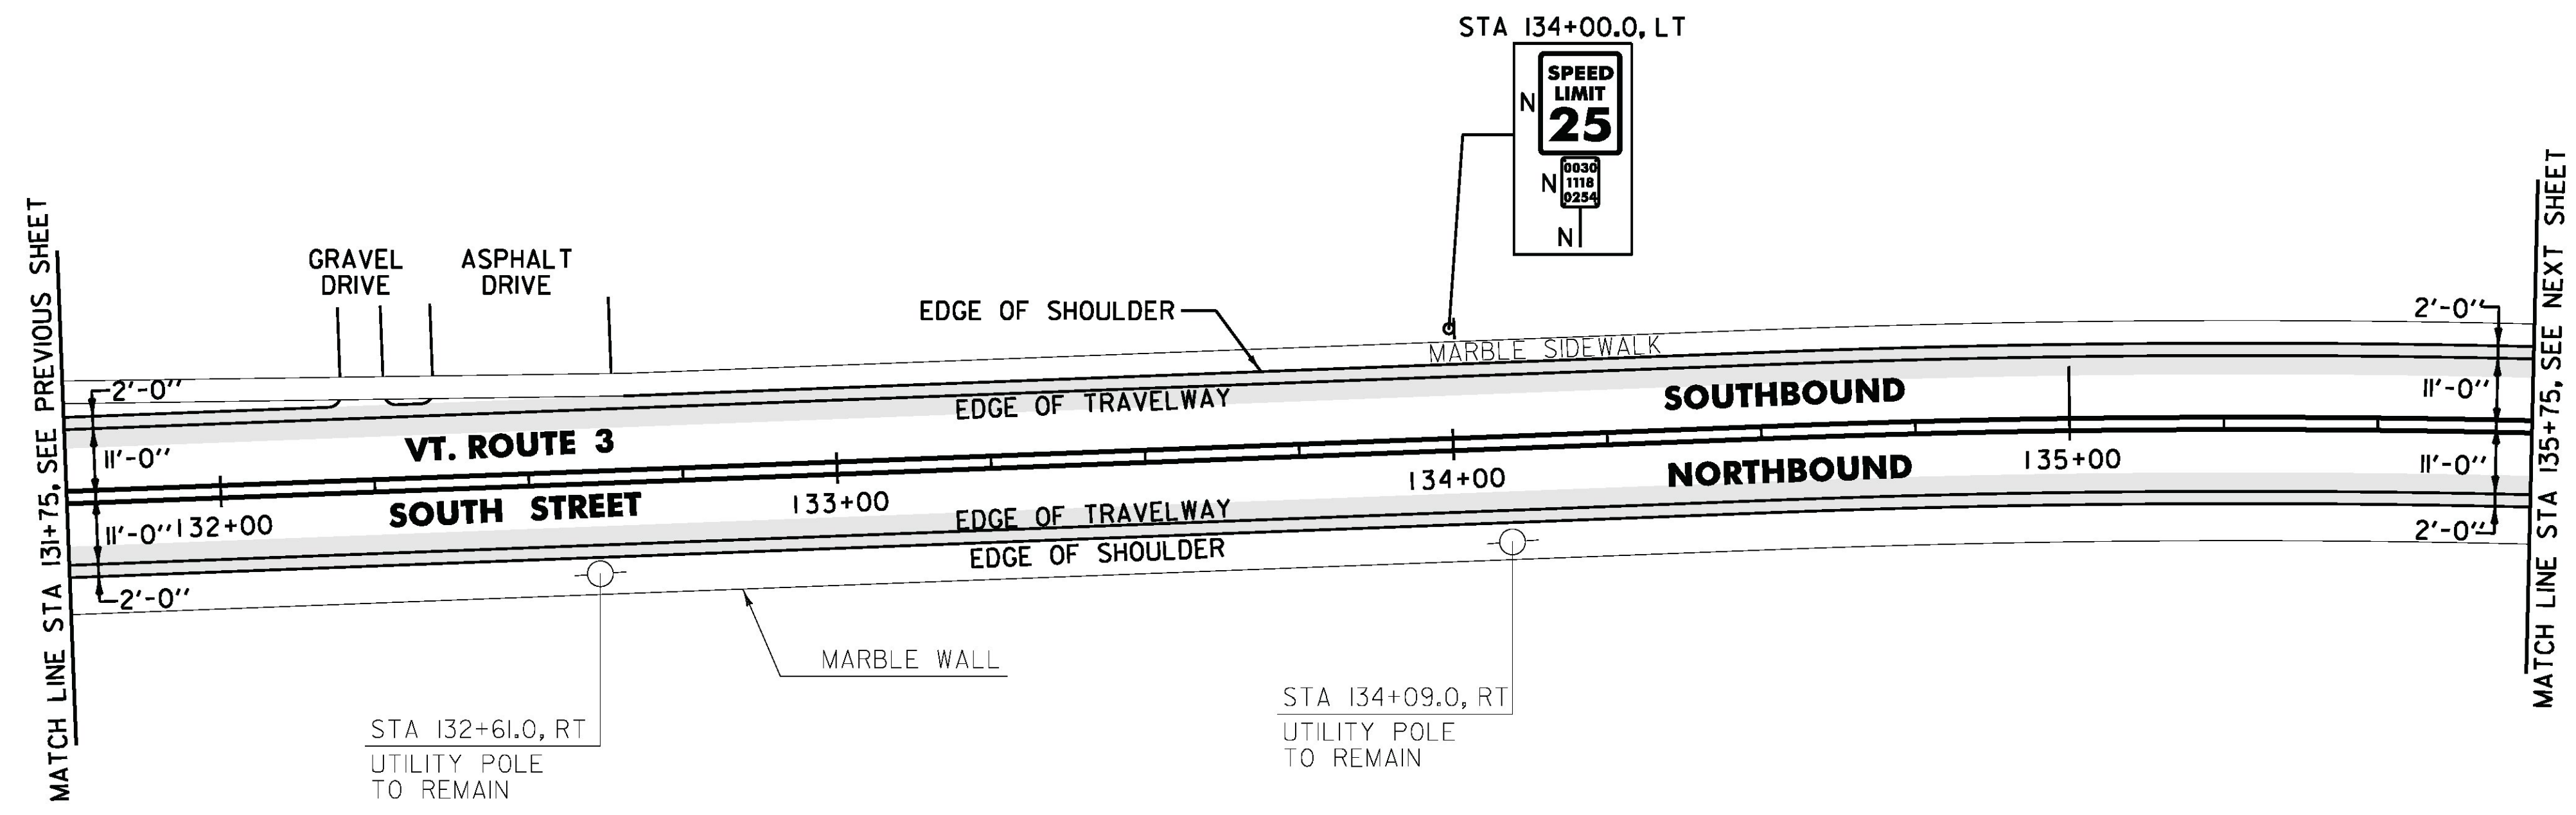


**646.406 DURABLE 4 INCH WHITE LINE, RECESSED POLYUREA**  
 (ALL LINES WILL INCLUDE EDGE LINE BREAKS AND RADIUS FOR TOWN HIGHWAYS)  
 PROCTOR:  
 STA 131+75.00 - STA 135+75.00 EDGE LINE LT & RT

**646.416 DURABLE 4 INCH YELLOW LINE, RECESSED POLYUREA**  
 (ALL LINES WILL INCLUDE C/L BREAKS FOR TOWN HIGHWAYS) S=SOLID, D=DASHED  
 PROCTOR:  
 STA 131+75.00 - STA 135+75.00

**646.602 TEMPORARY 4 INCH WHITE LINE, PAINT**  
 (ALL LINES WILL INCLUDE EDGE LINE BREAKS AND RADIUS FOR TOWN HIGHWAYS)  
 PROCTOR:  
 STA 131+75.00 - STA 135+75.00 EDGE LINE LT & RT

**646.612 TEMPORARY 4 INCH YELLOW LINE, PAINT**  
 (ALL LINES WILL INCLUDE C/L BREAKS FOR TOWN HIGHWAYS) S=SOLID, D=DASHED  
 PROCTOR:  
 STA 131+75.00 - STA 135+75.00

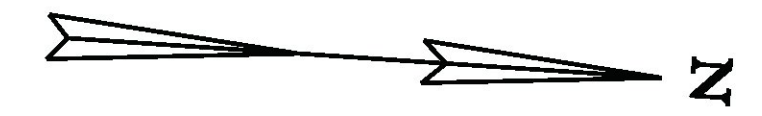

NOTE:  
 1. SEE SHEET 31 FOR PAVEMENT REPAIR DETAIL.

PAVEMENT REPAIR AREA (SEE NOTE 1)

**SIGN LEGEND**  
 R = REMOVE  
 S = SALVAGE  
 N = NEW  
 RET = RETAIN  
 B-B = BACK TO BACK  
 EXISTING = -----  
 NEW = \_\_\_\_\_  
 ⊕ = RETURN TO THE TOWN OF PROCTOR

**NOT TO SCALE**  
**PROJECT LAYOUT SHEET #27**

PROJECT NAME:	RUTLAND CITY - PROCTOR
PROJECT NUMBER:	STP 2728(1)
FILE NAME:	p07d282.dgn
PROJECT LEADER:	D.E.G.
DESIGNED BY:	L.M.B.
IPARM FILE:	p07d282i27.1
PLOT DATE:	7/19/2013
DRAWN BY:	W.G.P.
CHECKED BY:	J.P.S.
SHEET	72 OF 392

FILE NAME : U:\177525\ACADD\WSTIN\STP 2728\p07d282.dgn -rwl\_27.dgn  
 DATE/TIME : 7/19/2013 4:16  
 USER :