




* 20% REDUCTION IN SPACING
 COLOR: WHITE BORDER & TEXT (REFLECTORIZED)
 GREEN BACKGROUND (REFLECTORIZED)
 MATERIAL: PER VTRANS STANDARD E-123
 LOCATION: U.S. BR 4
 RUTLAND CITY:
 STA 75+05.0, RT - DOUBLE SIDED

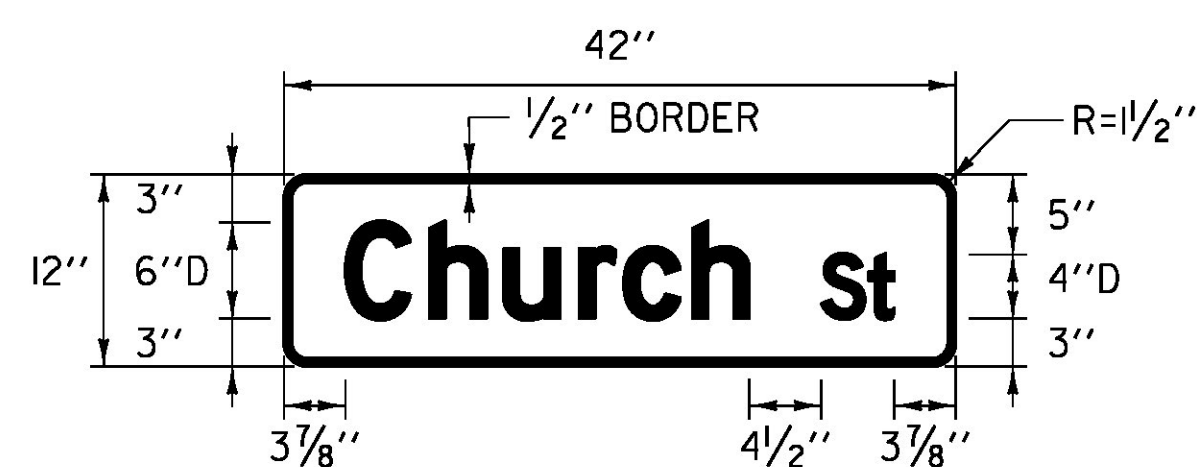


COLOR: WHITE BORDER & TEXT (REFLECTORIZED)
 GREEN BACKGROUND (REFLECTORIZED)
 MATERIAL: PER VTRANS STANDARD E-123
 LOCATION: U.S. BR 4
 RUTLAND CITY:
 STA 88+04.0, LT - DOUBLE SIDED

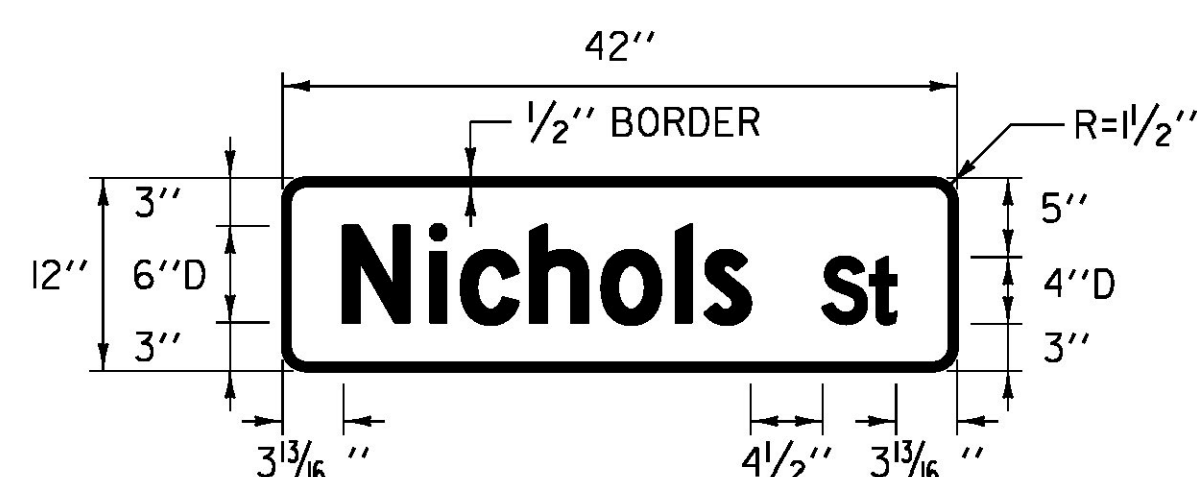


COLOR: WHITE BORDER & TEXT (REFLECTORIZED)
 GREEN BACKGROUND (REFLECTORIZED)
 MATERIAL: PER VTRANS STANDARD E-123
 LOCATION: U.S. BR 4
 RUTLAND CITY:
 STA 97+38.0, LT - DOUBLE SIDED

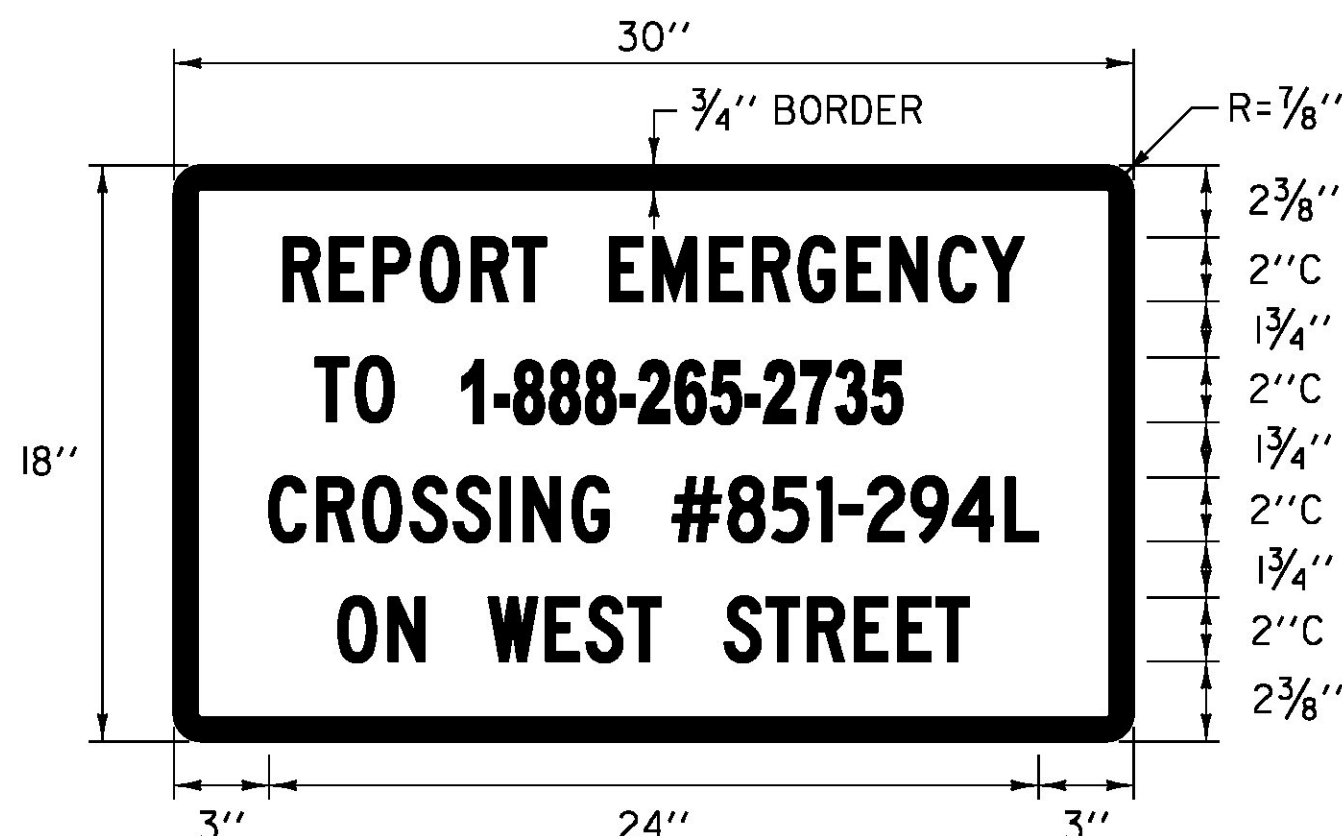


COLOR: WHITE BORDER & TEXT (REFLECTORIZED)
 BLUE BACKGROUND (REFLECTORIZED)
 MATERIAL: PER VTRANS STANDARD E-132
 LOCATION: U.S. BR 4
 RUTLAND CITY:
 STA 33+35.0, RT
 WEST STREET
 RUTLAND CITY:
 STA W 0+52.0, RT
 STA W 0+75.0, RT
 STA W 1+49.0, LT

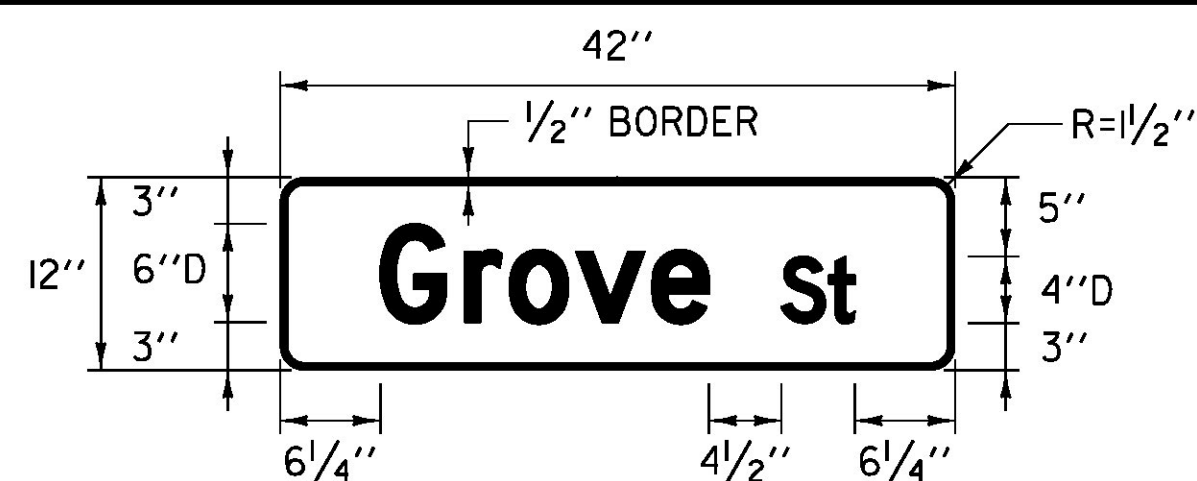


COLOR: WHITE BORDER & TEXT (REFLECTORIZED)
 GREEN BACKGROUND (REFLECTORIZED)
 MATERIAL: PER VTRANS STANDARD E-123
 LOCATION: U.S. BR 4
 RUTLAND CITY:
 STA 75+45.1, LT - DOUBLE SIDED

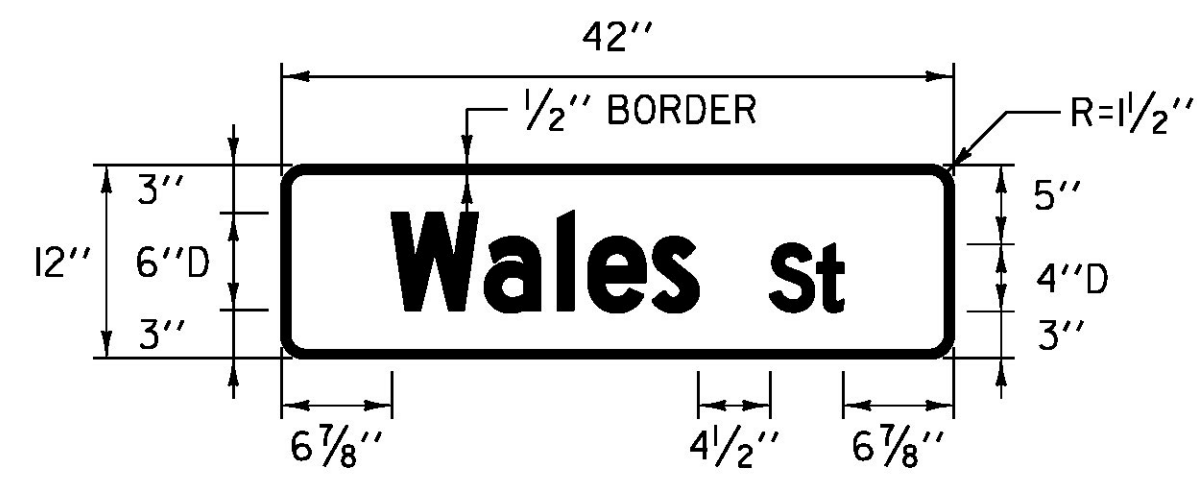

COLOR: WHITE BORDER & TEXT (REFLECTORIZED)
 GREEN BACKGROUND (REFLECTORIZED)
 MATERIAL: PER VTRANS STANDARD E-123
 LOCATION: U.S. BR 4
 RUTLAND CITY:
 STA 88+18.0, RT - DOUBLE SIDED

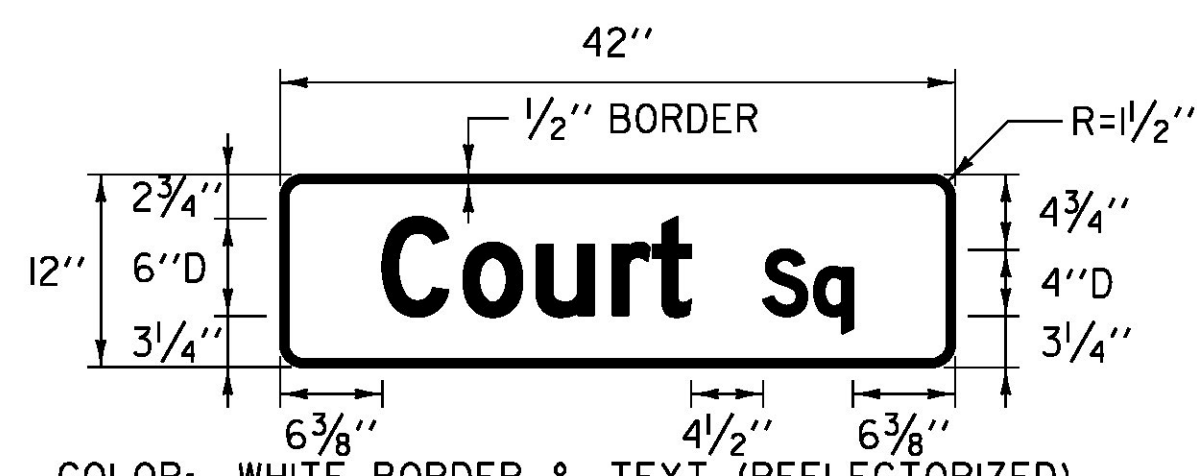


COLOR: WHITE BORDER & TEXT (REFLECTORIZED)
 GREEN BACKGROUND (REFLECTORIZED)
 MATERIAL: PER VTRANS STANDARD E-123
 LOCATION: U.S. BR 4
 RUTLAND CITY:
 STA 100+03.0, RT - DOUBLE SIDED

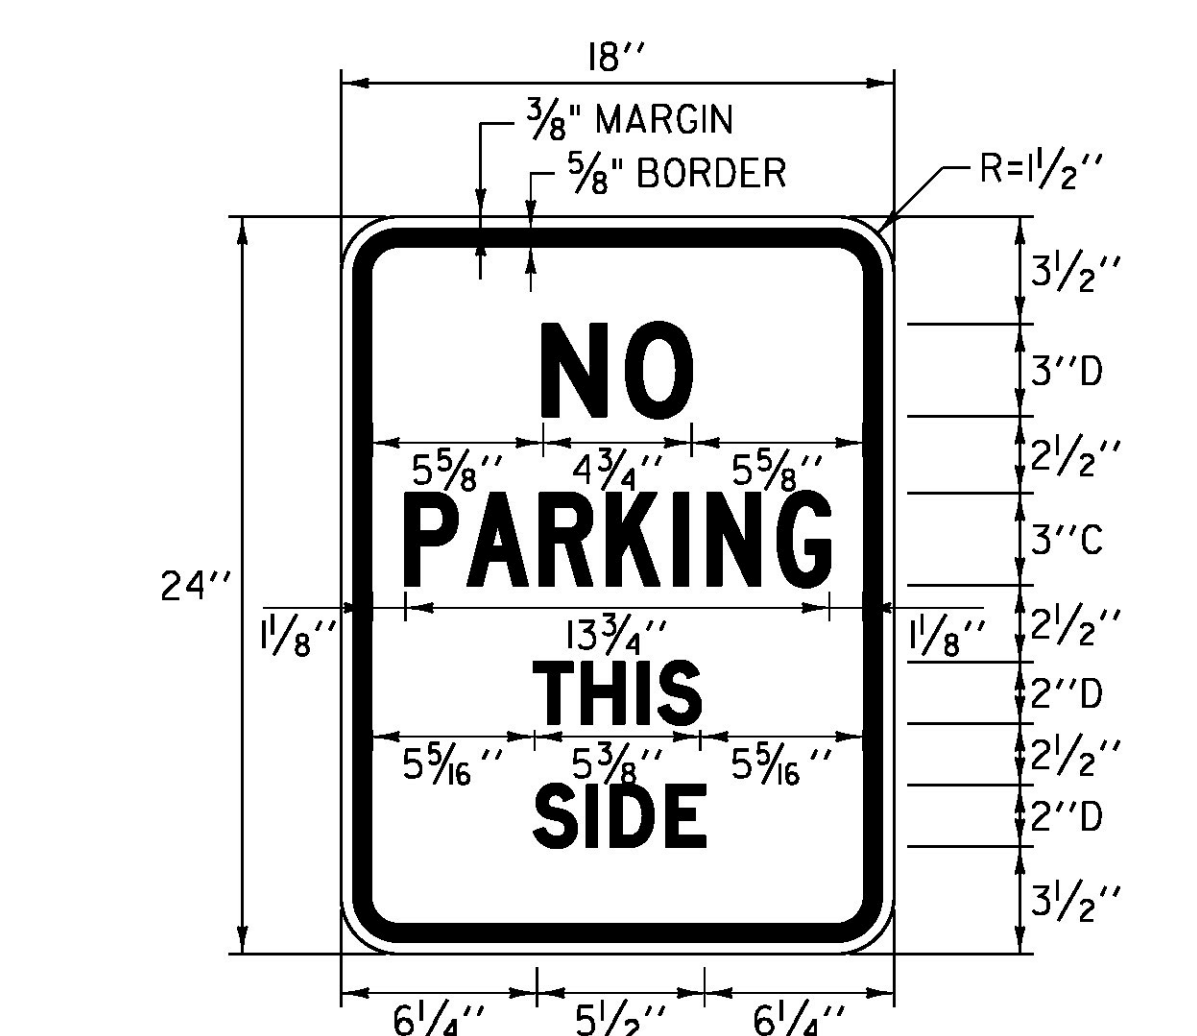


COLOR: BLACK BORDER & TEXT
 WHITE BACKGROUND (REFLECTORIZED)
 MATERIAL: PER VTRANS STANDARD E-140
 LOCATION: U.S. BR 4
 RUTLAND CITY:
 STA 87+39.0 LT
 STA 89+69.0 LT
 STA 90+03.0 RT
 STA 95+68.0 RT
 STA 95+87.0 LT
 STA 98+72.0 LT
 STA 99+60.0 LT
 STA 100+32.0 LT
 STA 100+36.0 RT
 STA 101+16.0 LT


VT. ROUTE 3
 PROCTOR:
 STA 147+65.0 LT
 STA 149+68.0 LT

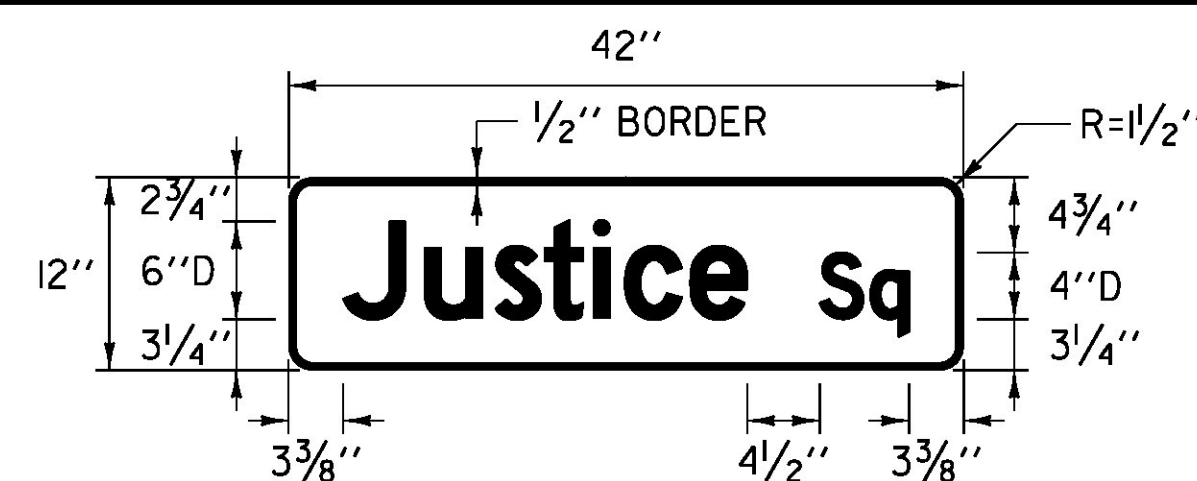


COLOR: WHITE BORDER & TEXT (REFLECTORIZED)
 GREEN BACKGROUND (REFLECTORIZED)
 MATERIAL: PER VTRANS STANDARD E-123
 LOCATION: U.S. BR 4
 RUTLAND CITY:
 STA 75+45.1, LT - DOUBLE SIDED

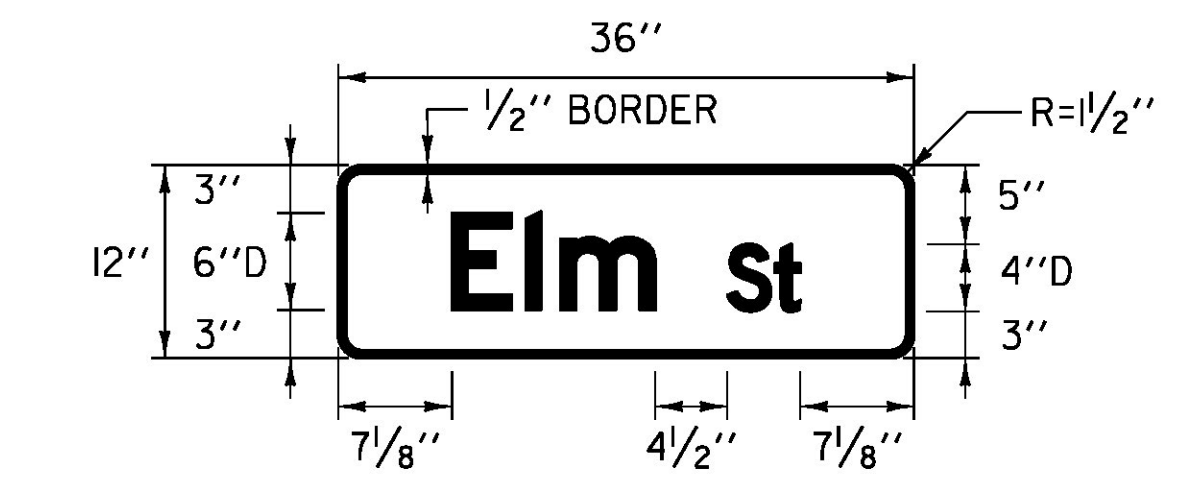


COLOR: WHITE BORDER & TEXT (REFLECTORIZED)
 GREEN BACKGROUND (REFLECTORIZED)
 MATERIAL: PER VTRANS STANDARD E-123
 LOCATION: U.S. BR 4
 RUTLAND CITY:
 STA 90+97.0, LT - DOUBLE SIDED

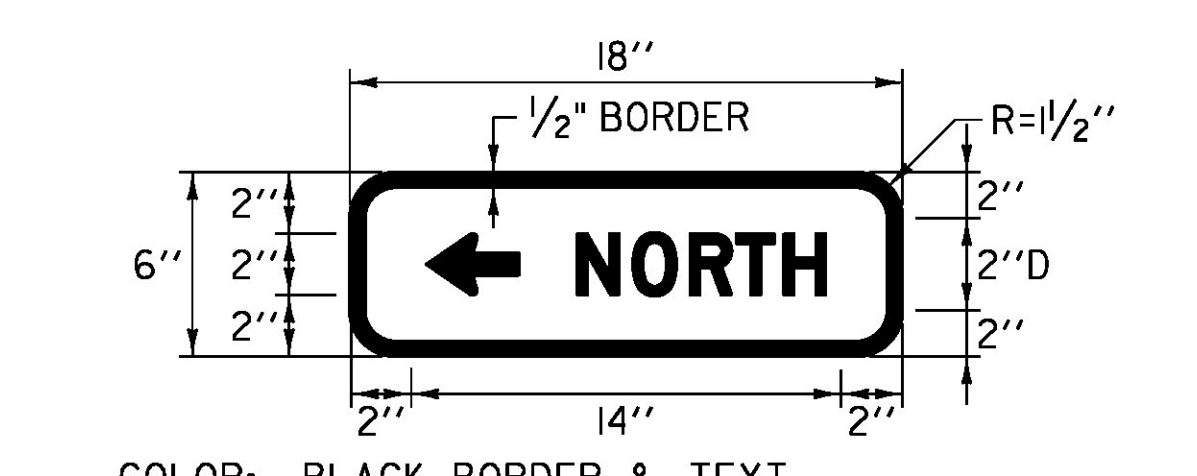


COLOR: BLACK BORDER & TEXT
 WHITE BACKGROUND (REFLECTORIZED)
 MATERIAL: PER VTRANS STANDARD E-131B
 LOCATION: U.S. BR 4
 RUTLAND CITY:
 STA 88+15.0, RT

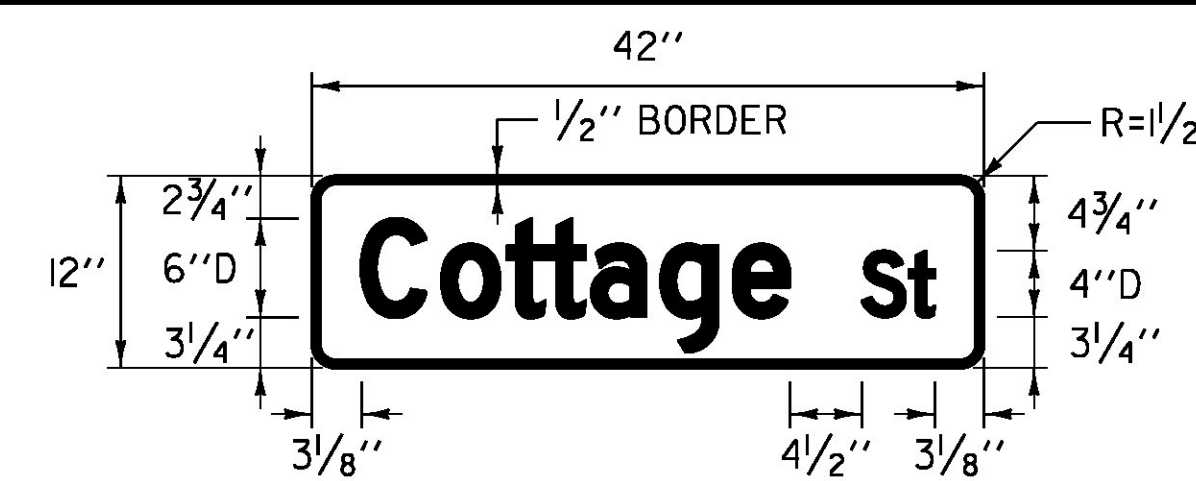

COLOR: WHITE BORDER & TEXT (REFLECTORIZED)
 GREEN BACKGROUND (REFLECTORIZED)
 MATERIAL: PER VTRANS STANDARD E-123
 LOCATION: U.S. BR 4
 RUTLAND CITY:
 STA 84+09.0, LT - DOUBLE SIDED

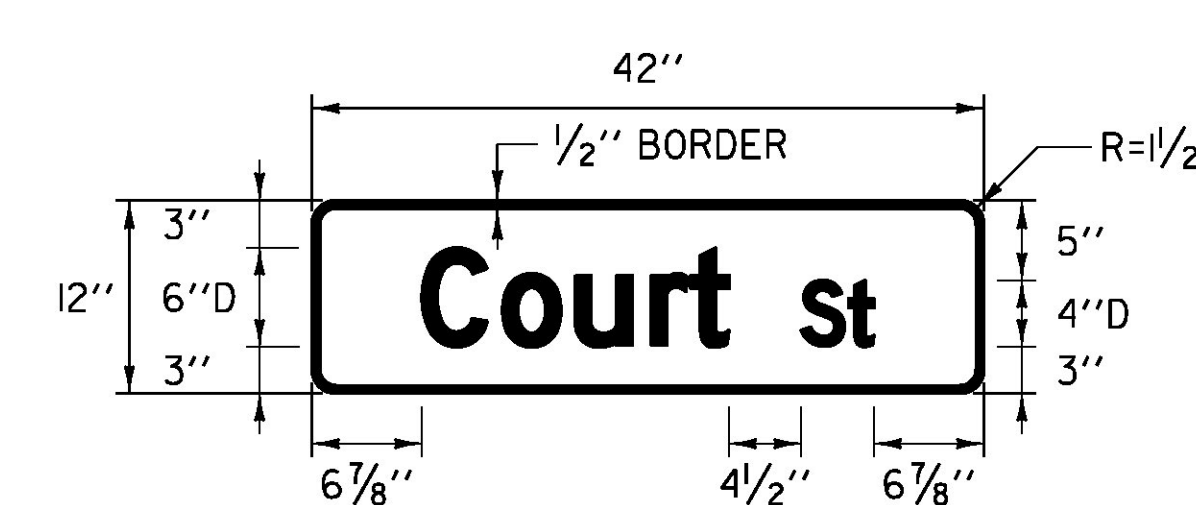

COLOR: WHITE BORDER & TEXT (REFLECTORIZED)
 GREEN BACKGROUND (REFLECTORIZED)
 MATERIAL: PER VTRANS STANDARD E-123
 LOCATION: U.S. BR 4
 RUTLAND CITY:
 STA 93+96.0, RT - DOUBLE SIDED

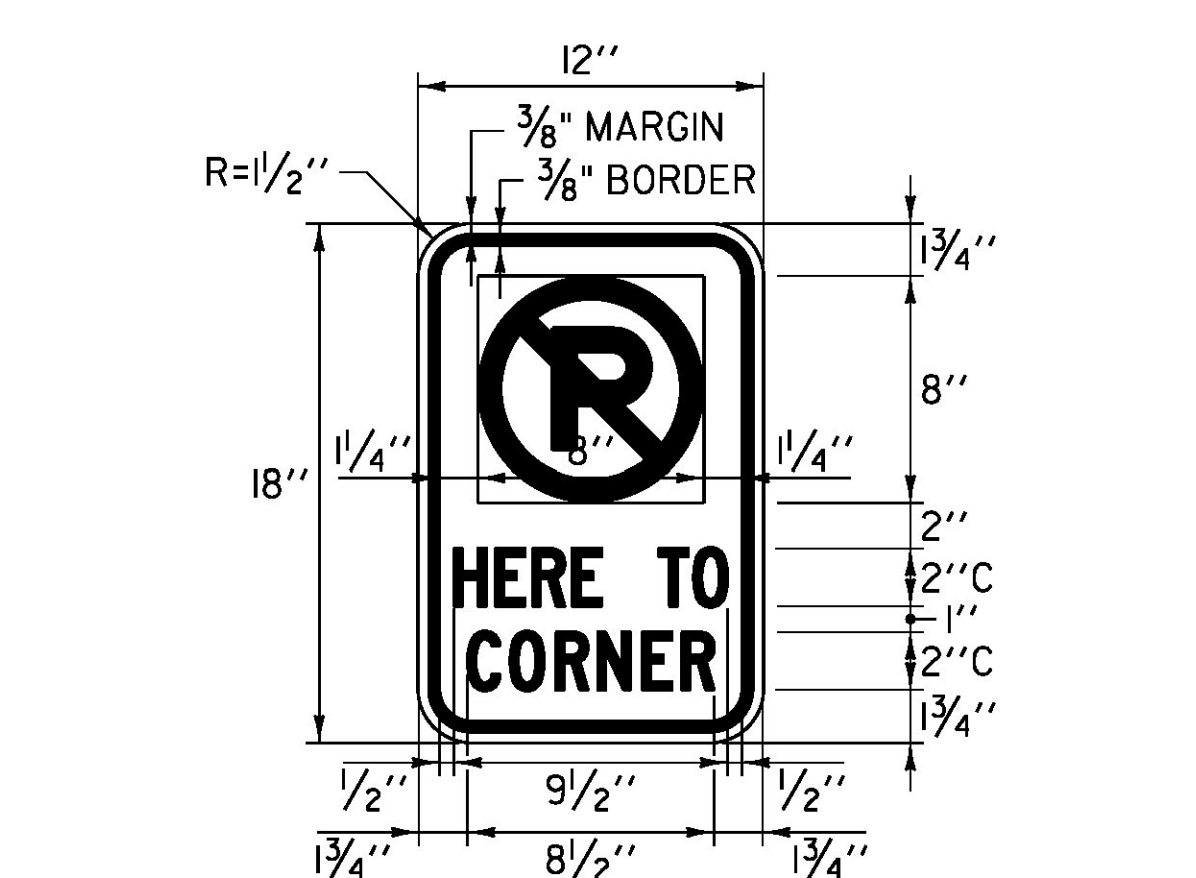

COLOR: BLACK BORDER & TEXT
 WHITE BACKGROUND (REFLECTORIZED)
 MATERIAL: PER VTRANS STANDARD E-143B
 LOCATION: U.S. BR 4
 RUTLAND CITY:
 STA 55+98.0 RT
 STA 60+43.0 LT
 STA 83+40.0 RT
 STA 83+62.0 LT

NOTE:
 1. ALL STREET NAME SIGNS SHALL BE 1/8" SHEET ALUMINUM WITH 12" BRACKETS.

NOT TO SCALE

SIGN DETAIL SHEET #2	PROJECT NAME: RUTLAND CITY - PROCTOR
	PROJECT NUMBER: STP 2728(II)
	FILE NAME: p07d282.dgn
	PLOT DATE: 13-AUG-2013
	PROJECT LEADER: D.E.G.
	DRAWN BY: W.G.P.
	CHECKED BY: J.P.S.
	SHEET 120 OF 392