

646.406 DURABLE 4 INCH WHITE LINE, RECESSED POLYUREA
 (ALL LINES WILL INCLUDE EDGE LINE BREAKS AND RADIUS FOR TOWN HIGHWAYS)
 U.S. ROUTE 7:
 STA 22+96.80 - STA 24+00.00 EDGE LINE LT & RT
 STA 22+96.80 - STA 24+00.00 DASHED LANE LINE LT
 STA 22+96.80 - STA 24+00.00 DASHED LANE LINE RT
 STA 22+96.80 - STA 23+86.00 SOLID LANE LINE RT
 STA 22+96.80 - STA 24+00.00 DOTTED LANE LINE LT

646.416 DURABLE 4 INCH YELLOW LINE, RECESSED POLYUREA
 (ALL LINES WILL INCLUDE C/L BREAKS FOR TOWN HIGHWAYS)
 U.S. ROUTE 7:
 STA 22+96.80 - STA 24+00.00 DOUBLE SOLID MEDIAN LT/CL

646.602 TEMPORARY 4 INCH WHITE LINE, PAINT
 (ALL LINES WILL INCLUDE EDGE LINE BREAKS AND RADIUS FOR TOWN HIGHWAYS)
 U.S. ROUTE 7:
 STA 22+96.80 - STA 24+00.00 EDGE LINE LT & RT
 STA 22+96.80 - STA 24+00.00 DASHED LANE LINE LT
 STA 22+96.80 - STA 24+00.00 DASHED LANE LINE RT
 STA 22+96.80 - STA 23+86.00 SOLID LANE LINE RT
 STA 22+96.80 - STA 24+00.00 DOTTED LANE LINE LT

646.456 DURABLE 8 INCH YELLOW LINE, RECESSED POLYUREA
 U.S. ROUTE 7:
 STA 22+96.80 - STA 24+00.00 HATCHED MEDIAN LT/CL



646.487 DURABLE 24 INCH STOP BAR, RECESSED TYPE I TAPE
 U.S. ROUTE 7:
 STA 23+87.00 RT

646.491 DURABLE LETTER OR SYMBOL, TYPE I TAPE
 U.S. ROUTE 7:
 STA 23+21.21 RT, "O,N,L,Y" (4 EA)
 STA 23+81.25 RT, "ARROW" (1EA)

646.612 TEMPORARY 4 INCH YELLOW LINE, PAINT
 (ALL LINES WILL INCLUDE C/L BREAKS FOR TOWN HIGHWAYS)
 U.S. ROUTE 7:
 STA 22+96.80 - STA 24+00.00 DOUBLE SOLID MEDIAN LT/CL

646.682 TEMPORARY 24 INCH STOP BAR, PAINT
 U.S. ROUTE 7:
 STA 23+87.00 RT

646.692 TEMPORARY LETTER OR SYMBOL, PAINT
 U.S. ROUTE 7:
 STA 23+81.25 RT, "ARROW" (2 EA)

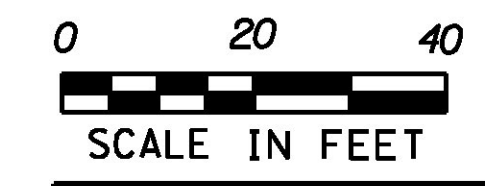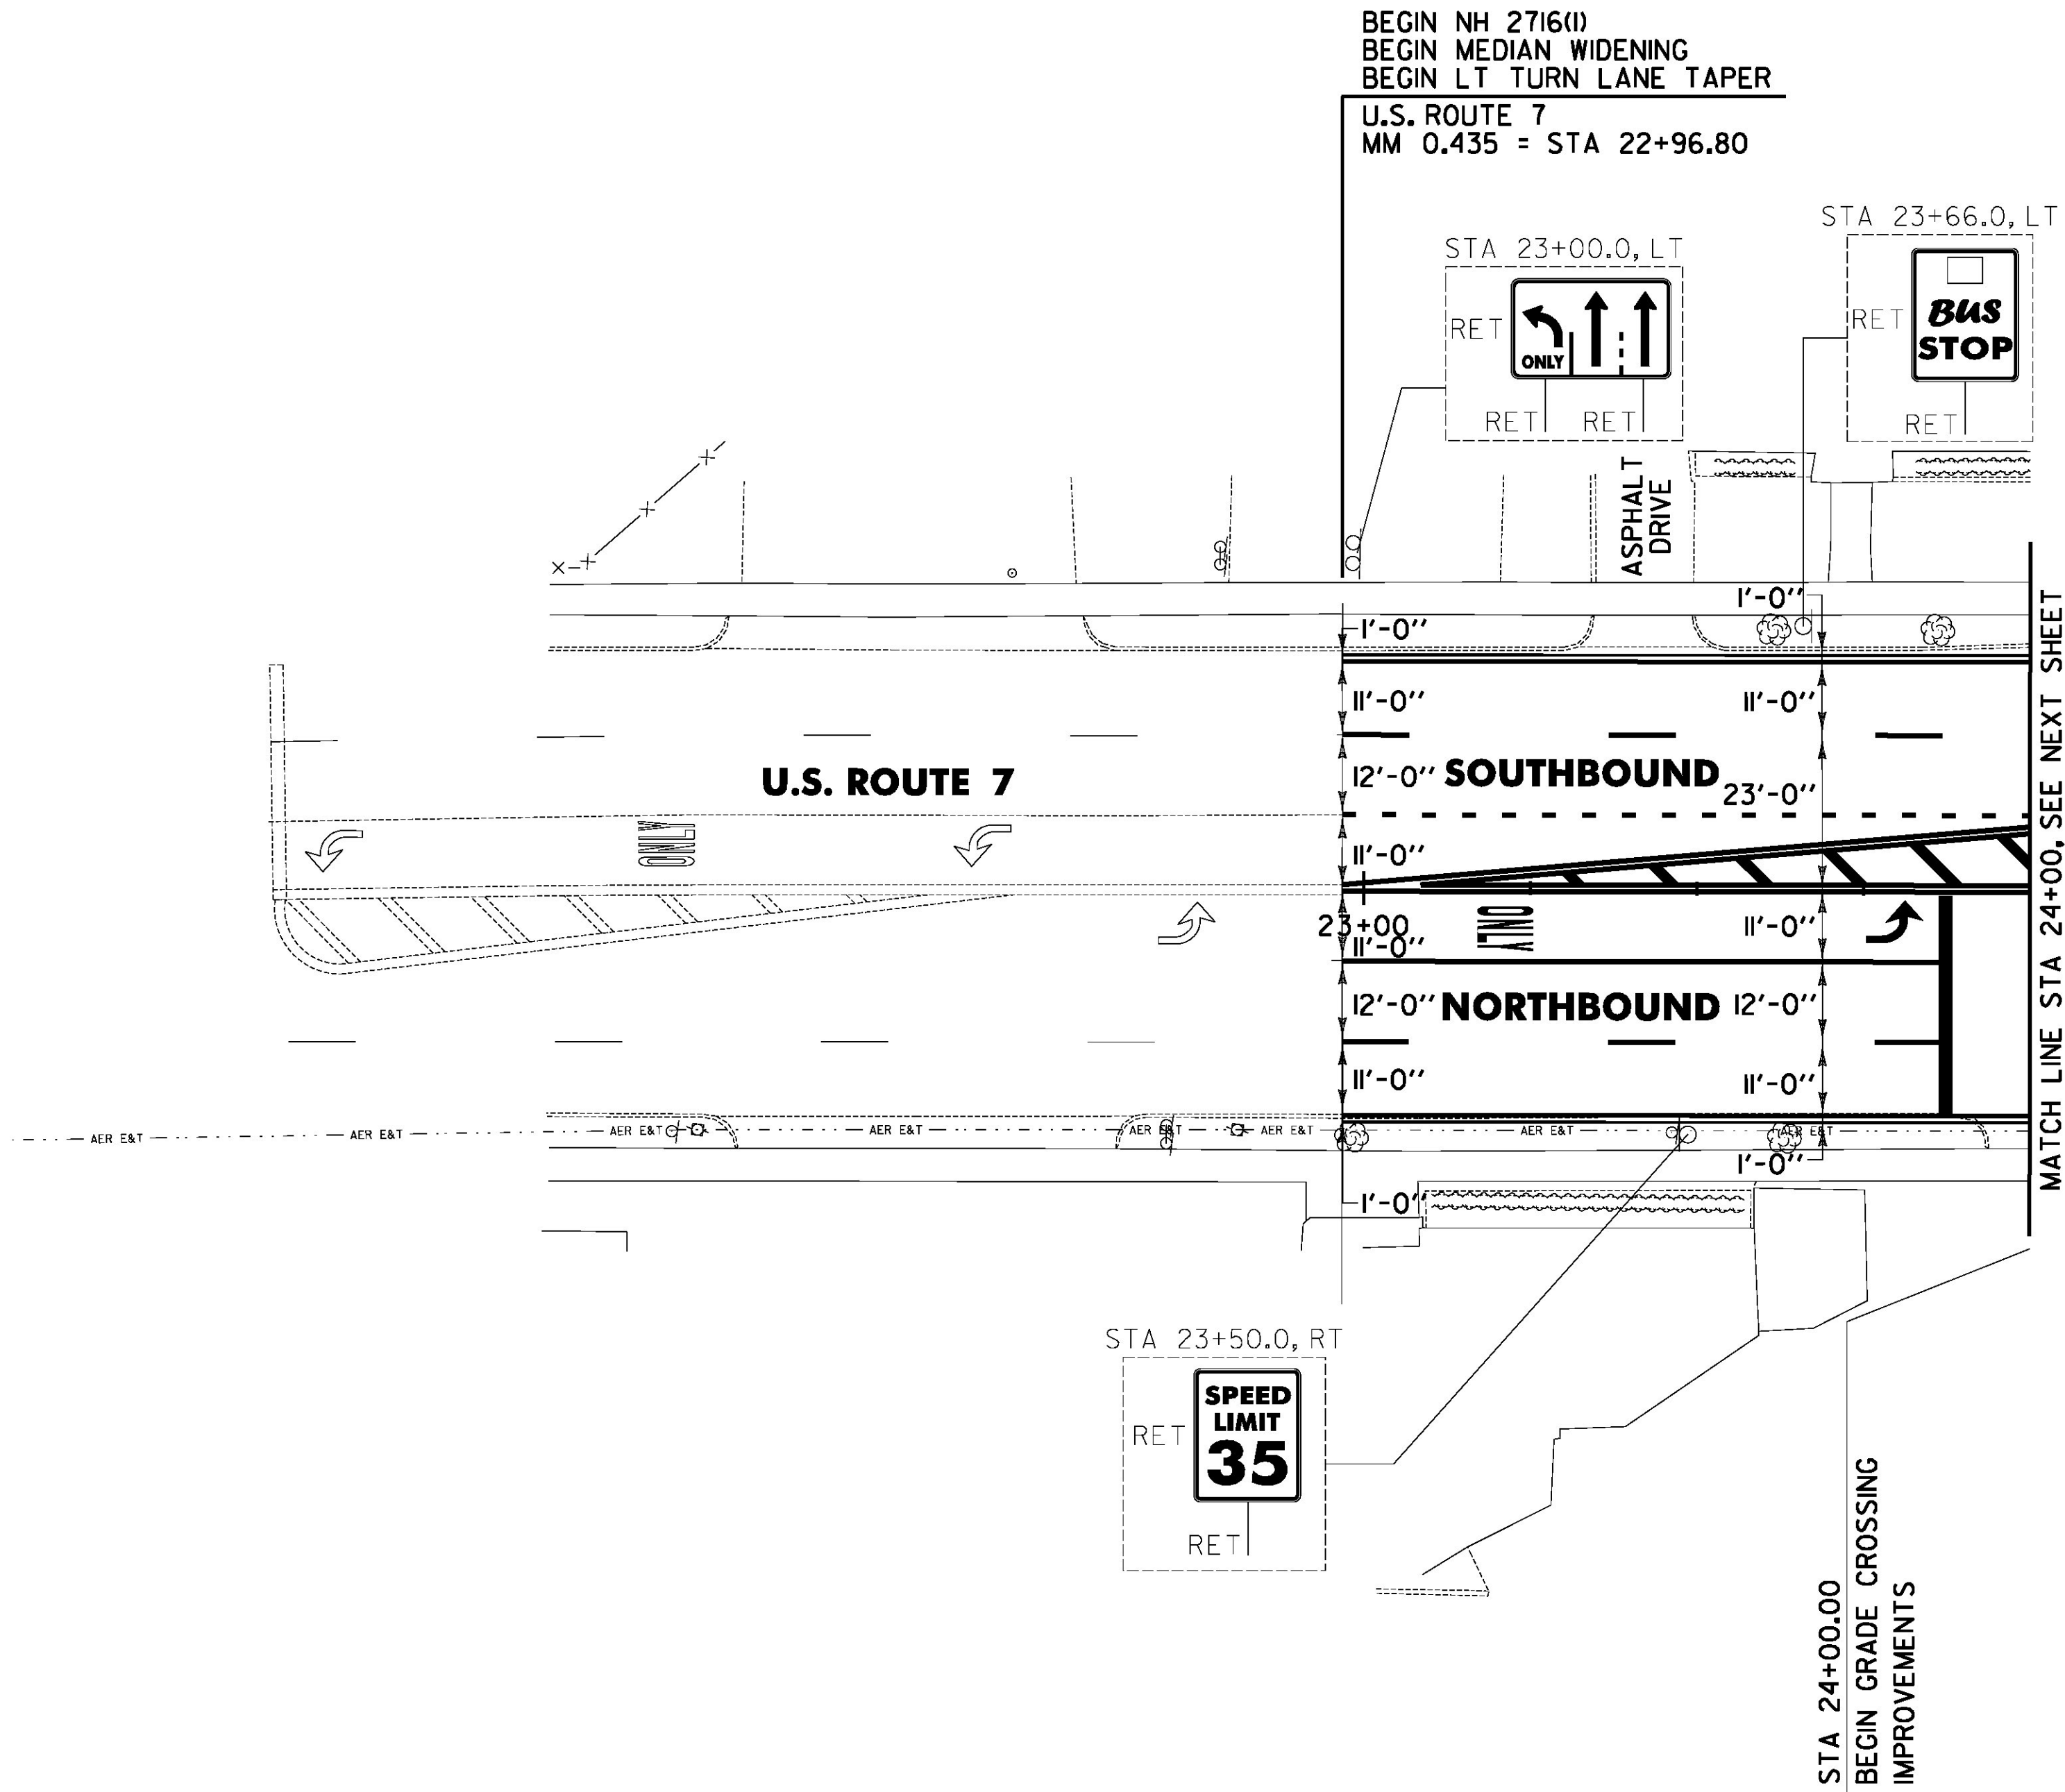

SIGN LEGEND
 R = REMOVE
 S = SALVAGE
 N = NEW
 RET = RETAIN
 B-B = BACK TO BACK
 EXISTING = -----
 NEW = _____
 ⊕ = RETURN TO THE CITY OF RUTLAND

FILE NAME = I:\17765\ACADD\17765\NH 2716\07d188.dwg
 DATE/TIME = 7/19/2013 4:49:16
 USER =

PROJECT LAYOUT SHEET #1	PROJECT NAME: RUTLAND CITY
	PROJECT NUMBER: NH 2716(I)
	FILE NAME: p07d188.dwg
	IPARM FILE: 07d188(I).I
	PLOT DATE: 7/19/2013
	DRAWN BY: W.G.P.
	CHECKED BY: D.E.G.
	SHEET 159 OF 392