

646.406 DURABLE 4 INCH WHITE LINE, RECESSED POLYUREA
 (ALL LINES WILL INCLUDE EDGE LINE BREAKS AND RADIUS FOR TOWN HIGHWAYS)
 U.S. ROUTE 7:
 STA 60+00.00 - STA 63+50.00 DASHED LANE LANE LT
 STA 60+00.00 - STA 63+50.00 DASHED LANE LINE RT
 STA 60+00.00 - STA 63+50.00 EDGE LINE LT & RT
 STA 60+00.00 - STA 60+75.00 DOTTED LANE LINE CL
 STA 60+00.00 - STA 60+75.00 DOTTED LANE LINE RT
 STA 60+75.00 - STA 62+30.00 SOLID LANE LINE RT
 STA 62+67.36 SOLID LANE LINE RT, EAST CENTER STREET
 STA 62+88.48 SOLID LANE LINE LT, CENTER STREET

646.416 DURABLE 4 INCH YELLOW LINE, RECESSED POLYUREA
 (ALL LINES WILL INCLUDE C/L BREAKS FOR TOWN HIGHWAYS)
 U.S. ROUTE 7:
 STA 60+00.00 - STA 60+75.00 DOUBLE SOLID RT
 STA 60+75.00 - STA 62+30.00 DOUBLE SOLID CL
 STA 62+88.48 DOUBLE SOLID LT, CENTER STREET
 STA 63+35.00 - STA 63+50.00 DOUBLE SOLID MEDIAN CL/RT
 STA 62+55.0, LT

646.602 TEMPORARY 4 INCH WHITE LINE, PAINT
 (ALL LINES WILL INCLUDE EDGE LINE BREAKS AND RADIUS FOR TOWN HIGHWAYS)
 U.S. ROUTE 7:
 STA 60+00.00 - STA 63+50.00 DASHED LANE LANE LT
 STA 60+00.00 - STA 63+50.00 DASHED LANE LINE RT
 STA 60+00.00 - STA 63+50.00 EDGE LINE LT & RT
 STA 60+00.00 - STA 60+75.00 DOTTED LANE LINE CL
 STA 60+00.00 - STA 60+75.00 DOTTED LANE LINE RT
 STA 60+75.00 - STA 62+30.00 SOLID LANE LINE RT
 STA 62+67.36 SOLID LANE LINE RT, EAST CENTER STREET
 STA 62+88.48 SOLID LANE LINE LT, CENTER STREET

646.612 TEMPORARY 4 INCH YELLOW LINE, PAINT
 (ALL LINES WILL INCLUDE C/L BREAKS FOR TOWN HIGHWAYS)
 U.S. ROUTE 7:
 STA 60+00.00 - STA 60+75.00 DOUBLE SOLID RT
 STA 60+75.00 - STA 62+30.00 DOUBLE SOLID CL
 STA 62+88.48 DOUBLE SOLID LT, CENTER STREET
 STA 63+35.00 - STA 63+50.00 DOUBLE SOLID MEDIAN CL/RT

646.456 DURABLE 8 INCH YELLOW LINE, RECESSED POLYUREA
 U.S. ROUTE 7:
 STA 63+35.00 - STA 63+50.00 HATCHED MEDIAN CL/RT

646.487 DURABLE 24 INCH STOP BAR, RECESSED TYPE I TAPE
 U.S. ROUTE 7:
 STA 62+31.00 RT
 STA 62+67.36 RT, EAST CENTER STREET
 STA 62+88.48 LT, CENTER STREET
 STA 63+40.00 LT

646.682 TEMPORARY 24 INCH STOP BAR, PAINT
 U.S. ROUTE 7:
 STA 62+31.00 RT
 STA 62+67.36 RT, EAST CENTER STREET
 STA 62+88.48 LT, CENTER STREET
 STA 63+40.00 LT

646.491 DURABLE LETTER OR SYMBOL, TYPE I TAPE
 U.S. ROUTE 7:
 STA 60+79.25 RT, ARROW (1 EA)
 STA 61+52.50 RT, "O.N.L.Y." (4 EA)
 STA 62+21.75 RT, ARROW (1 EA)
 STA 62+67.36 RT, EAST CENTER STREET, ARROW (1 EA)
 STA 62+67.36 RT, EAST CENTER STREET, ARROW (2 EA)
 STA 62+88.48 LT, CENTER STREET, ARROW (2 EA)
 STA 62+88.48 LT, CENTER STREET, ARROW (2 EA)

646.692 TEMPORARY LETTER OR SYMBOL, PAINT
 U.S. ROUTE 7:
 STA 60+79.25 RT, ARROW (2 EA)
 STA 62+21.75 RT, ARROW (2 EA)
 STA 62+67.36 RT, EAST CENTER STREET, ARROW (2 EA)
 STA 62+67.36 RT, EAST CENTER STREET, ARROW (4 EA)
 STA 62+88.48 LT, CENTER STREET, ARROW (4 EA)
 STA 62+88.48 LT, CENTER STREET, ARROW (4 EA)

646.501 DURABLE CROSSWALK MARKING, TYPE I TAPE
 U.S. ROUTE 7:
 STA 62+47.00 LT/RT
 STA 62+67.36 RT, EAST CENTER STREET
 STA 62+88.48 LT, CENTER STREET
 STA 63+07.00 LT/RT

646.702 TEMPORARY CROSSWALK MARKING, PAINT
 U.S. ROUTE 7:
 STA 62+47.00 LT/RT
 STA 62+67.36 RT, EAST CENTER STREET
 STA 62+88.48 LT, CENTER STREET
 STA 63+07.00 LT/RT

675.50 REMOVING SIGNS
 AS SHOWN - 18

675.60 ERECTING SALVAGED SIGNS
 AS SHOWN - 2

NOTES:

- COLD PLANING AND PAVING LIMIT ON ALL CITY STREETS SHALL BE MEASURED 25 FT BACK FROM U.S. ROUTE 7 FACE OF CURB UNLESS DENOTED OTHERWISE ON THE PLANS OR AS DIRECTED BY THE ENGINEER.
- SEE SHEET 244 FOR TRAFFIC SIGNAL PLAN SHEET.
- INSTALLED OR ADJUSTED UNDER STP 019-3(57) PRIOR TO CONSTRUCTION.

616.28 CAST-IN-PLACE CONCRETE CURB, TYPE B
 U.S. ROUTE 7:
 STA 62+45.0 RT (14.0 LF)
 STA 62+79.0 RT (14.0 LF)

618.10 PORTLAND CEMENT CONCRETE SIDEWALK, 5 INCH
 U.S. ROUTE 7:
 STA 62+45.0 RT (10.6 SY)
 STA 62+79.0 RT (10.6 SY)




618.30 DETECTABLE WARNING SURFACE
 U.S. ROUTE 7:
 STA 62+45.0 RT (10.0 SF)
 STA 62+79.0 RT (10.0 SF)

604.42 CHANGING ELEVATION OF SEWER MANHOLES
 U.S. ROUTE 7:
 STA 62+61.0 LT
 STA 62+90.0 LT
 STA 62+94.0 LT

629.20 ADJUST ELEVATION OF VALVE BOX
 U.S. ROUTE 7:
 STA 61+22.0 RT
 STA 62+78.0 LT
 STA 62+84.0 RT

SIGN LEGEND
 R = REMOVE
 S = SALVAGE
 N = NEW
 RET = RETAIN
 B-B = BACK TO BACK
 EXISTING =
 NEW =
 ⊕ = RETURN TO THE CITY OF RUTLAND

FILE NAME: I:\177525\CAD\000\188\188.dwg
 DATE/TIME: 7/19/2013 4:49:16
 USER: jldgn

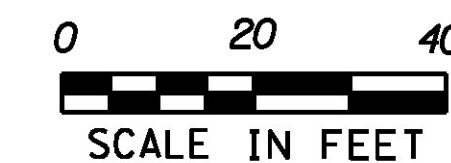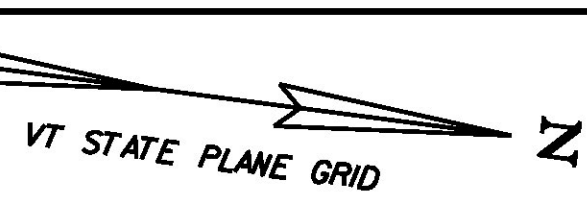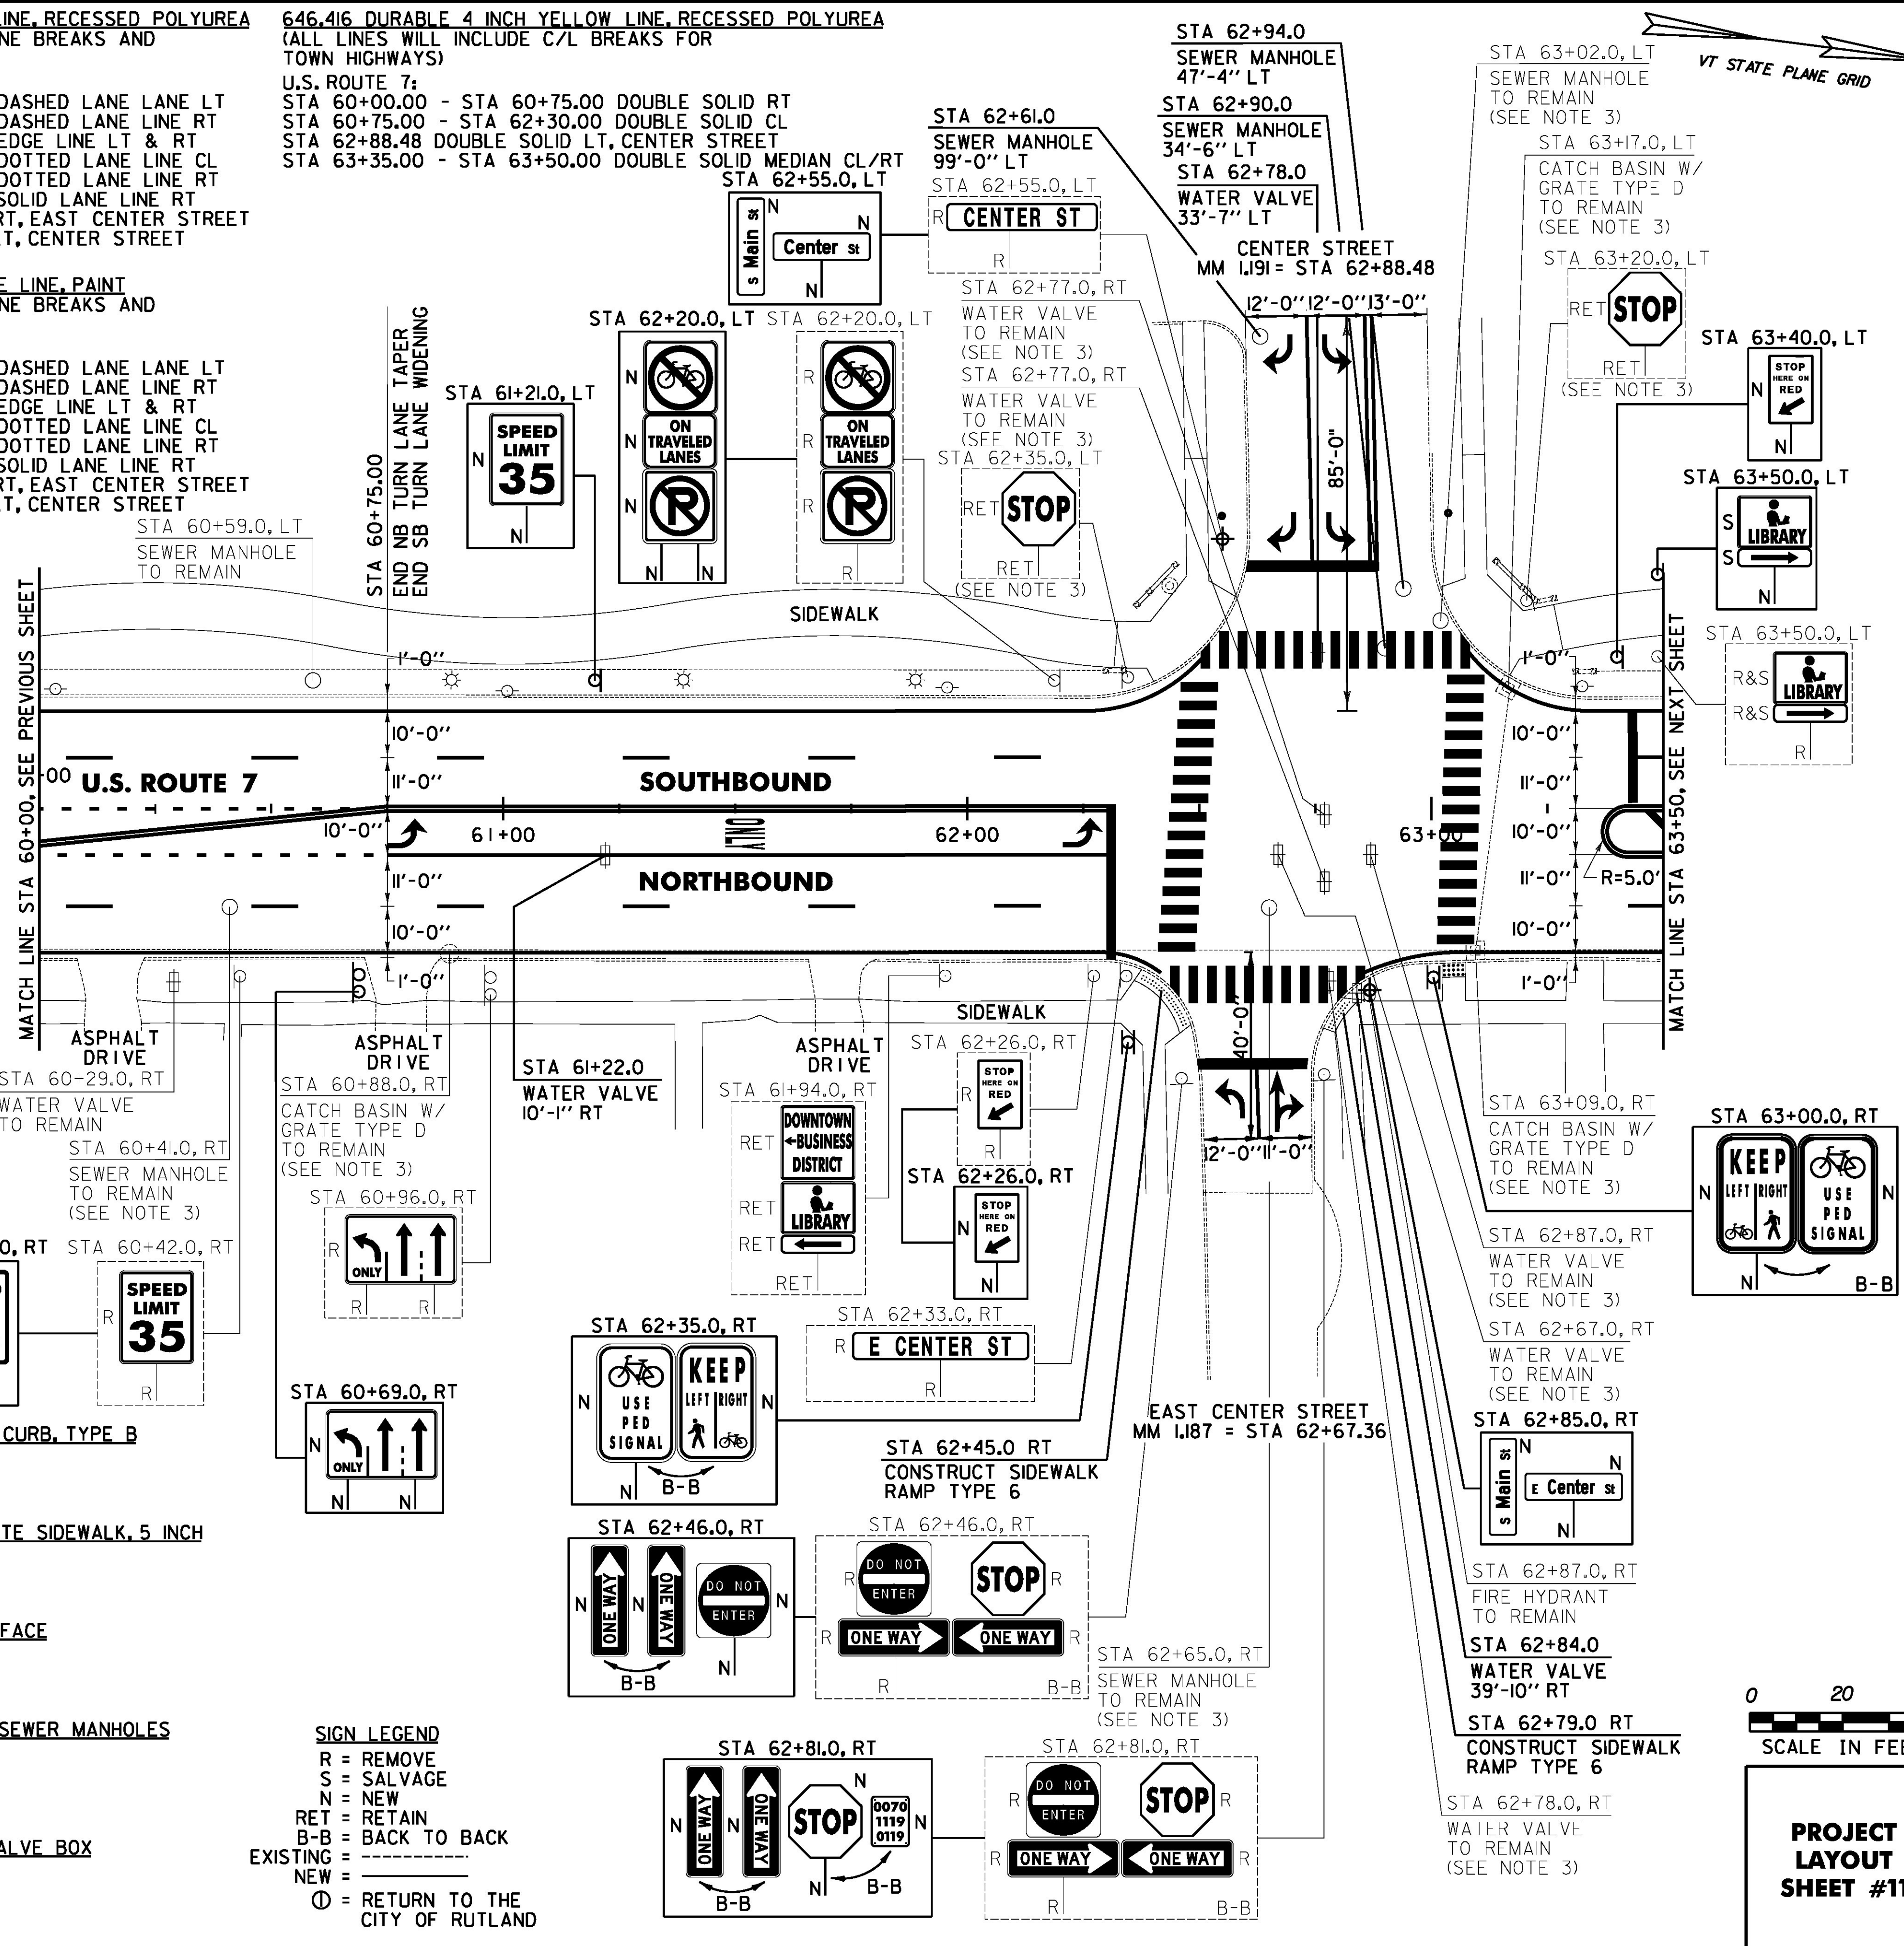

| | |
|---------------------------------|----------------------------|
| PROJECT LAYOUT SHEET #11 | PROJECT NAME: RUTLAND CITY |
| | PROJECT NUMBER: NH 2716(1) |
| | FILE NAME: p07d188.dgn |
| | PLOT DATE: 7/19/2013 |
| | DRAWN BY: W.G.P. |
| | DESIGNED BY: M.J.M. |
| | CHECKED BY: D.E.G. |
| | SHEET 169 OF 392 |