

646.426 DURABLE 6 INCH WHITE LINE, RECESSED POLYUREA  
 (ALL LINES WILL INCLUDE EDGE LINE BREAKS AND RADIUS FOR TOWN HIGHWAYS)  
 U.S. ROUTE 4:  
 STA 20+00.00 - STA 25+00.00 BIKE LANE EDGE LINE LT & RT

646.622 TEMPORARY 6 INCH WHITE LINE, PAINT  
 (ALL LINES WILL INCLUDE EDGE LINE BREAKS AND RADIUS FOR TOWN HIGHWAYS)  
 U.S. ROUTE 4:  
 STA 20+00.00 - STA 25+00.00 BIKE LANE EDGE LINE LT & RT

646.416 DURABLE 4 INCH YELLOW LINE, RECESSED POLYUREA  
 (ALL LINES WILL INCLUDE C/L BREAKS FOR TOWN HIGHWAYS)  
 U.S. ROUTE 4:  
 STA 20+00.00 - STA 25+00.00 SOLID / DASHED TURN LANE LINES LT & RT

646.612 TEMPORARY 4 INCH YELLOW LINE, PAINT  
 (ALL LINES WILL INCLUDE C/L BREAKS FOR TOWN HIGHWAYS)  
 U.S. ROUTE 4:  
 STA 20+00.00 - STA 25+00.00 SOLID / DASHED TURN LANE LINES LT & RT



646.491 DURABLE LETTER OR SYMBOL, TYPE I TAPE  
 U.S. ROUTE 4:  
 STA 20+82.50 C/L, ARROW (1 EA)  
 STA 20+96.00 C/L, ARROW (1 EA)  
 STA 23+00.00 LT, BIKE LANE ARROW (1 EA)  
 STA 23+04.50 C/L, ARROW (1 EA)  
 STA 23+18.00 C/L, ARROW (1 EA)  
 STA 23+86.56 LT, TREMONT STREET, YIELD LINE (4 EA)

646.692 TEMPORARY LETTER OR SYMBOL, PAINT  
 U.S. ROUTE 4:  
 STA 20+82.50 C/L, ARROW (2 EA)  
 STA 20+96.00 C/L, ARROW (2 EA)  
 STA 23+00.00 LT, BIKE LANE ARROW (2 EA)  
 STA 23+04.50 C/L, ARROW (2 EA)  
 STA 23+18.00 C/L, ARROW (2 EA)  
 STA 23+86.56 LT, TREMONT STREET, YIELD LINE (4 EA)

646.501 DURABLE CROSSWALK MARKING, TYPE I TAPE  
 U.S. ROUTE 4:  
 STA 23+86.56 LT, TREMONT STREET

646.702 TEMPORARY CROSSWALK MARKING, PAINT  
 U.S. ROUTE 4:  
 STA 23+86.56 LT, TREMONT STREET

675.50 REMOVING SIGNS AS SHOWN - 4

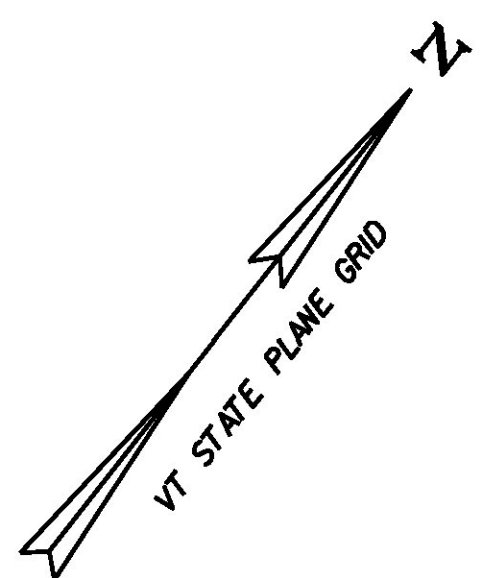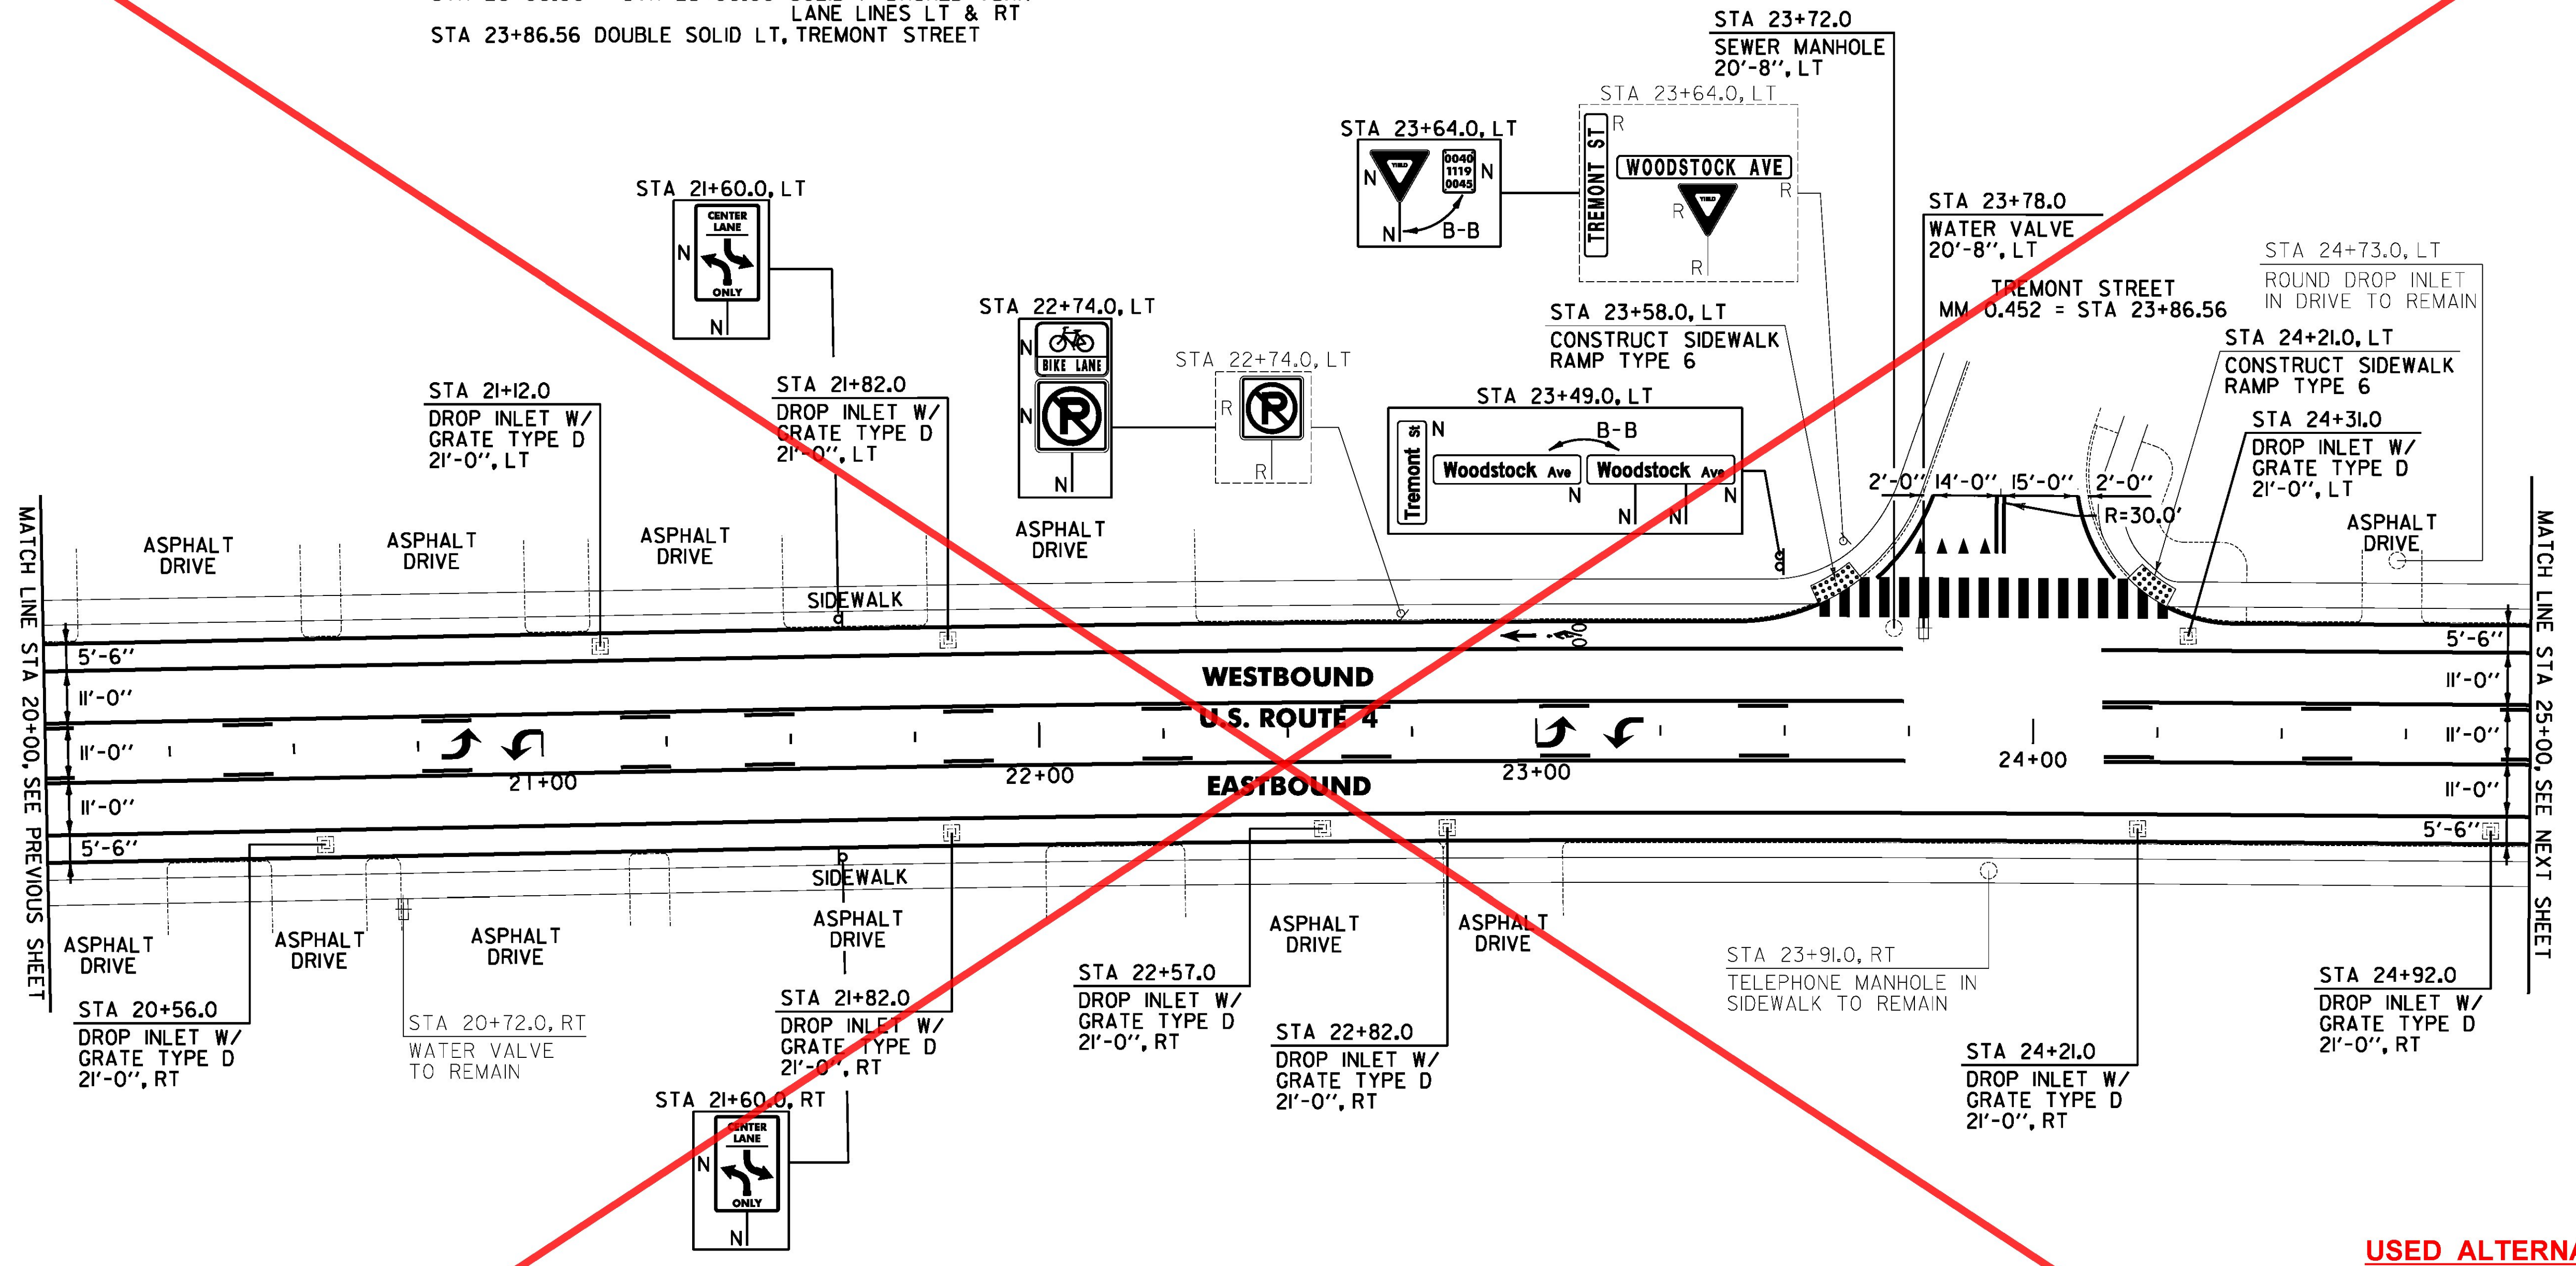

**USED ALTERNATE A**

604.412, 604.415, 604.418 REHAB. DROP INLETS, CATCH BASINS, OR MANHOLES, CLASS I, II, OR III (SEE NOTE 2)  
 U.S. ROUTE 4:  
 STA 20+56.0 RT  
 STA 21+12.0 LT  
 STA 21+82.0 LT  
 STA 21+82.0 RT  
 STA 22+57.0 RT  
 STA 22+82.0 RT  
 STA 24+21.0 RT  
 STA 24+31.0 LT  
 STA 24+92.0 RT

604.42 CHANGING ELEVATION OF SEWER MANHOLES  
 U.S. ROUTE 4:  
 STA 23+72.0 LT

616.28 CAST-IN-PLACE CONCRETE CURB, TYPE B  
 U.S. ROUTE 4:  
 STA 23+58.0 LT (14.0 LF)  
 STA 24+21.0 LT (14.0 LF)

618.10 PORTLAND CEMENT CONCRETE SIDEWALK, 5 INCH  
 U.S. ROUTE 4:  
 STA 23+58.0 LT (10.6 SY)  
 STA 24+21.0 LT (10.6 SY)

618.30 DETECTABLE WARNING SURFACE  
 U.S. ROUTE 4:  
 STA 23+58.0 LT (10.0 SF)  
 STA 24+21.0 LT (10.0 SF)

629.20 ADJUST ELEVATION OF VALVE BOX  
 U.S. ROUTE 4:  
 STA 23+78.0 LT

NOTES:

1. GROUND PLANING AND PAVING LIMIT ON ALL CITY STREETS SHALL BE MEASURED 25 FT BACK FROM U.S. ROUTE 4 FACE OF CURB UNLESS DENOTED OTHERWISE ON THE PLANS OR AS DIRECTED BY THE ENGINEER.
2. THE CONTRACTOR SHALL REHABILITATED THE EXISTING DROP INLETS, CATCH BASINS OR MANHOLES TO A DEPTH AS DIRECTED BY THE ENGINEER. ALL REHABILITATION WORK WILL BE PAID FOR UNDER THE APPLICABLE REHABILITATION ITEM AS DIRECTED BY THE ENGINEER. ALL EXISTING UTILITIES MARKED "TO REMAIN" SHALL NOT BE ALTERED OR REHABILITATED UNLESS DIRECTED OTHERWISE BY THE ENGINEER.

**SIGN LEGEND**

R = REMOVE  
 S = SALVAGE  
 N = NEW  
 RET = RETAIN  
 B-B = BACK TO BACK  
 EXISTING = -----  
 NEW = \_\_\_\_\_

① = RETURN TO THE CITY OF RUTLAND

**PROJECT LAYOUT SHEET #18 ALTERNATE B**

PROJECT NAME: RUTLAND CITY	FILE NAME: p07d188.dgn	PLOT DATE: 7/19/2013
PROJECT NUMBER: NH 2716(1)	PROJECT LEADER: D.E.G.	DRAWN BY: M.E.D.
	DESIGNED BY: M.J.M.	CHECKED BY: D.E.G.
IPARM FILE: 07d18818B.1		SHEET 188 OF 392

FILE NAME = I:\177625\CAD\DWG\2716\18\4 Blue Lema\07d188\_bor\_rvt\_18B.dgn  
 DATE/TIME = 7/19/2013 4:49:16  
 USER = 4916