

646.406 DURABLE 4 INCH WHITE LINE, RECESSED POLYUREA
 (ALL LINES WILL INCLUDE EDGE LINE BREAKS AND RADIUS FOR TOWN HIGHWAYS)
 U.S. ROUTE 4:
 STA 55+00.00 - STA 61+00.00 EDGE LINE LT & RT
 STA 55+00.00 - STA 61+00.00 DASHED LANE LINE LT
 STA 55+00.00 - STA 61+00.00 DASHED LANE LINE RT

646.602 TEMPORARY 4 INCH WHITE LINE, PAINT
 (ALL LINES WILL INCLUDE EDGE LINE BREAKS AND RADIUS FOR TOWN HIGHWAYS)
 U.S. ROUTE 4:
 STA 55+00.00 - STA 61+00.00 EDGE LINE LT & RT
 STA 55+00.00 - STA 61+00.00 DASHED LANE LINE LT
 STA 55+00.00 - STA 61+00.00 DASHED LANE LINE RT

646.416 DURABLE 4 INCH YELLOW LINE, RECESSED POLYUREA
 (ALL LINES WILL INCLUDE C/L BREAKS FOR TOWN HIGHWAYS)
 U.S. ROUTE 4:
 STA 55+00.00 - STA 57+30.00 SOLID/DASHED TURN LANE LINES LT/RT
 STA 57+30.00 - STA 59+00.00 DOUBLE SOLID MEDIAN LT/RT
 STA 59+00.00 - STA 61+00.00 DOUBLE SOLID CL



646.612 TEMPORARY 4 INCH YELLOW LINE, PAINT
 (ALL LINES WILL INCLUDE C/L BREAKS FOR TOWN HIGHWAYS)
 U.S. ROUTE 4:
 STA 55+00.00 - STA 57+30.00 SOLID/DASHED TURN LANE LINES LT/RT
 STA 57+30.00 - STA 59+00.00 DOUBLE SOLID MEDIAN LT/RT
 STA 59+00.00 - STA 61+00.00 DOUBLE SOLID CL

646.491 DURABLE LETTER OR SYMBOL, TYPE ITAPE
 U.S. ROUTE 4:
 STA 56+46.00 CL, ARROW (1EA)
 STA 56+59.50 CL, ARROW (1EA)

675.50 REMOVING SIGNS
 AS SHOWN - 5

646.692 TEMPORARY LETTER OR SYMBOL, PAINT
 U.S. ROUTE 4:
 STA 56+46.00 CL, ARROW (2 EA)
 STA 56+59.50 CL, ARROW (2 EA)

646.456 DURABLE 8 INCH YELLOW LINE, RECESSED POLYUREA
 U.S. ROUTE 4:
 STA 57+30.00 - STA 59+00.00 HATCHED MEDIAN LT/RT

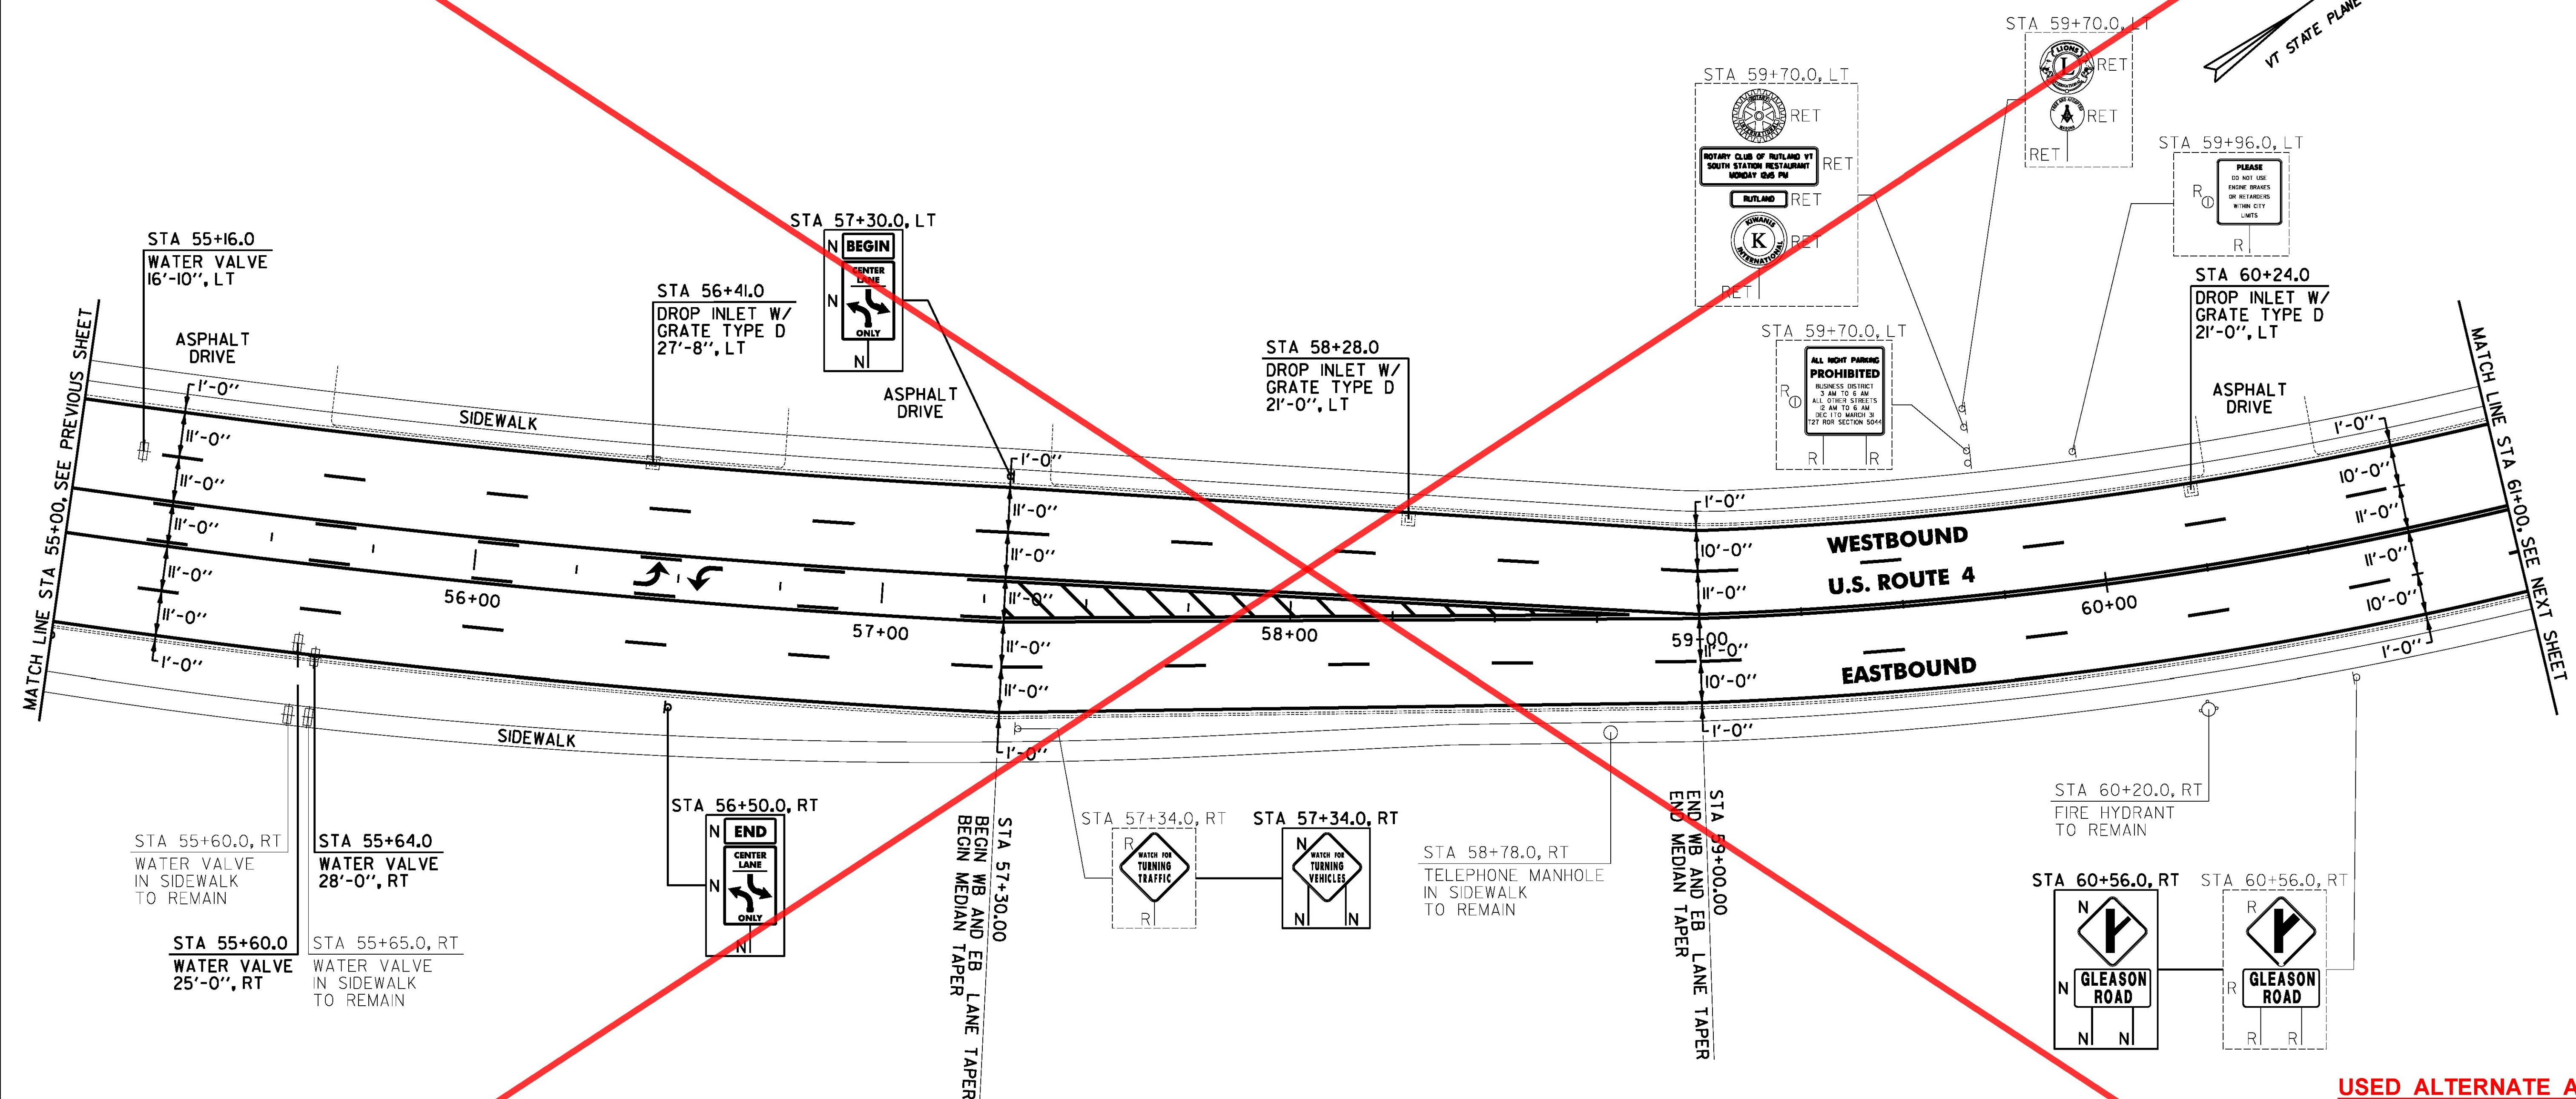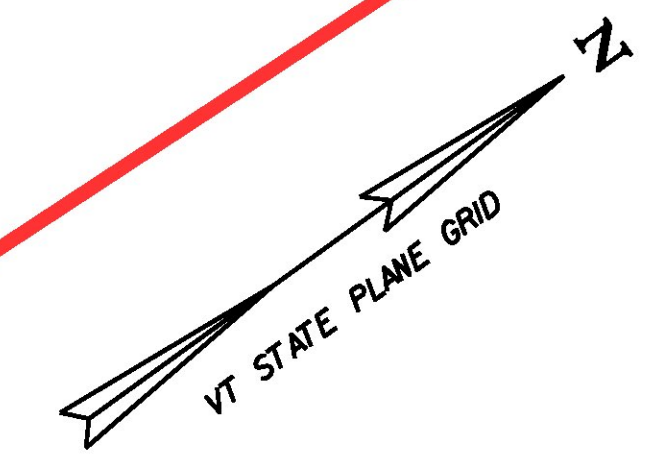

MATCH LINE STA 55+00, SEE PREVIOUS SHEET

MATCH LINE STA 61+00, SEE NEXT SHEET

USED ALTERNATE A

NOTE:
 I. THE CONTRACTOR SHALL REHABILITATE THE EXISTING DROP INLETS, CATCH BASINS OR MANHOLES TO A DEPTH AS DIRECTED BY THE ENGINEER. ALL REHABILITATION WORK WILL BE PAID FOR UNDER THE APPLICABLE REHABILITATION ITEM AS DIRECTED BY THE ENGINEER. ALL EXISTING UTILITIES MARKED "TO REMAIN" SHALL NOT BE ALTERED OR REHABILITATED UNLESS DIRECTED OTHERWISE BY THE ENGINEER.

SIGN LEGEND
 R = REMOVE
 S = SALVAGE
 N = NEW
 RET = RETAIN
 B-B = BACK TO BACK
 EXISTING = -----
 NEW = _____
 Ⓞ = RETURN TO THE CITY OF RUTLAND

PROJECT LAYOUT SHEET #24 ALTERNATE B

PROJECT NAME: RUTLAND CITY	PLOT DATE: 7/19/2013
PROJECT NUMBER: NH 2716(1)	DRAWN BY: M.E.D.
FILE NAME: p07d188.dgn	DESIGNED BY: M.J.M.
PROJECT LEADER: D.E.G.	CHECKED BY: D.E.G.
IPARM FILE: 07d188124B.1	SHEET 194 OF 392

FILE NAME: I:\17752ACAD\00\WTR\NH 2716\US 4 Btwe Lemna\07d188.dgn - r.m. 24B.dgn
 DATE/TIME: 7/19/2013 4:49:16
 USER: M.J.M.