


NOTE:
 1. GRADES SHOWN TO THE NEAREST TENTH ARE EXISTING GROUND ELEVATIONS. GRADES SHOWN TO THE NEAREST HUNDREDTH ARE PROPOSED TOP OF RAIL ELEVATIONS.

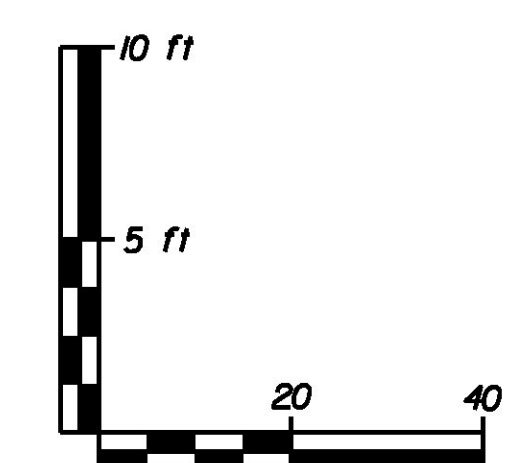

FILE NAME: I:\17752ACADD\17752ACADD.dgn
 DATE/TIME: 7/19/2013 4:16
 USER: 4916

TRACK PROFILE	PROJECT NAME: RUTLAND CITY	PLOT DATE: 7/19/2013
	PROJECT NUMBER: NH 2716(1)	DRAWN BY: W.G.P.
	FILE NAME: p07d188.dgn	CHECKED BY: D.E.G.
	DESIGNED BY: M.J.M.	SHEET 254 OF 392