


NOTE:
 1. GRADES SHOWN TO THE NEAREST TENTH ARE EXISTING GROUND ELEVATIONS. GRADES SHOWN TO THE NEAREST HUNDREDTH ARE PROPOSED TOP OF RAIL ELEVATIONS.

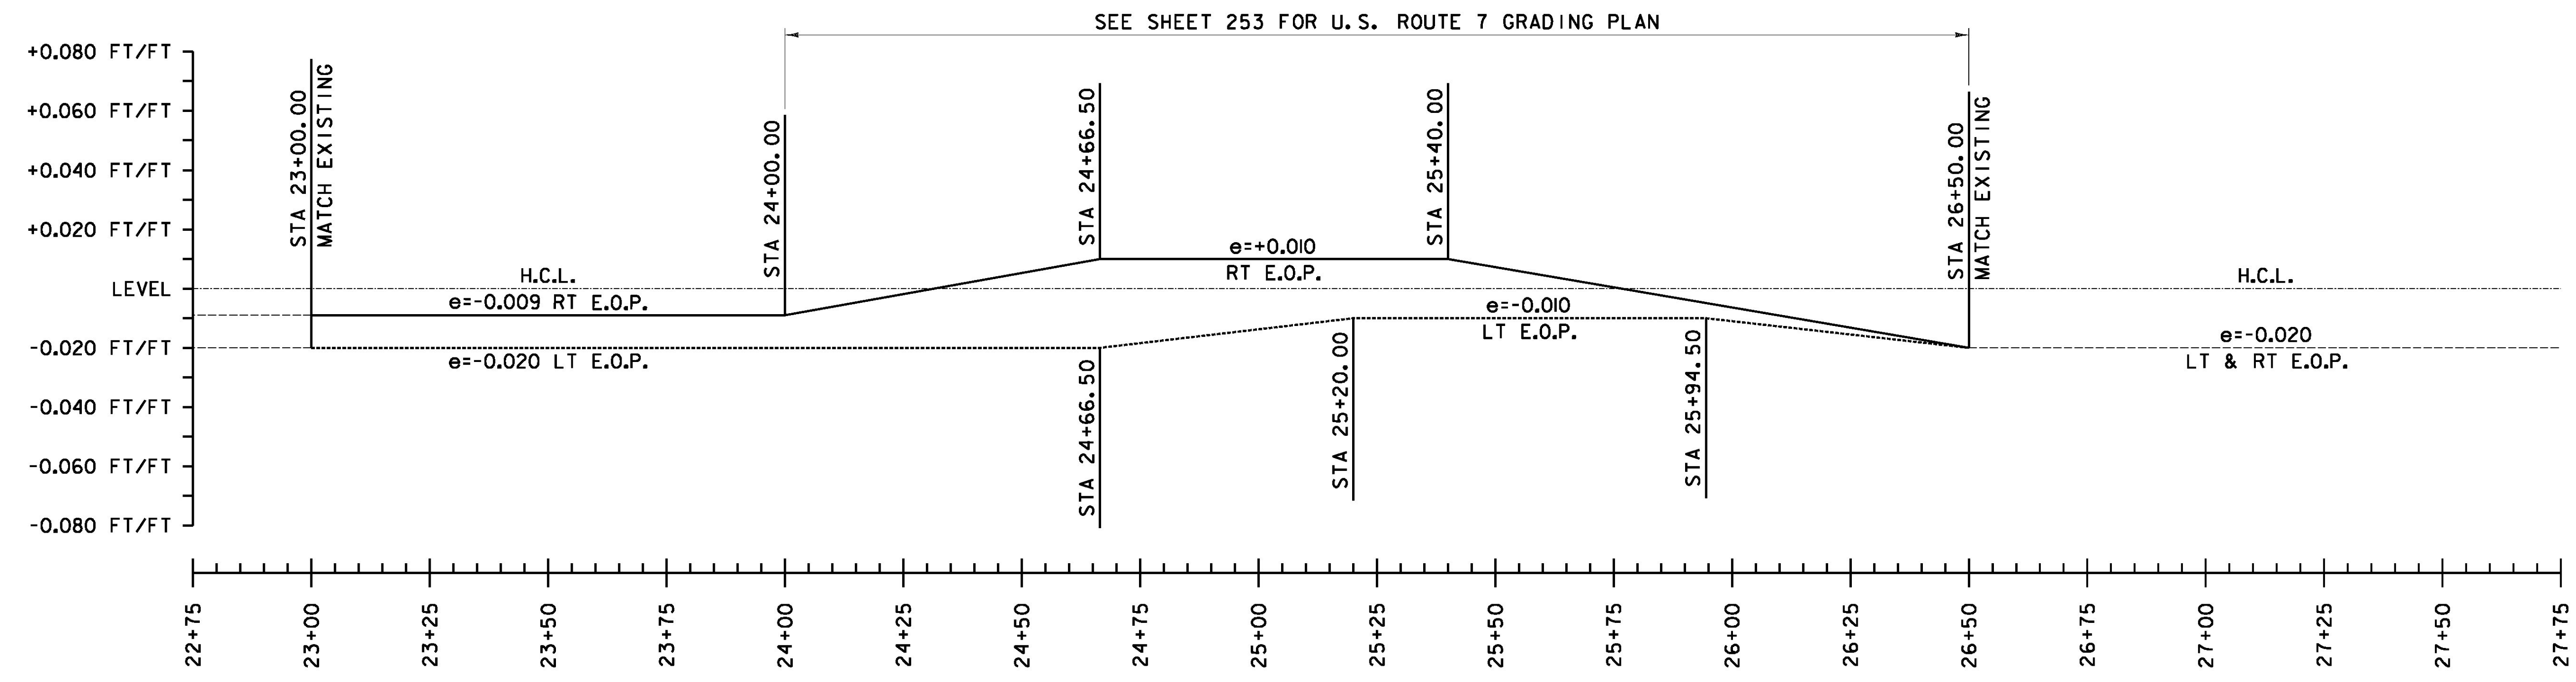

U.S. ROUTE 7

FILE NAME: I:\17752\ACADD\WST\NH 2716\07d188.r-07.dgn
 DATE/TIME: 7/19/2013 4:16
 USER: D.E.G.

U.S. ROUTE 7 GRADE CROSSING PROFILE	PROJECT NAME: RUTLAND CITY
	PROJECT NUMBER: NH 2716(1)
	FILE NAME: p07d188.dgn
	IPARM FILE: 07d188r07.1
	PLOT DATE: 7/19/2013
	DRAWN BY: W.G.P.
	CHECKED BY: D.E.G.
	SHEET 255 OF 392