


**SPECIAL PROVISION
(ADJUST ELEVATION
OF VALVE BOX)**
706+96, LT
711+12, LT

**SPECIAL PROVISION
(ADJUST ELEVATION
OF WATER SHUT OFF)**
709+17, LT
709+75, LT
711+76, LT

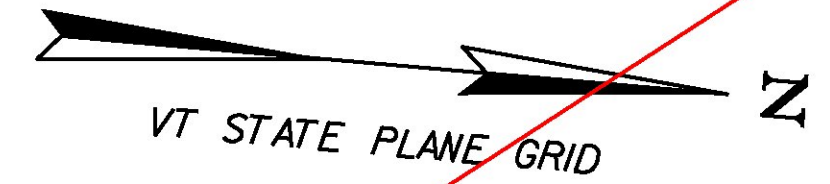

NEW SDR 35 PVC SANITARY
SEWER SERVICE (TYP.). SEE
DRAWINGS SN-01, SN-02 AND
SWD-01 FOR ADDITIONAL
DETAILS

NEW SANITARY SEWER MANHOLE
(TYP.). SEE DRAWINGS SN-01,
SN-02 AND SWD-01 FOR
ADDITIONAL DETAILS.

PIPE REMOVED
FROM PROJECT

RETAIN EXISTING
DRAINAGE STRUCTURE

**U.S. ROUTE 7
SOUTH MAIN STREET**

NEW
PROPOSED PIPE

EXPLORATORY
EXCAVATION
LOCATION (TYP.)

ASSUMED
4' COVER

ASSUMED
4.5' COVER

SEE REVISED SHEET 297A, 297B & 297C

NEW SDR 35 PVC SANITARY SEWER
PIPE (TYP.). SEE DRAWINGS
SN-01, SN-02 AND SWD-01 FOR
ADDITIONAL DETAILS

NOTE:

I. FOR GENERAL NOTES AND LEGEND, SEE SHEET SS-01

PROJECT NAME: RUTLAND CITY
PROJECT NUMBER: STP 019-3(57)

FILE NAME: ...\\PlotFiles\rut_drnp\plan.dgn PLOT DATE: 7/12/2013
PROJECT LEADER: GAE DRAWN BY: PZA
DESIGNED BY: TFD CHECKED BY: GAE
STORM AND UTILITY PLAN SS-02 SHEET 297 OF 392

