



MAIN LINE

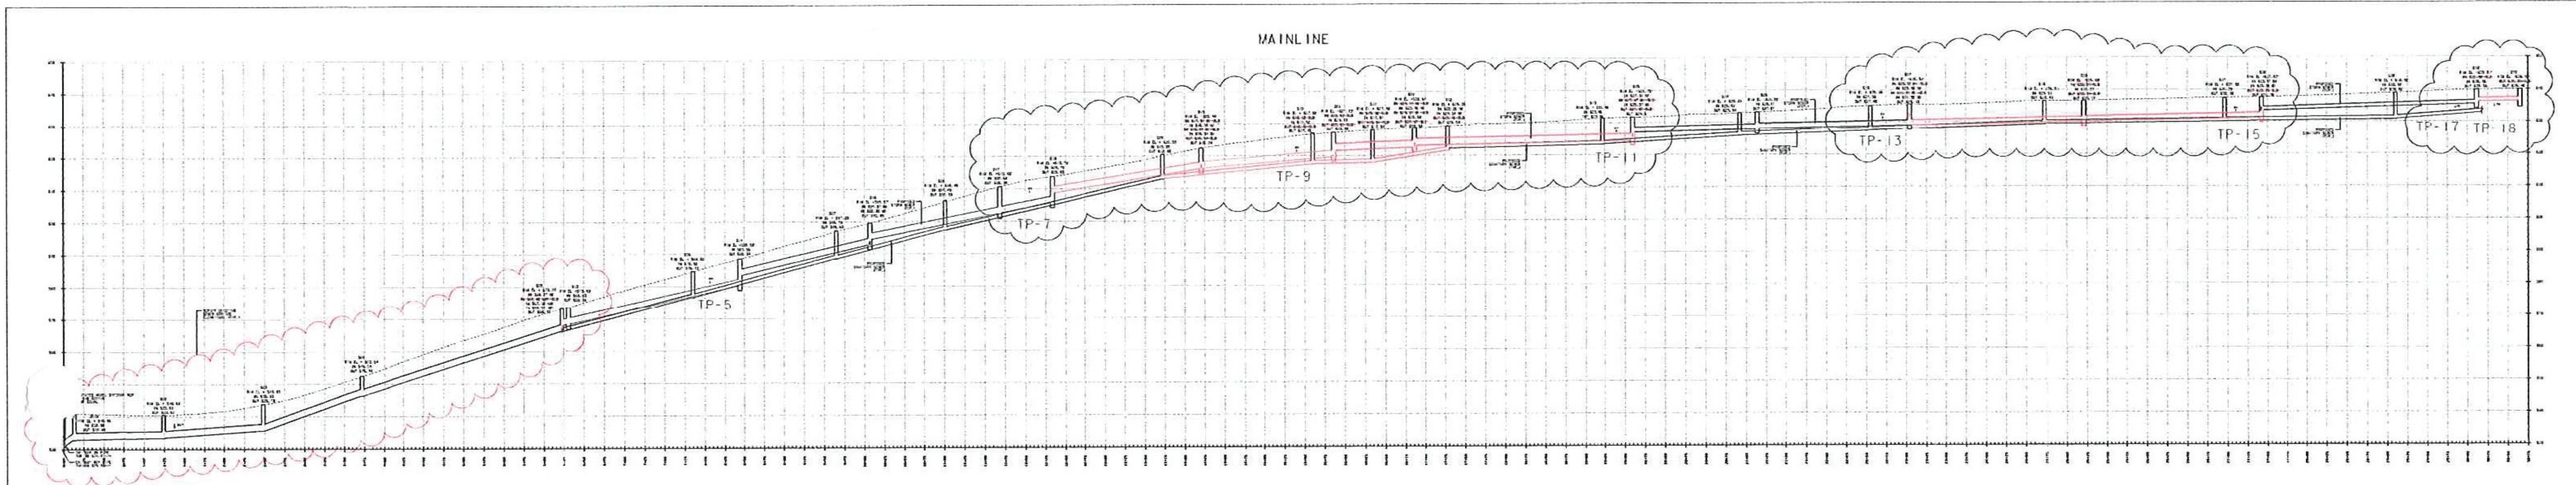

D07 - D11

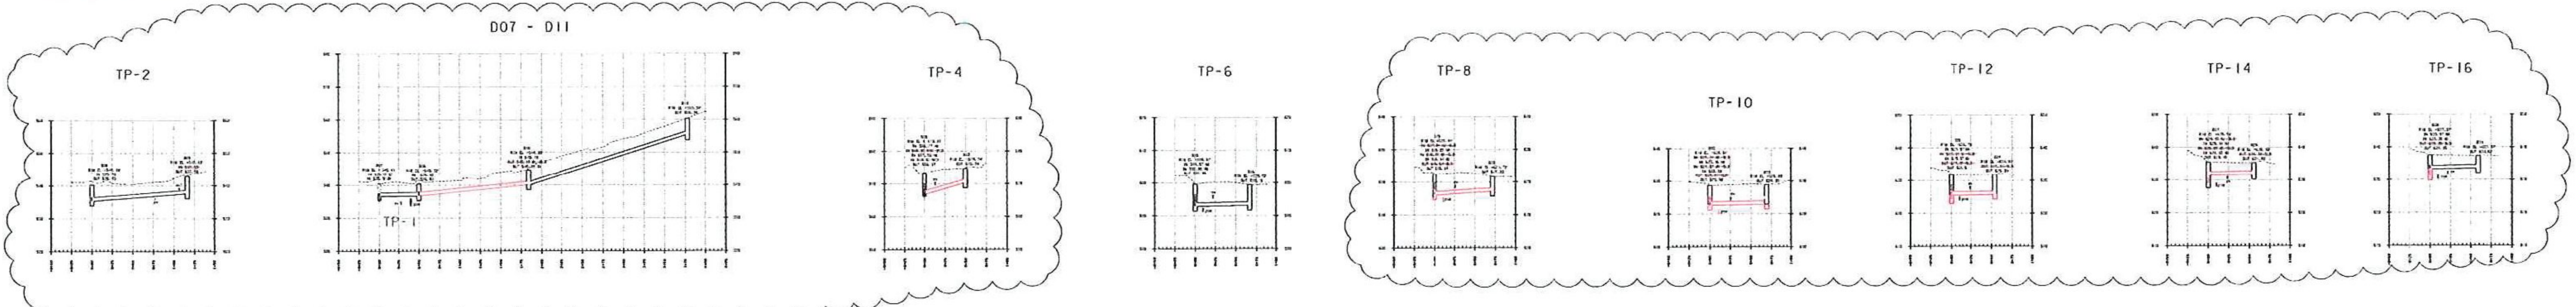

- NOTES:
1. NO CHANGES HAVE BEEN MADE TO STRUCTURE LOCATIONS.
 2. OLD INVERT HAS BEEN LINED OUT.
 3. REVISED PIPING IS DEPICTED IN RED.
 4. ew = EXISTING WATER
pst = PROPOSED STORM SEWER
pse = PROPOSED SANITARY SEWER

APRIL 25, 2014
STORM & SANITARY SEWER
PROFILE REVISION
STANTEC

Revised 4/25/14