


NOTE:  
1. FOR GENERAL NOTES AND LEGEND, SEE SHEET EC-01

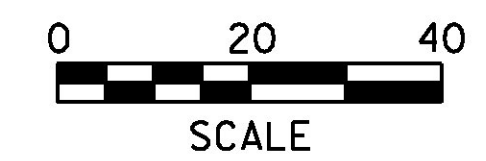

PROJECT NAME:	RUTLAND CITY
PROJECT NUMBER:	STP 019-3(57)
FILE NAME: ...\\rut_epsc_construction.dgn	PLOT DATE: 7/12/2013
PROJECT LEADER: GAE	DRAWN BY: PZA
DESIGNED BY: TFD	CHECKED BY: GAE
<b>EPSC CONSTRUCTION SITE PLAN EC-02 SHEET 324 OF 392</b>	