


MATCH LINE STA. 723+00, SEE SHEET EC-04

MATCH LINE STA. 728+50, SEE SHEET EC-06

NOTE:

1. FOR GENERAL NOTES AND LEGEND, SEE SHEET EC-01

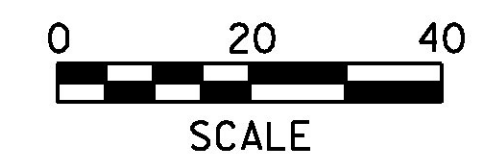

PROJECT NAME:	RUTLAND CITY
PROJECT NUMBER:	STP 019-3(57)
FILE NAME: ...\\rut_epsc_construction.dgn	PLOT DATE: 7/12/2013
PROJECT LEADER: GAE	DRAWN BY: PZA
DESIGNED BY: TFD	CHECKED BY: GAE
EPSC CONSTRUCTION SITE PLAN EC-05 SHEET 327 OF 392	