


**COURT SQUARE @ STA. CT 1+31.91
LIMIT OF WORK**

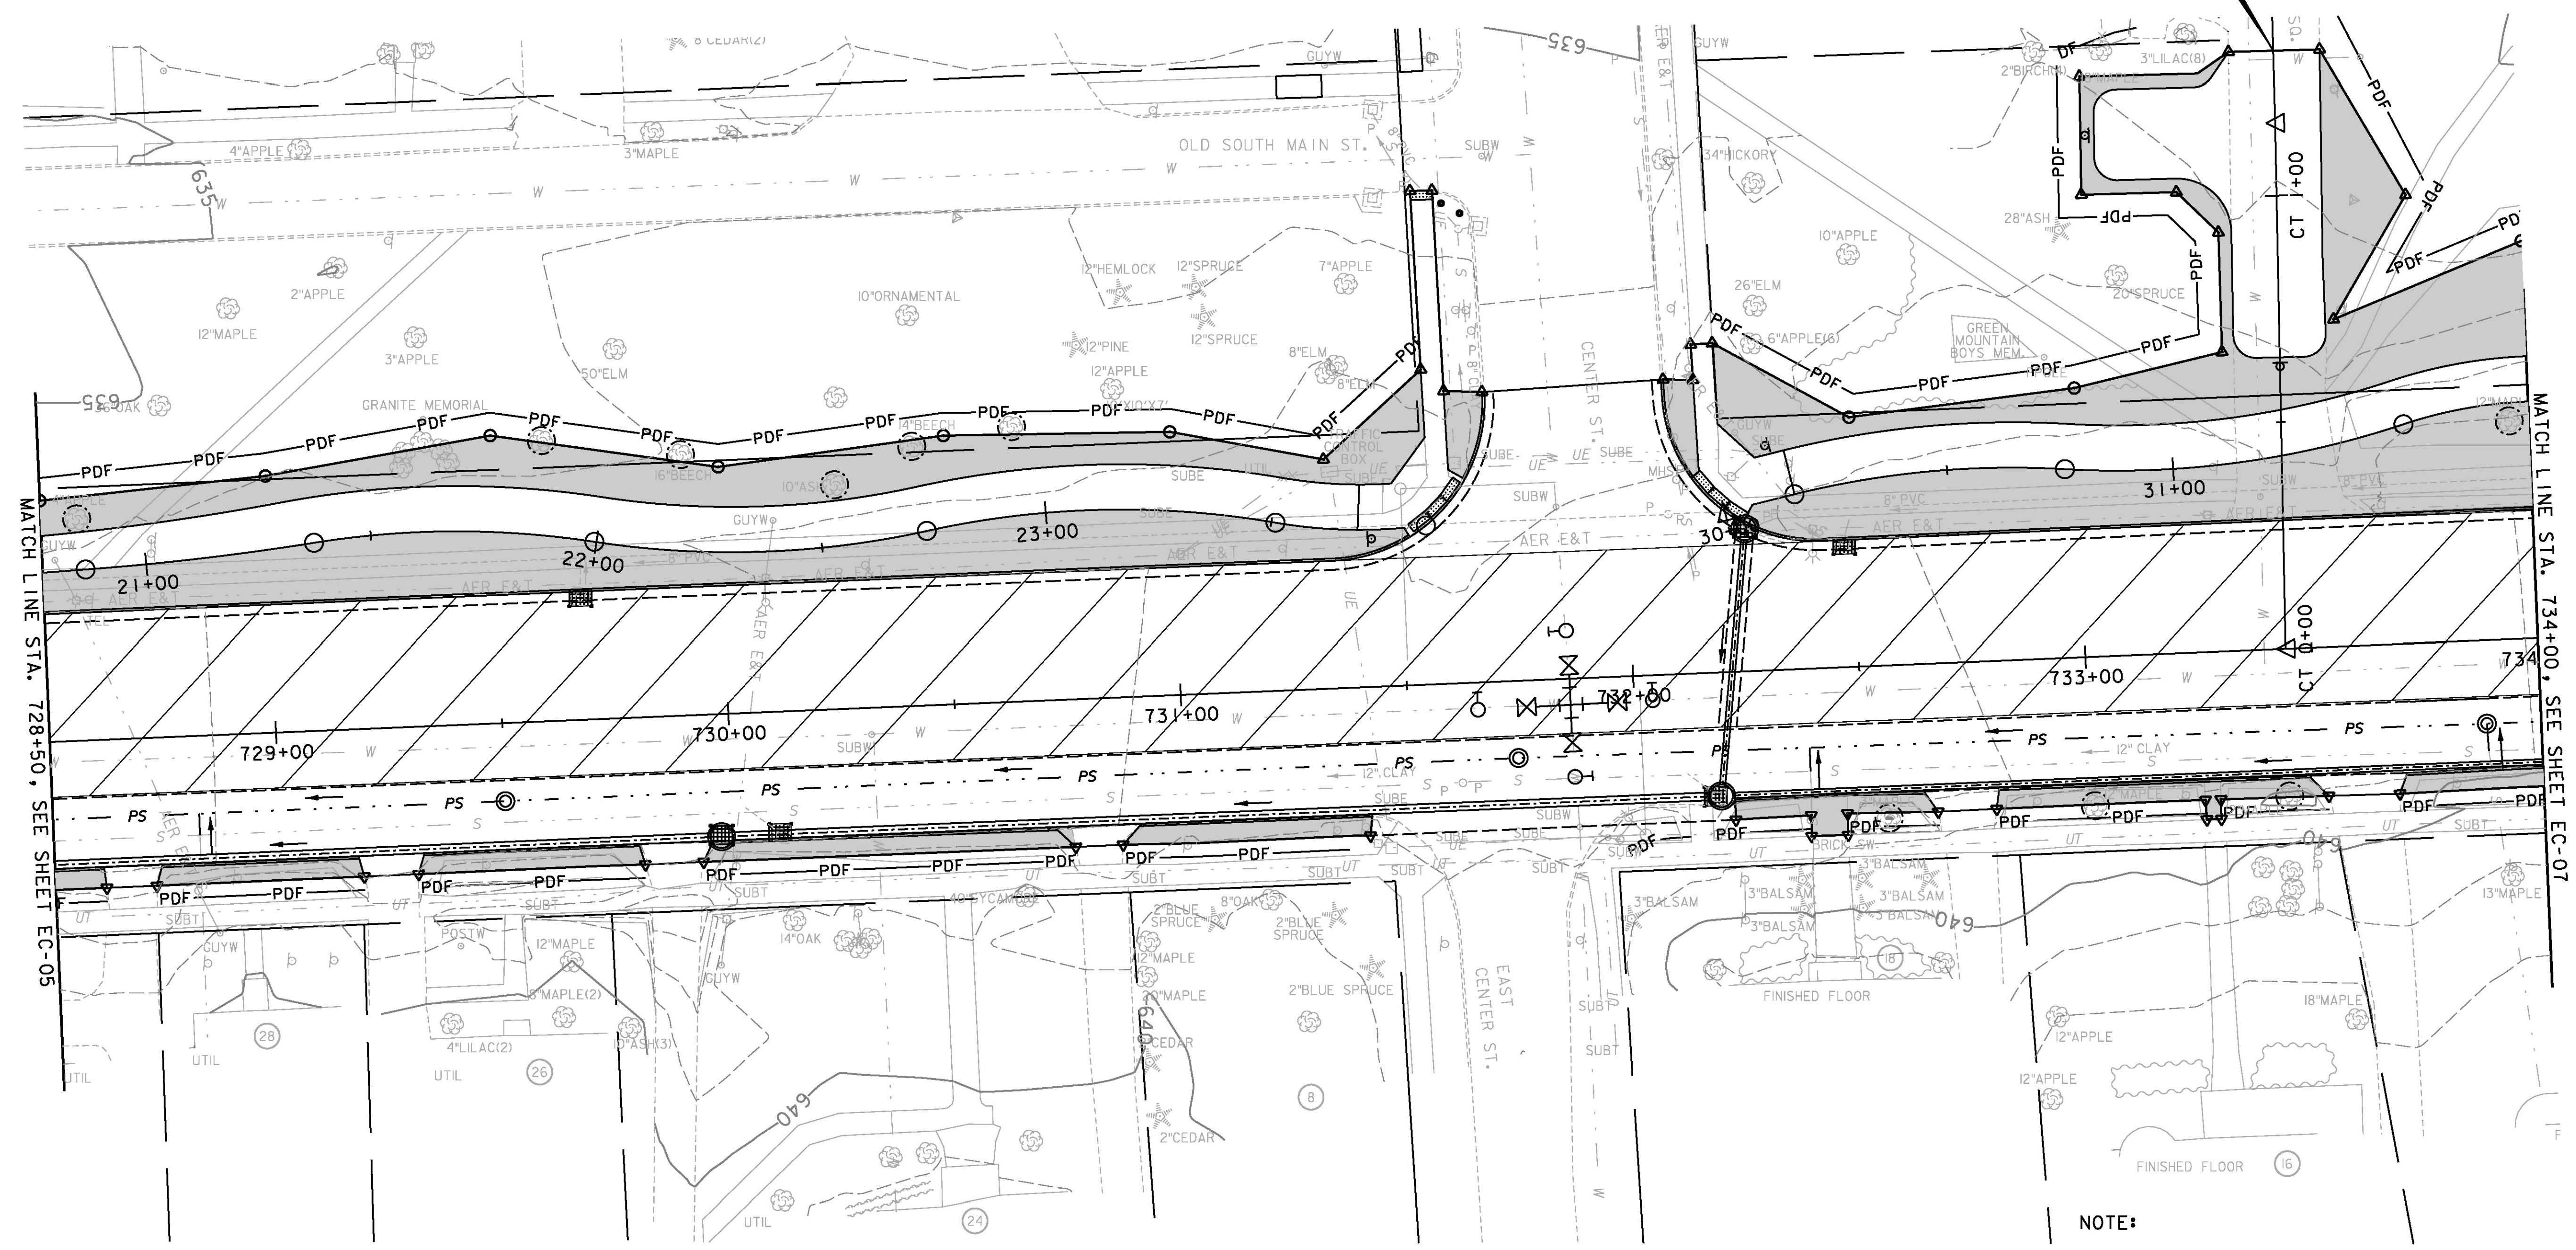

MATCH LINE STA. 728+50, SEE SHEET EC-05

MATCH LINE STA. 734+00, SEE SHEET EC-07

NOTE:

1. FOR GENERAL NOTES AND LEGEND, SEE SHEET EC-01

| | |
|---|--------------------------------|
| PROJECT NAME: | RUTLAND CITY |
| PROJECT NUMBER: | STP 019-3(57) |
| FILE NAME: | ...\\rut_epsc_construction.dgn |
| PLOT DATE: | 7/12/2013 |
| PROJECT LEADER: | GAE |
| DRAWN BY: | PZA |
| DESIGNED BY: | TFD |
| CHECKED BY: | GAE |
| EPSC CONSTRUCTION SITE PLAN EC-06 SHEET 328 OF 392 | |

