



MATCH LINE STA. 53+50, SEE SHEET EC-08

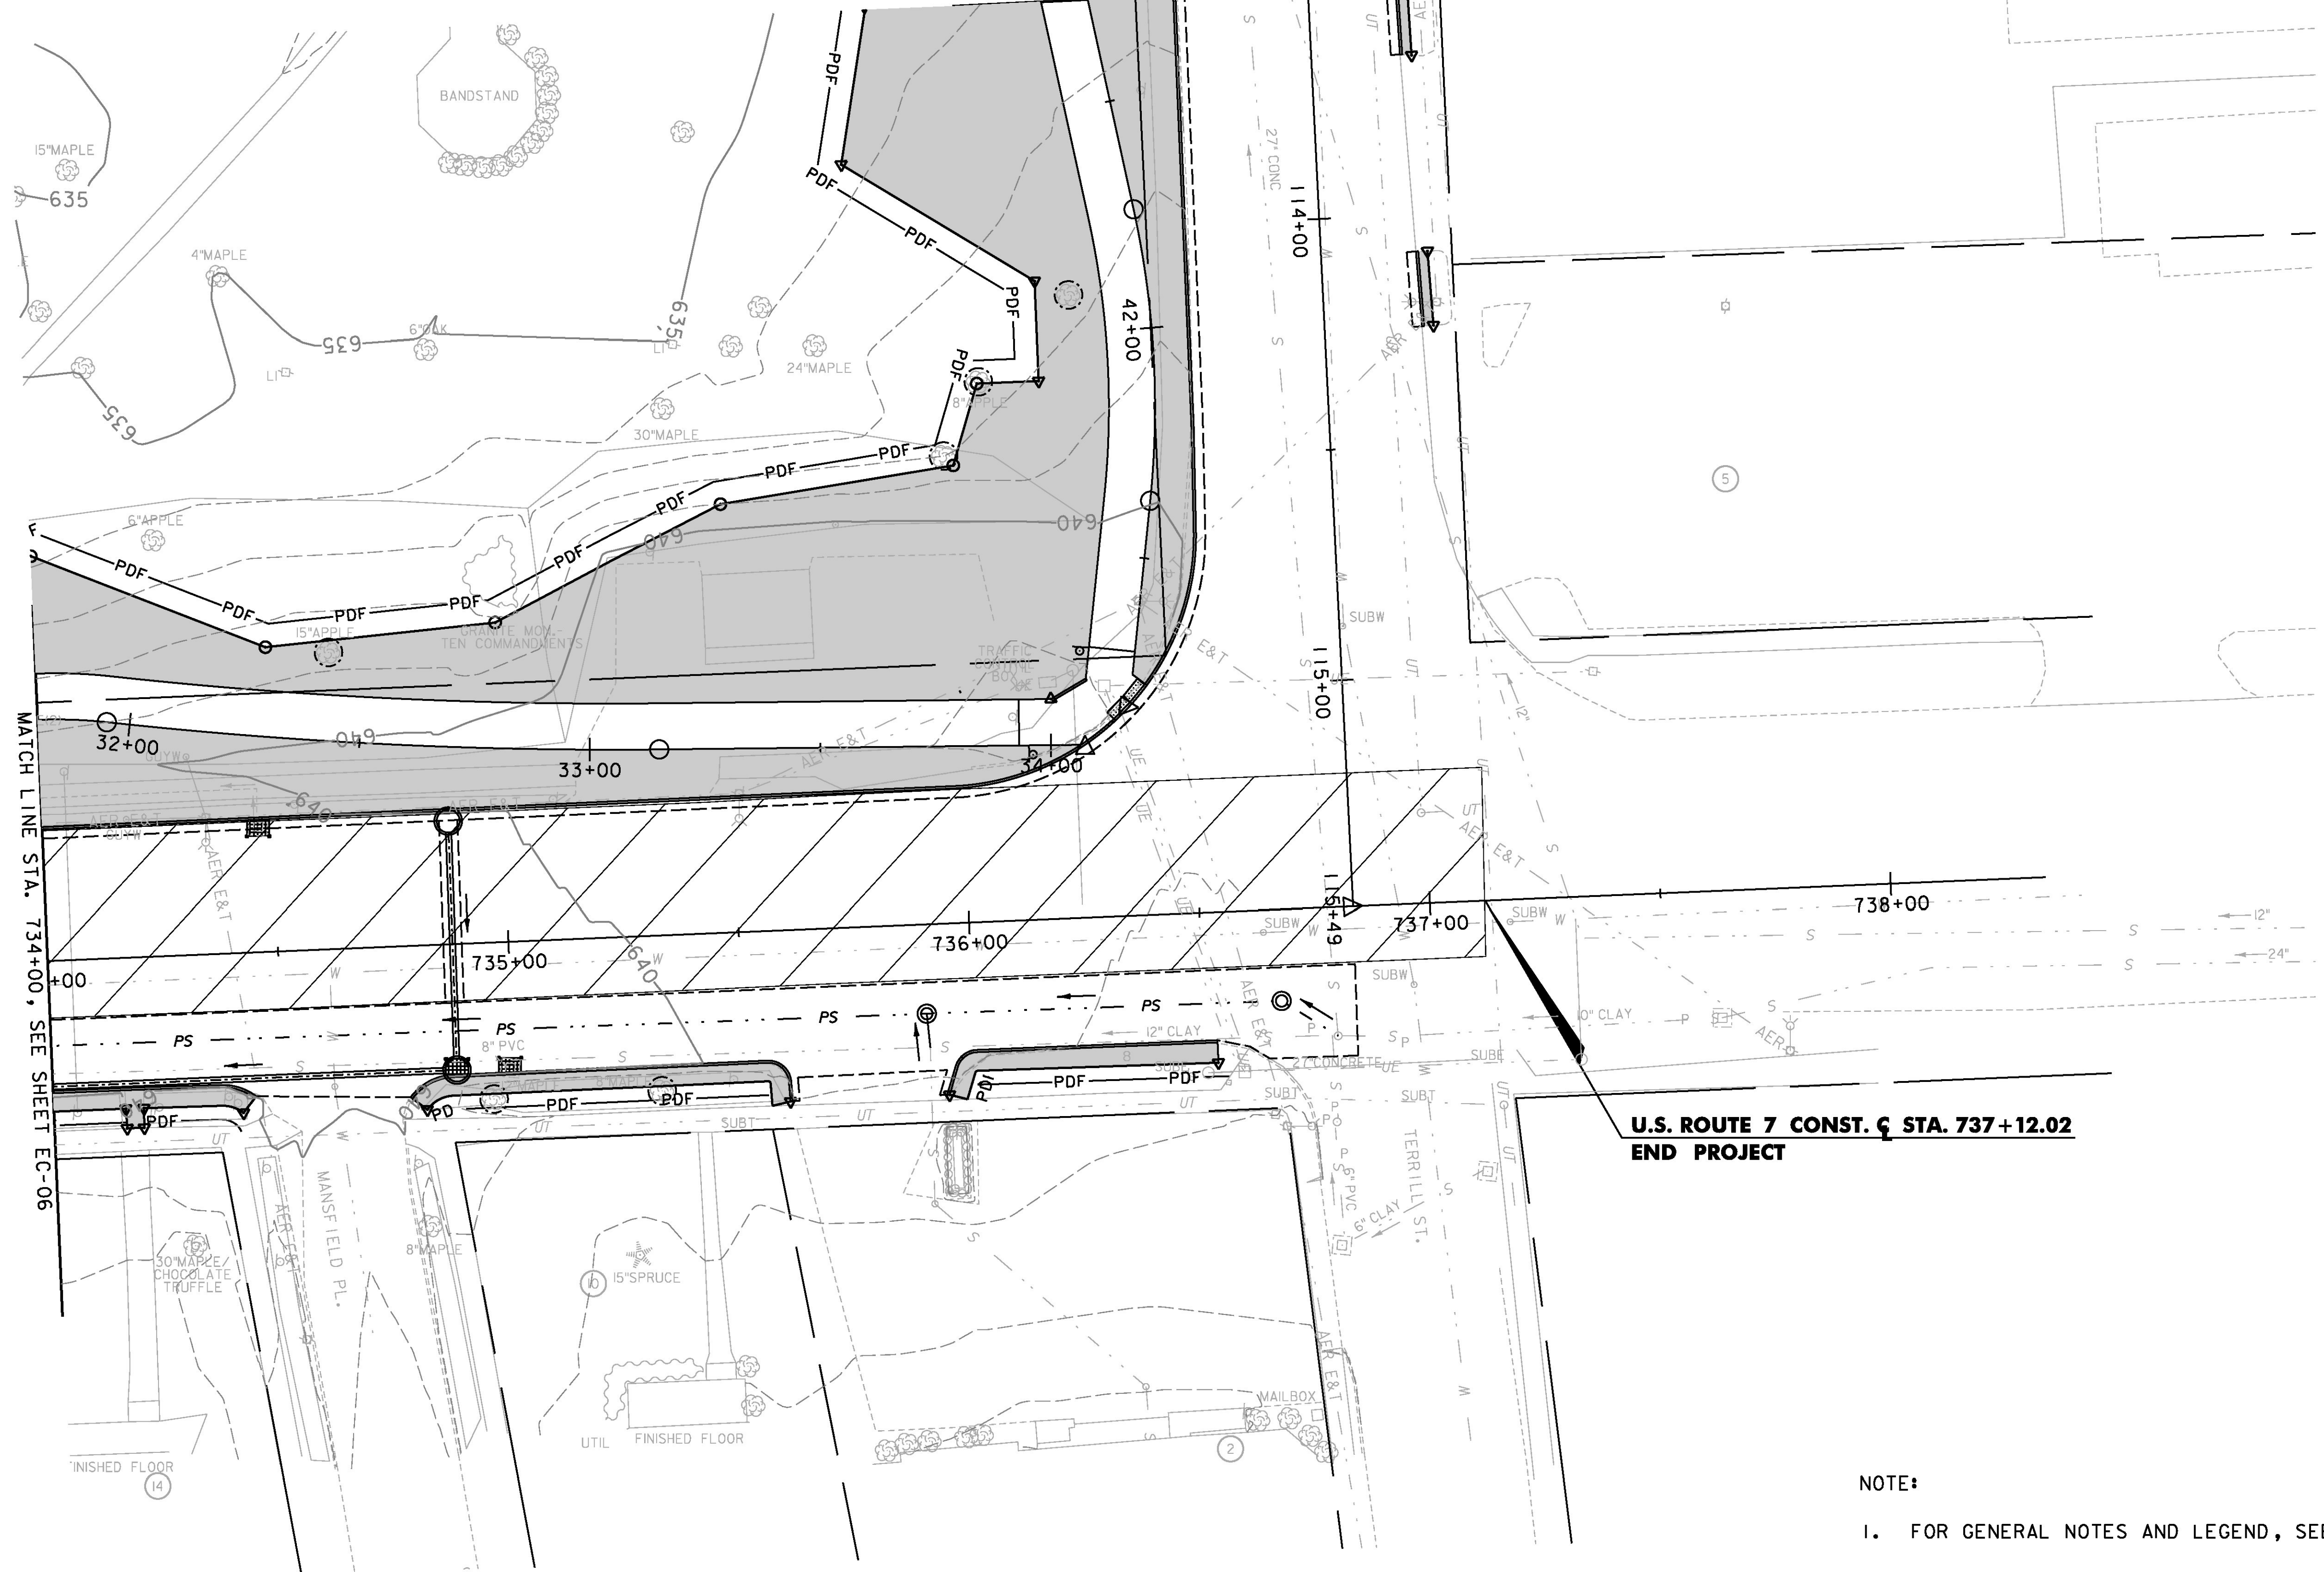

MATCH LINE STA. 734+00, SEE SHEET EC-06

**U.S. ROUTE 7 CONST. § STA. 737+12.02
END PROJECT**

NOTE:
I. FOR GENERAL NOTES AND LEGEND, SEE SHEET EC-01

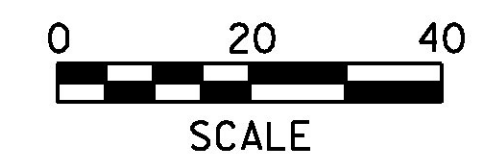

PROJECT NAME:	RUTLAND CITY
PROJECT NUMBER:	STP 019-3(57)
FILE NAME: ...\\rut_epsc_construction.dgn	PLOT DATE: 7/12/2013
PROJECT LEADER: GAE	DRAWN BY: PZA
DESIGNED BY: TFD	CHECKED BY: GAE
EPSC CONSTRUCTION SITE PLAN EC-07 SHEET 329 OF 392	