


**U.S. BR 4 CONST. C STA. 111+48.41  
LIMIT OF WORK**

**U.S. BR 4 CONST. C STA. 112+28.57, 32.01' RT  
END SHARED USE PATH**

MATCH LINE STA. 53+50, SEE SHEET EC-07

NOTE:

I. FOR GENERAL NOTES AND LEGEND, SEE SHEET EC-01

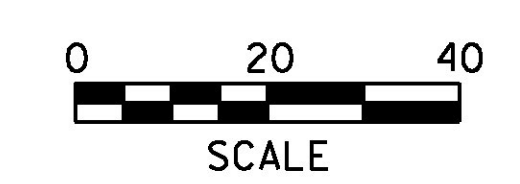

PROJECT NAME:	RUTLAND CITY
PROJECT NUMBER:	STP 019-3(57)
FILE NAME: ...rut_epsc_construction.dgn	PLOT DATE: 7/12/2013
PROJECT LEADER: GAE	DRAWN BY: PZA
DESIGNED BY: TFD	CHECKED BY: GAE
<b>EPSC CONSTRUCTION SITE PLAN EC-08 SHEET 330 OF 392</b>	