


MATCH LINE STA. 706+50, SEE SHEET EC-01

MATCH LINE STA. 712+00, SEE SHEET EC-03

NOTE:

- I. FOR NOTE AND LEGEND, SEE SHEET EF-01

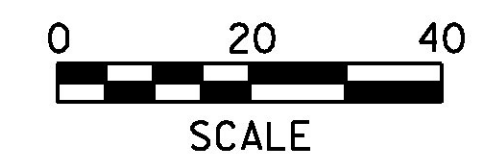

PROJECT NAME:	RUTLAND CITY
PROJECT NUMBER:	STP 019-3(57)
FILE NAME: ...rut_epsc_stabilization.dgn	PLOT DATE: 7/12/2013
PROJECT LEADER: GAE	DRAWN BY: PZA
DESIGNED BY: TFD	CHECKED BY: GAE
<b>EPSC FINAL STABILIZATION PLAN EF-02</b> SHEET 332 OF 392	