


MATCH LINE STA. 712+00, SEE SHEET EC-02

MATCH LINE STA. 717+50, SEE SHEET EC-04

NOTE:
 I. FOR NOTE AND LEGEND, SEE SHEET EF-01

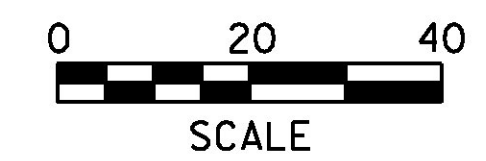

| | |
|--|----------------------|
| PROJECT NAME: | RUTLAND CITY |
| PROJECT NUMBER: | STP 019-3(57) |
| FILE NAME: ...rut_epsc_stabilization.dgn | PLOT DATE: 7/12/2013 |
| PROJECT LEADER: GAE | DRAWN BY: PZA |
| DESIGNED BY: TFD | CHECKED BY: GAE |
| EPSC FINAL STABILIZATION PLAN EF-03 | |
| SHEET 333 OF 392 | |