


MATCH LINE STA. 717+50, SEE SHEET EC-03

MATCH LINE STA. 723+00, SEE SHEET EC-05

**NOTE:**

- 1. FOR NOTE AND LEGEND, SEE SHEET EF-01

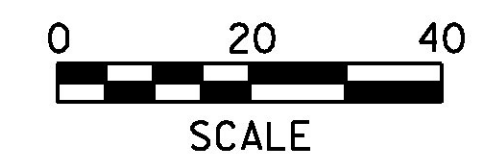

PROJECT NAME:	RUTLAND CITY
PROJECT NUMBER:	STP 019-3(57)
FILE NAME: ...\\rut_epsc_stabilization.dgn	PLOT DATE: 7/12/2013
PROJECT LEADER: GAE	DRAWN BY: PZA
DESIGNED BY: TFD	CHECKED BY: GAE
<b>EPSC FINAL STABILIZATION PLAN EF-04</b> SHEET 334 OF 392	