


MATCH LINE STA. 53+50, SEE SHEET EC-07

NOTE:
 I. FOR NOTE AND LEGEND, SEE SHEET EF-01

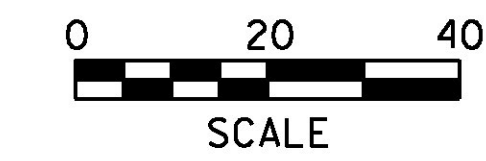

PROJECT NAME:	RUTLAND CITY
PROJECT NUMBER:	STP 019-3(57)
FILE NAME: ...rut_epsc_stabilization.dgn	PLOT DATE: 7/12/2013
PROJECT LEADER: GAE	DRAWN BY: PZA
DESIGNED BY: TFD	CHECKED BY: GAE
EPSC FINAL STABILIZATION PLAN EF-08	
SHEET 338 OF 392	