


MATCH LINE STA. 712+00, SEE SHEET SPT-02

MATCH LINE STA. 717+50, SEE SHEET SPT-04

NOTE:

- I. FOR NOTES AND LEGEND, SEE SHEET SM-01

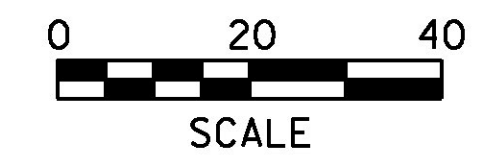

PROJECT NAME:	RUTLAND CITY
PROJECT NUMBER:	STP 019-3(57)
FILE NAME: ...\\PlotFiles\rut_s+pvtplan.dgn	PLOT DATE: 7/12/2013
PROJECT LEADER: GAE	DRAWN BY: PZA
DESIGNED BY: TFD	CHECKED BY: GAE
SIGNING & MARKING PLAN SM-03	
SHEET	345 OF 392