

718+40 LT
718+48 LT
719+03 LT

MOUNT ON PED
POLE, ORIENT
APPROPRIATELY

718+38 LT

719+06 LT


721+46 LT

721+84 LT

MATCH LINE STA. 717+50, SEE SHEET SPT-03

MATCH LINE STA. 723+00, SEE SHEET SPT-05

NOTE:
1. FOR NOTES AND LEGEND, SEE SHEET SM-01

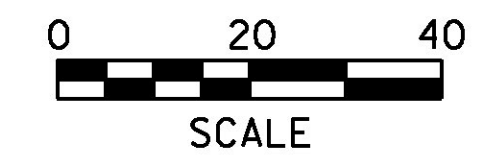

PROJECT NAME:	RUTLAND CITY
PROJECT NUMBER:	STP 019-3(57)
FILE NAME: ...\PlotFiles\rut_s+pvtplan.dgn	PLOT DATE: 7/12/2013
PROJECT LEADER: GAE	DRAWN BY: PZA
DESIGNED BY: TFD	CHECKED BY: GAE
SIGNING & MARKING PLAN SM-04	
SHEET	346 OF 392