
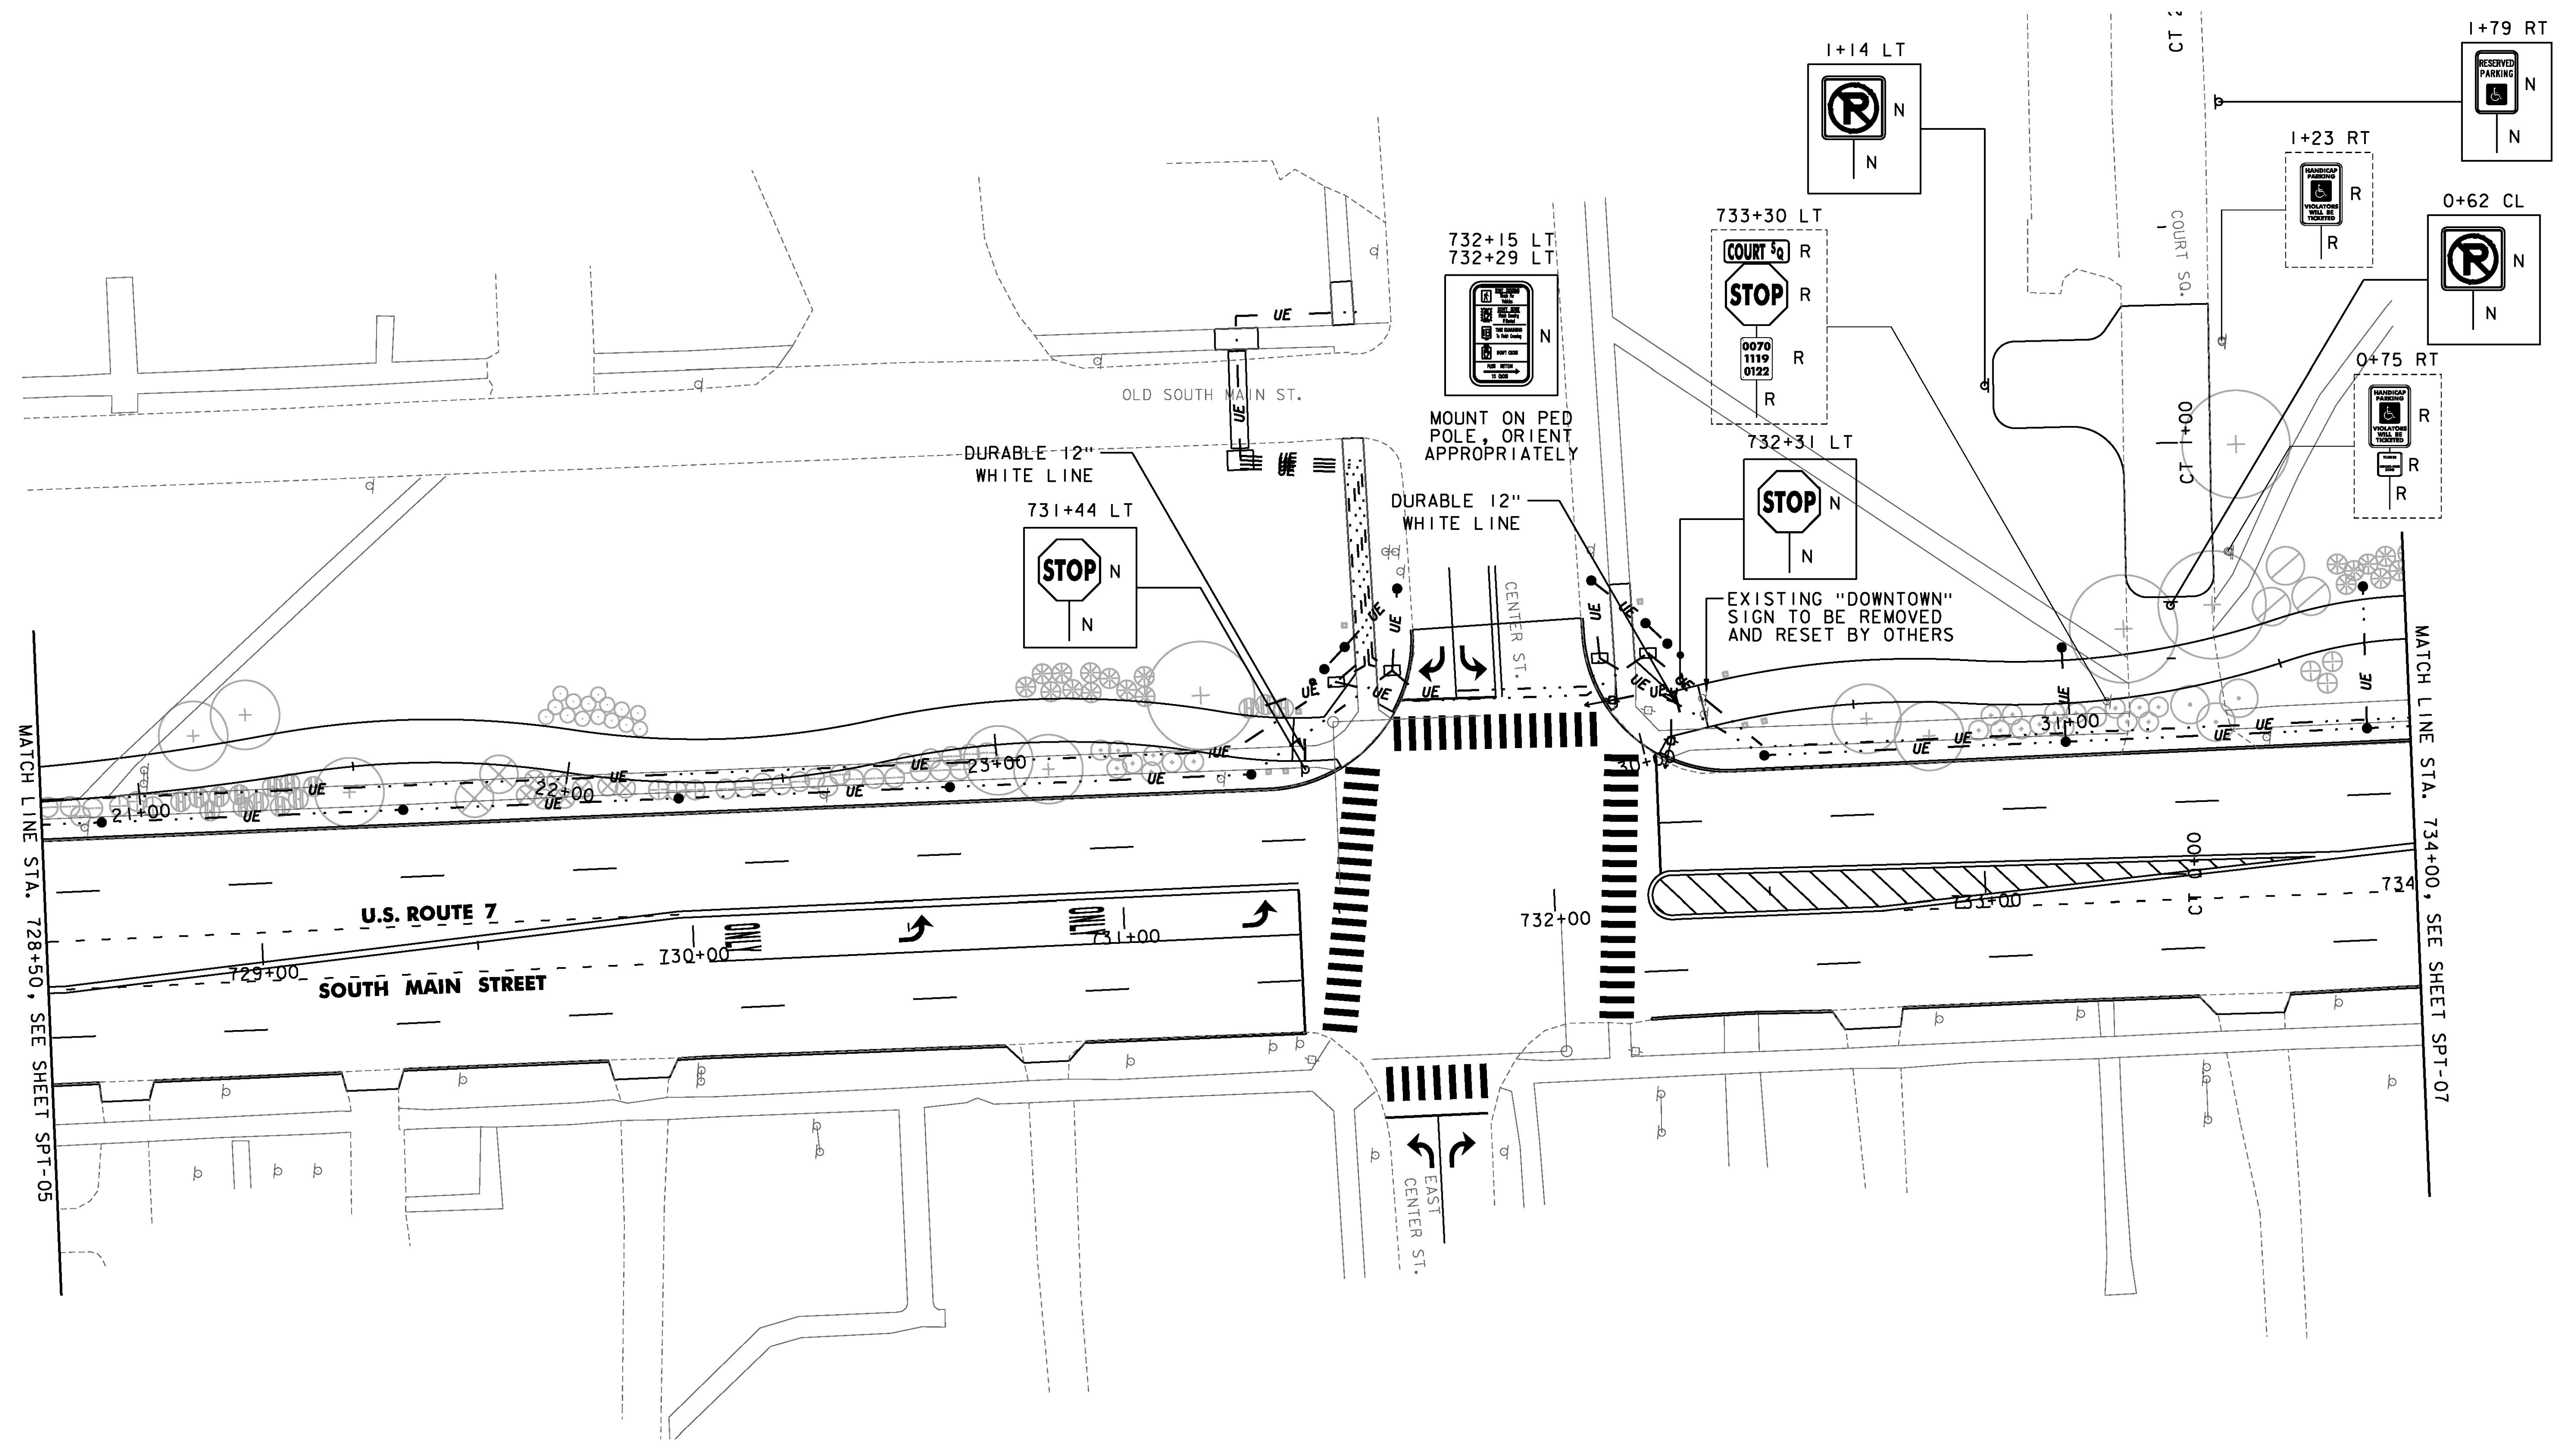


REMOVING SIGNS
AS SHOWN - 6 EACH

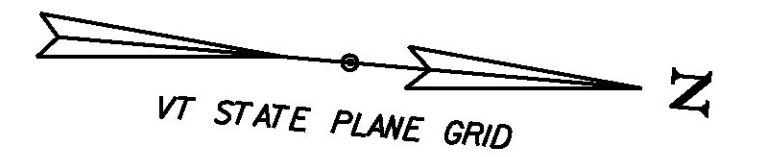

MATCH LINE STA. 728+50, SEE SHEET SPT-05

MATCH LINE STA. 734+00, SEE SHEET SPT-07

NOTE:
1. FOR NOTES AND LEGEND, SEE SHEET SM-01

PROJECT NAME:	RUTLAND CITY
PROJECT NUMBER:	STP 019-3(57)
FILE NAME: ...\\PlotFiles\\rut_s+pvtplan.dgn	PLOT DATE: 7/12/2013
PROJECT LEADER: GAE	DRAWN BY: PZA
DESIGNED BY: TFD	CHECKED BY: GAE
SIGNING & MARKING PLAN SM-06	
SHEET 348 OF 392	

